


No Distans Measured.

Leaf Surrey
M^e Arthur Twp.


- C - stone found W. side steel & wood post
- B - Old fence posts
- A. Stone Planted
- C to B Wire fence Fair shape
- B to A Barb wire tree to tree
Crooked line

Dug for stone at A No Luck
Mr Will Anstine says this stone
quite deep when found about 30
years ago. At that time
a straight line was
established C to A by
sighting on tall poles.
Produced CB to A. set
stone and tile at A.

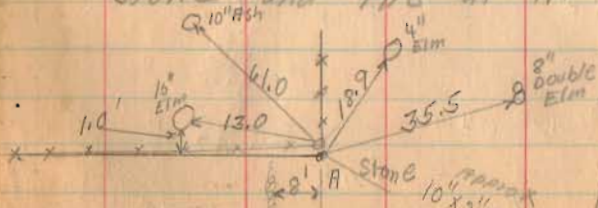

Detail of A

Mr Anstine says this tile set
West on account of road or line used at one time

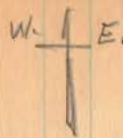

Aug. 14 - 1939 16

Nice day

F. Wright

J. Montgomery

Will Anstine

W^m Leaf

Road. 37

OWN DOWNEY
47159

Peoples
48.79

Mamie E. Leaf
180.78

V.M.S. 10307

(Deed dist C to A 2215.95)

R. H.
Schlumbohm

see 56.04
Detail

Road. 39

Dry Pond

Harrod Cemetery

Road. 56

Harrod Cemetery

1600

INDEXED ON MAP