

Road 95

50' - Commissioners Journal No. 10 Page 95
 1851
 50' sta. 0+00 To 66+40

25+00

19+00

13+90


8+00

1+00

For New Posts.
 25' from

1739

REVISED ON MAP

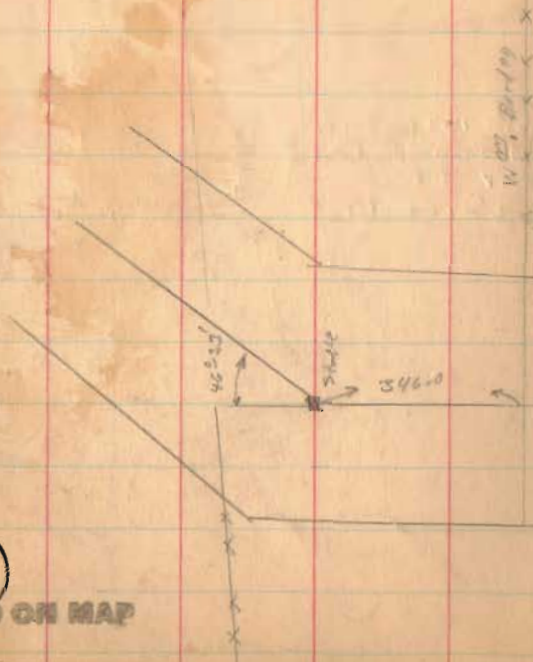

Aug-17-1936

Clear

F. W. May

G. Wilcox

J. M. Dwyer

Max James

Joe Roberts

Frank
 McLean
 24 1/2
 24 1/2
 No Fence

19.5
 25+00

WOODS

Francis McLean
 23.5
 19+00

18+99

W. Borden
 24
 24
 24
 No Fence

42.4
 15+90

13+52

V.M.S.
 9902

8798

18.0
 6+00

V.M.S. 12168

Frank
 McLean

17.00

Road 37
 200 Book 577
 Page 6

90°-16'

68.4

Iron

Road 37

12' walnut V.M.S. 10122
 10248
 10249

15' walnut

15' walnut

24' oak

Frank
 McLean

129.1

113.4

129.1

113.4

427.06

Road 95

51+00

$$\begin{array}{r} 66+00 \\ 36+00 \\ \hline 31+92 \end{array}$$

46+00

40+00

34+60


30+00

1737

INDEXED ON MAP

8-19-36

83

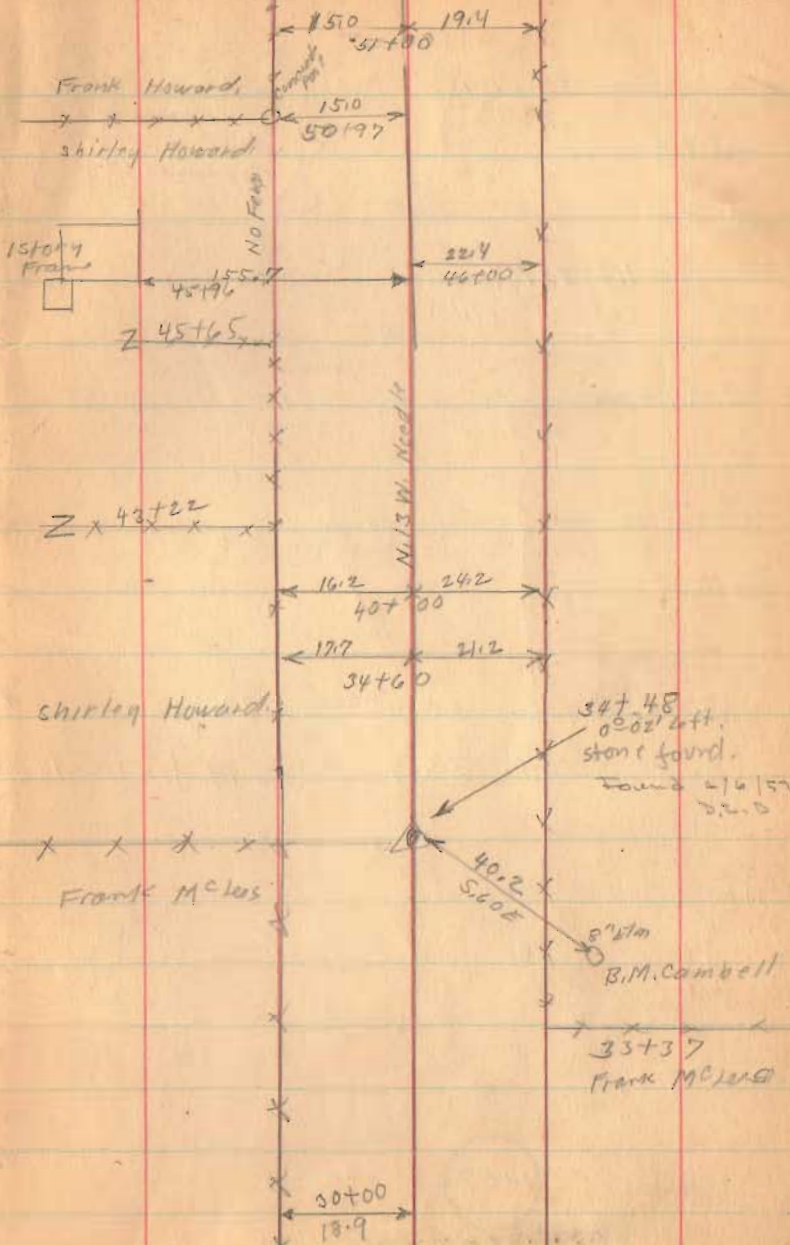

Road 95

See Page 74
for levels
Road 6 North
to sta. 15+22

Length 6640 Feet

Length 1.2575757 Miles

Length 1.26 Miles

33' - Road Record 2 Page 549-550-558-565
Map Page 562

Staked 25' from ϕ for sd Road
Trustees to get Additional land.

65+50

(See Book 339 Page 22 for levels)

(See Book 339 Page 19 for levels)


61+00

56+00

1757

INDEXED ON MAP

17052

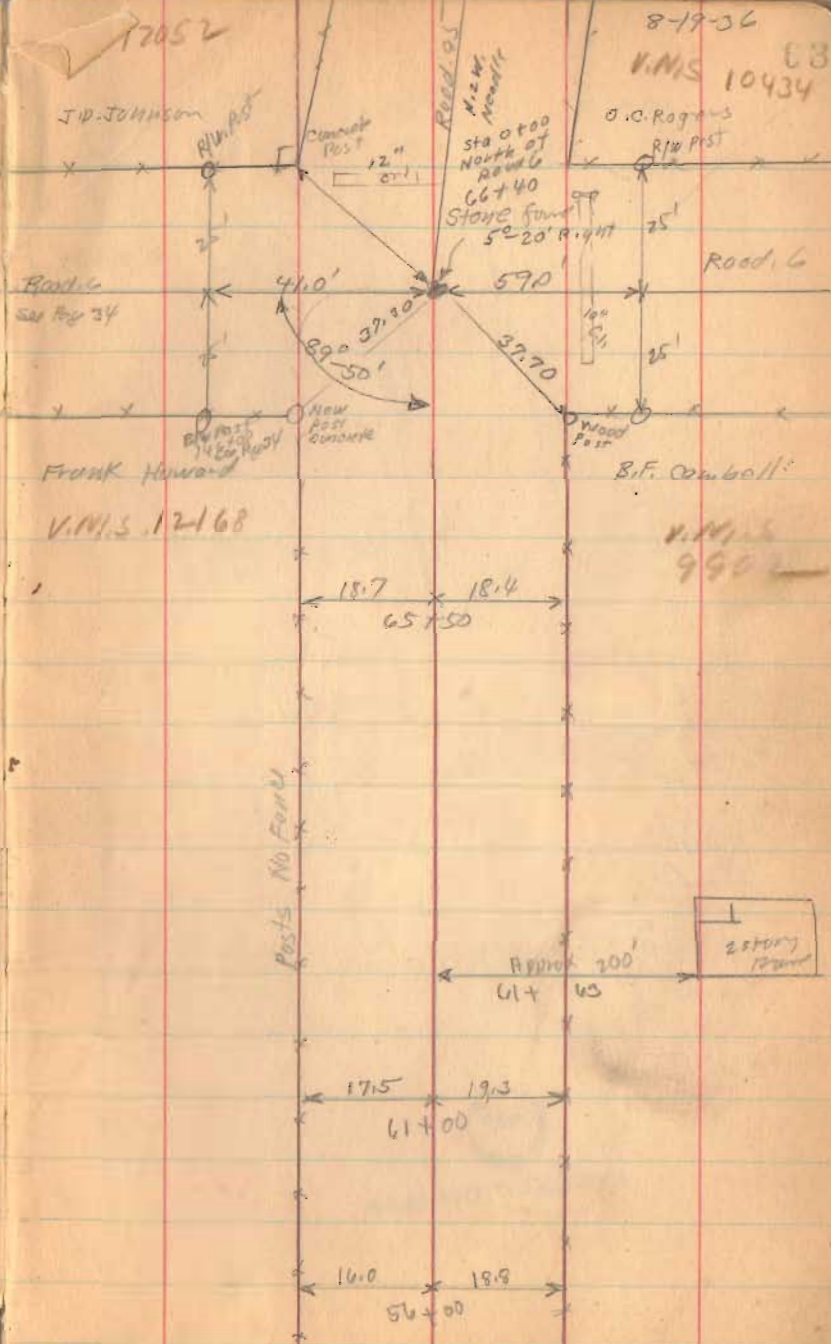

Road. 95

23+00

16+93

10+00 right only


6+00 right only

1+00 right only

Set.
F.W. Light Sat.
Dec. 17-1936
G. Pussey
G. Wilgus

1737

INDEXED ON MAP

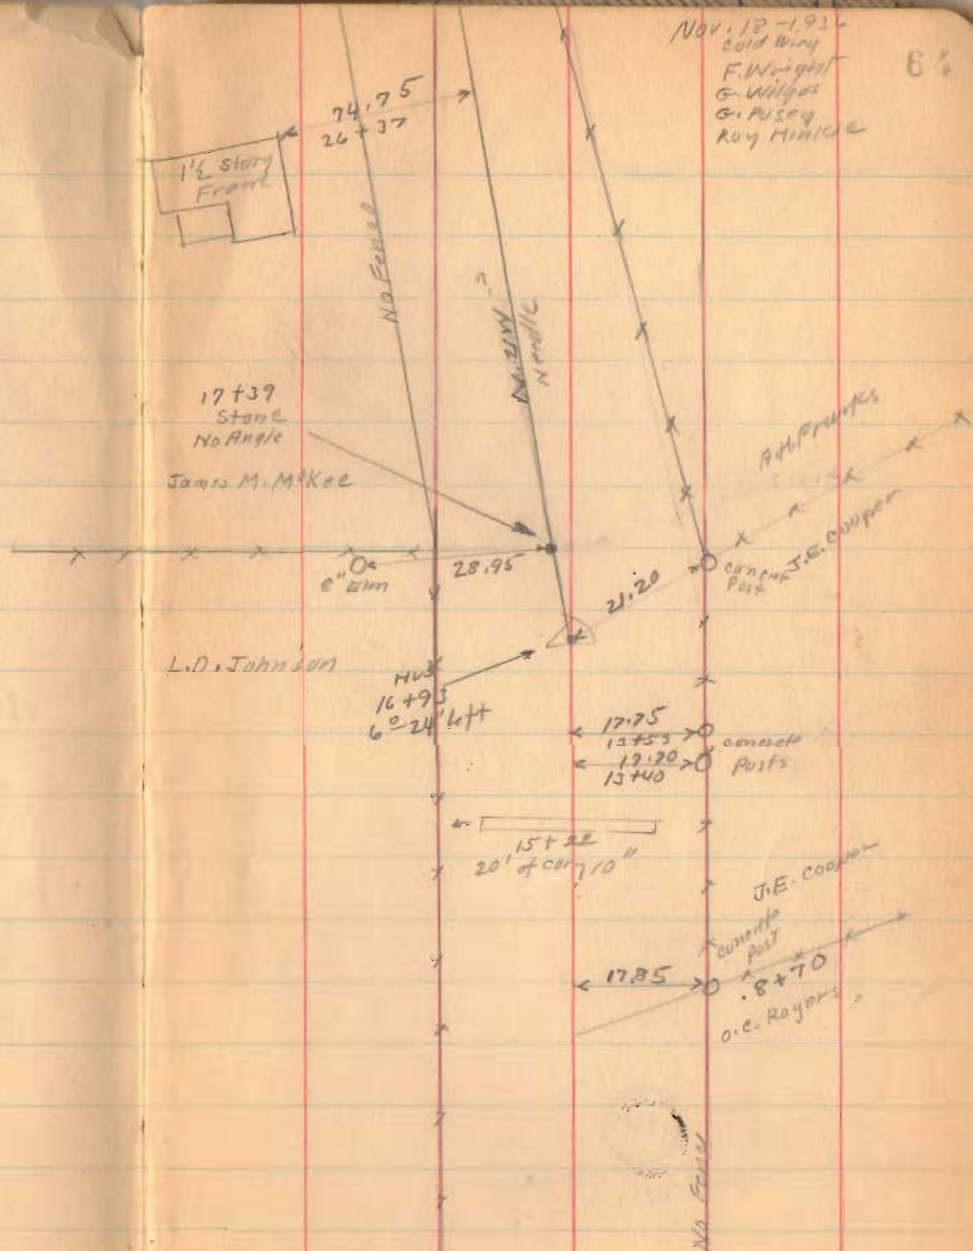

Road. 95

11-18-36

85



41+00

37+00

29+00

1737

INDEXED ON MAP

Road 95

11-18-36

EG

Stone
57+27

Jump Nail

56+85

4'25"

56+11

12'52"

Engelhaupt
Survey

9-13-62 0.96 ac. 121023'

D. Dodson

G. Geeslin

□ = 1/4" bar set

200.0

267.8

119.2'

18.15

CONF. ST.
POST

K. T. TROTT

A.C. 19° CLIFF

15' HIGH

30.20

56+58.30

56+85

G. B. L. S. R. P. (100)

58° 33'

56+11

150.0
IRON BAR FOUND
10/11/65
R.C.B.

3516

INDEXED ON MAP

N. 7 1/2° W.

1031.40

46+00

1 1/2 story

Front

55+00

47+00

1787

INDEXED ON MAP

See Book 625 Pages 57-62 for 1-cm's
See Book 625 Pages 63-75 for 1-sec.

Road 95

64+71 Twp Line Posts

63+00


59+00

1737

INDEXED ON MAP

11-18-36

67

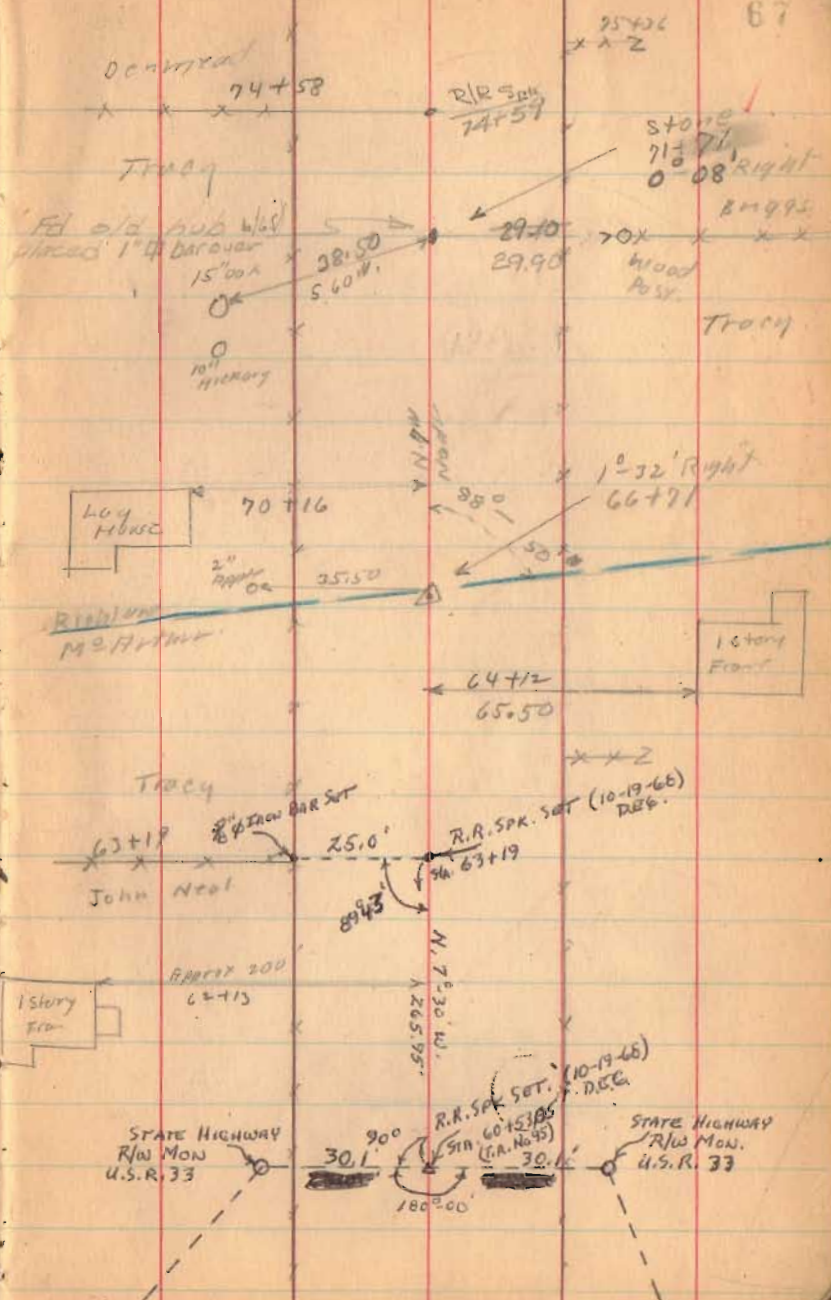


Road 95

4737
INDEXED ON MAP

11-1P-35


88

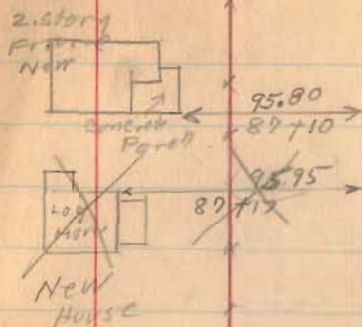

184292

R/R Spike
Sta. 20+18.8
NO ANGLE

CHICKEN

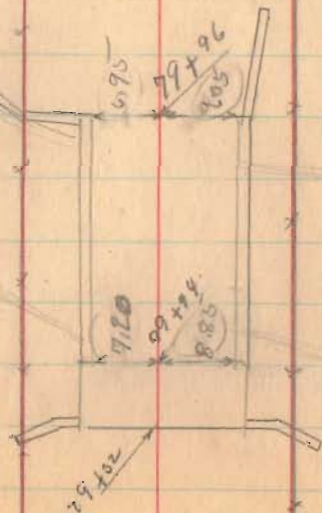

Road 95

Length 10039 Feet.

Length 1.9013264 Miles

Length 1.90 Miles

Road 37 TO ROAD 6 = 1.26 Miles

" 6 TO S.H. 168 = 1.90 "

Total 3.16 "

Richland Tap

Sta. 60+71 TO 100+39 = 3368 Feet

= 0.637878 Miles

0.64

1737

INDEXED ON MAP

Steel post
I beam

Wood
fence

O. B. A.
Frank
Leider

Dick Beard

Surveyed 1-7-56

Don & Dodson

INDEXED ON MAP

267.7'

17.75'

267.7'

Bolt
Found

96+95.6

95+85.6

Hook
tooth

Set

FD. 2/7/70
DEC.

FD. 2/7/70
DEC.

11-18-36

89

517+00
517+00
BM. 1002.79

Sta. 302+00
R/W Post #1
#197

N. E. 1/4

30'

30'

(R.K. Filling
Station)

100+39

R.K. Nail
Set
(2/7/70)
DEC.

74.55'

89-03-20
(1936 & 1937)
(2-7-30) DEC.

Acres: 2/7/70
11-7-50 W.
2/24'

R.K. Nail
Set
(2/7/70)
DEC.

Nail
Found

17.00'

Nail
Found

17.00'

Bolt
Found

96+95.6

95+85.6

Hook
tooth

Set

FD. 2/7/70
DEC.

FD. 2/7/70
DEC.

Sta. 505+00
R/W Post
#1
#197

N. E. 1/4

30'

30'

S.H. 168

R/W 32'

30'

30'

M = 1009.29 - R/W
S.H. 168

