

Steinmetz Survey  
 V.M.S. 12168  
 Mc Arthur Township

A = Stone & Iron found, Iron 02 north  
 & 0.4' east of stone, used Stone  
 Sta. 34+48, FB# 574, pg 62

B = 6" wood Cor. post, used N. side


C = 3/4" pipe set, Fence ok here

D = R.R. spk. set

E = End post. - angle in fence

F = large  $\phi$  Cor. post

Used B-F for line

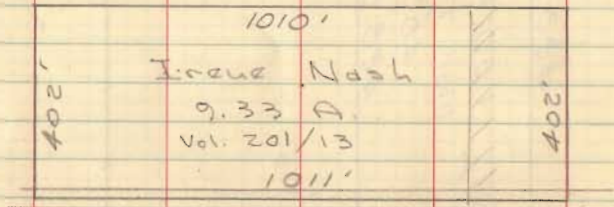

INDEXED ON MAP  
 2070

March 14, 1959  
 Dodson - Goeslin

March, 57  
 Dodson - Goeslin

