


Geeslin
Whitlow
Coverstone
Watt

Logan
274
Brdg. 89

10-Oct. 60

Logan Co. Records

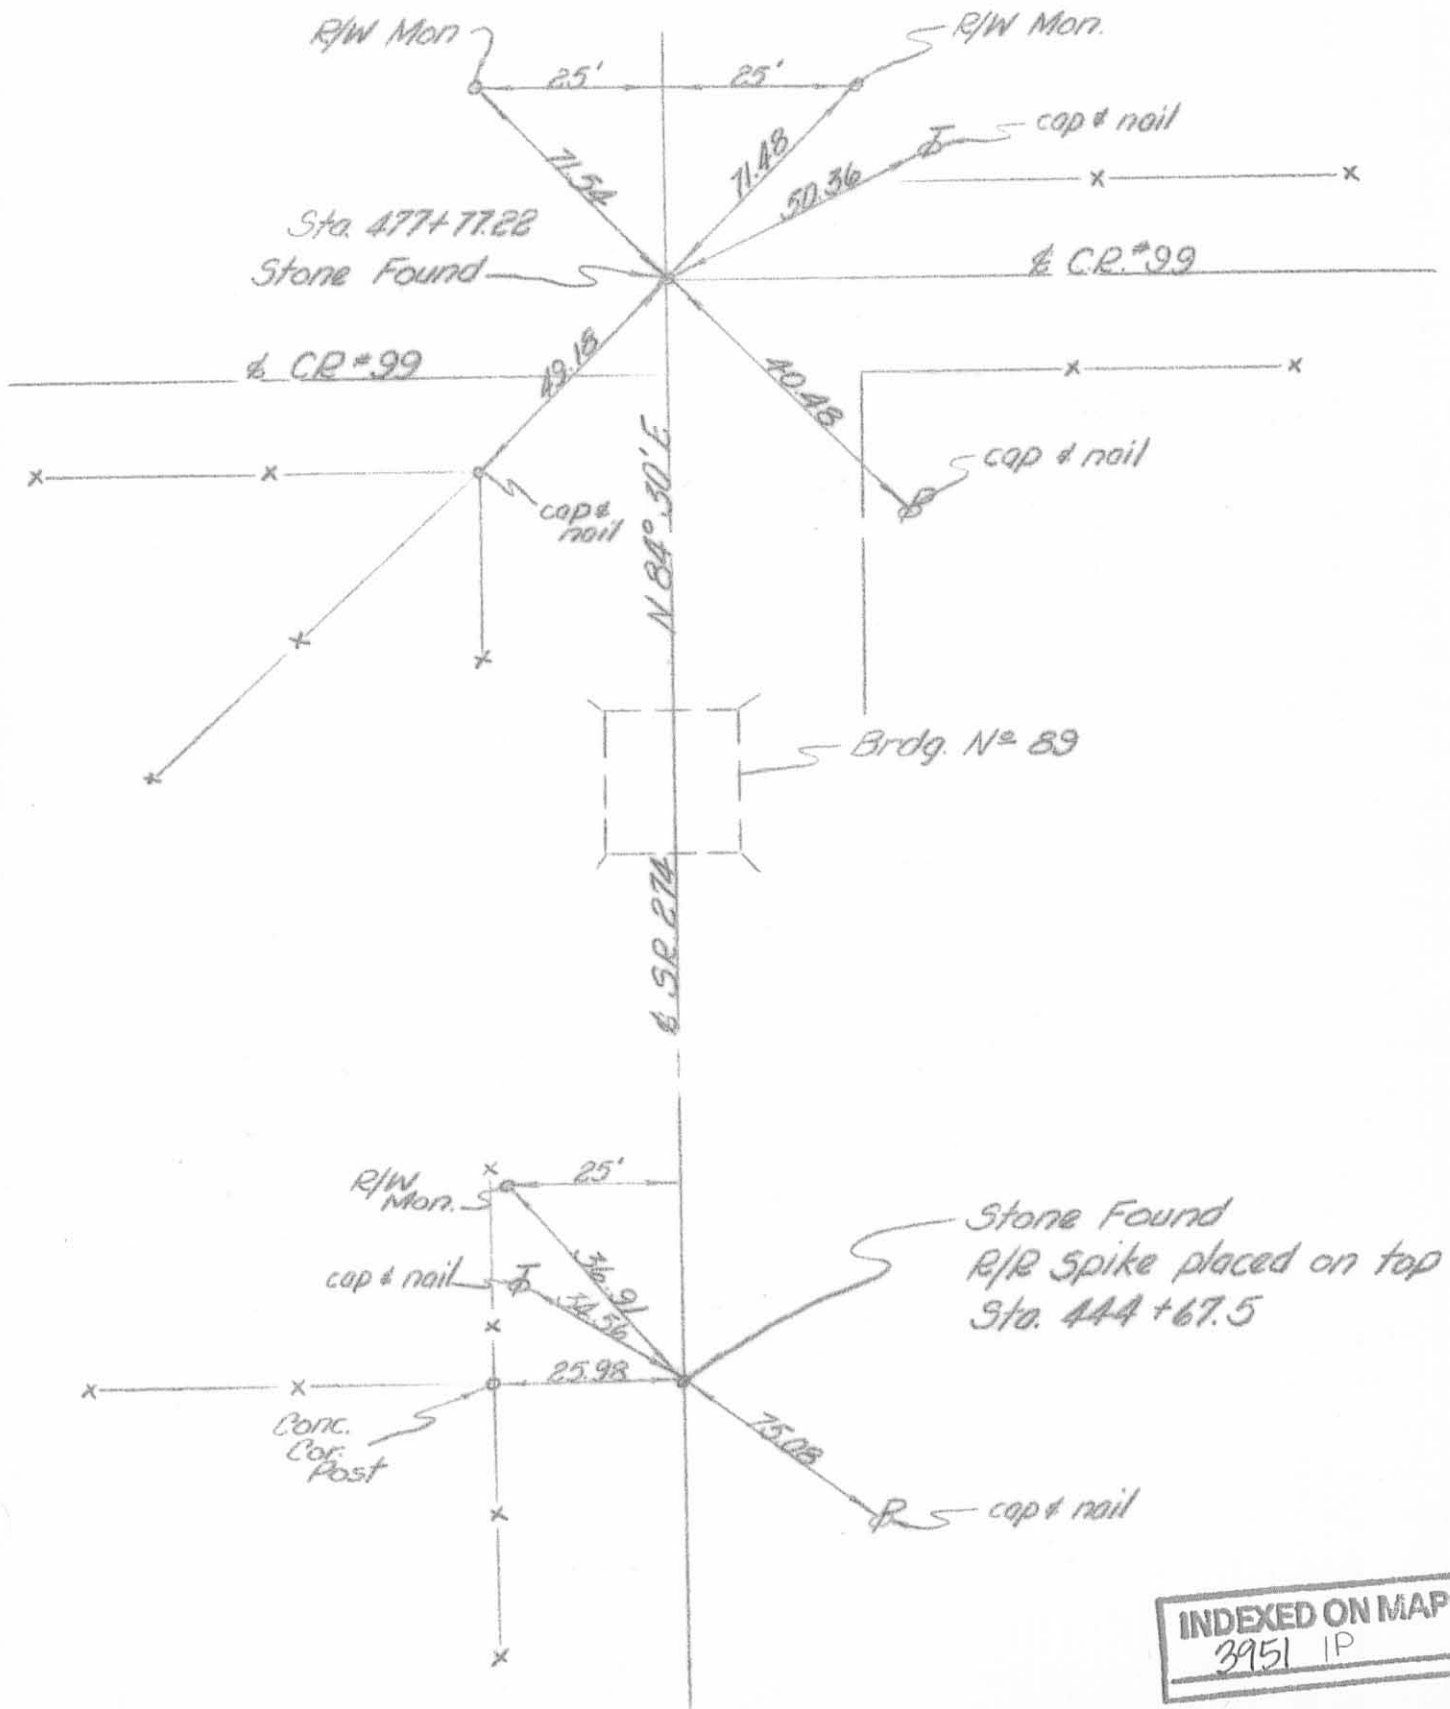

Stone Found
R/R spike placed on top
Sta. 444 + 67.5

INDEXED ON MAP
3951 IP

