

Graeslin \odot
 Whitlow π
 Coverstone d
 Watt ϕ


Logan

2 Sept 60

33

County Records

Leland Phillips 2.02 A. - Mc. Arthur Twp.

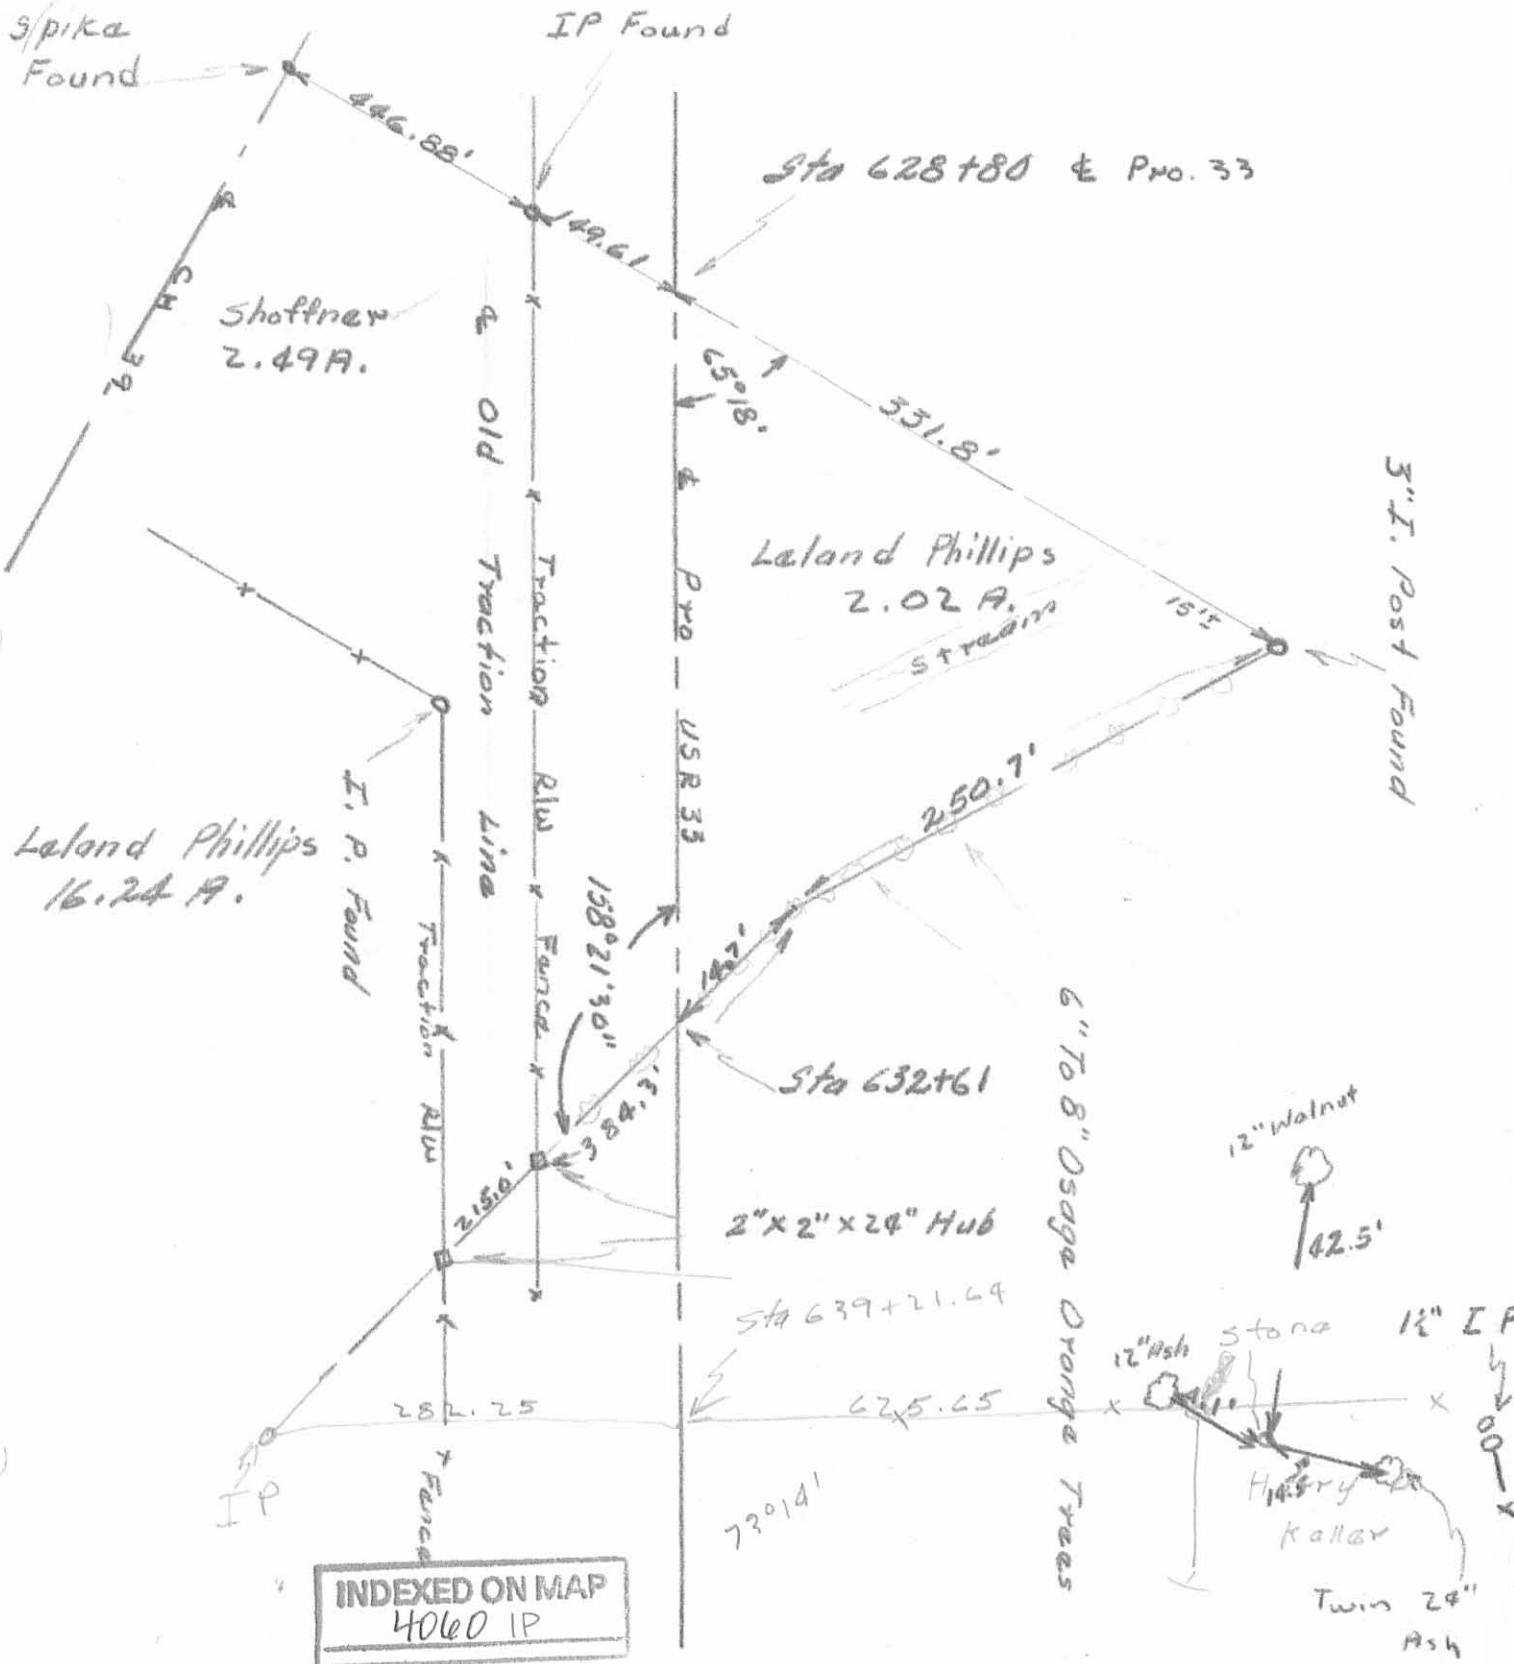


L. G.
J. W.
T. C.
G. W.

Logan
33
Hunt. - Belle.

29 Aug 60

Prop. Survey

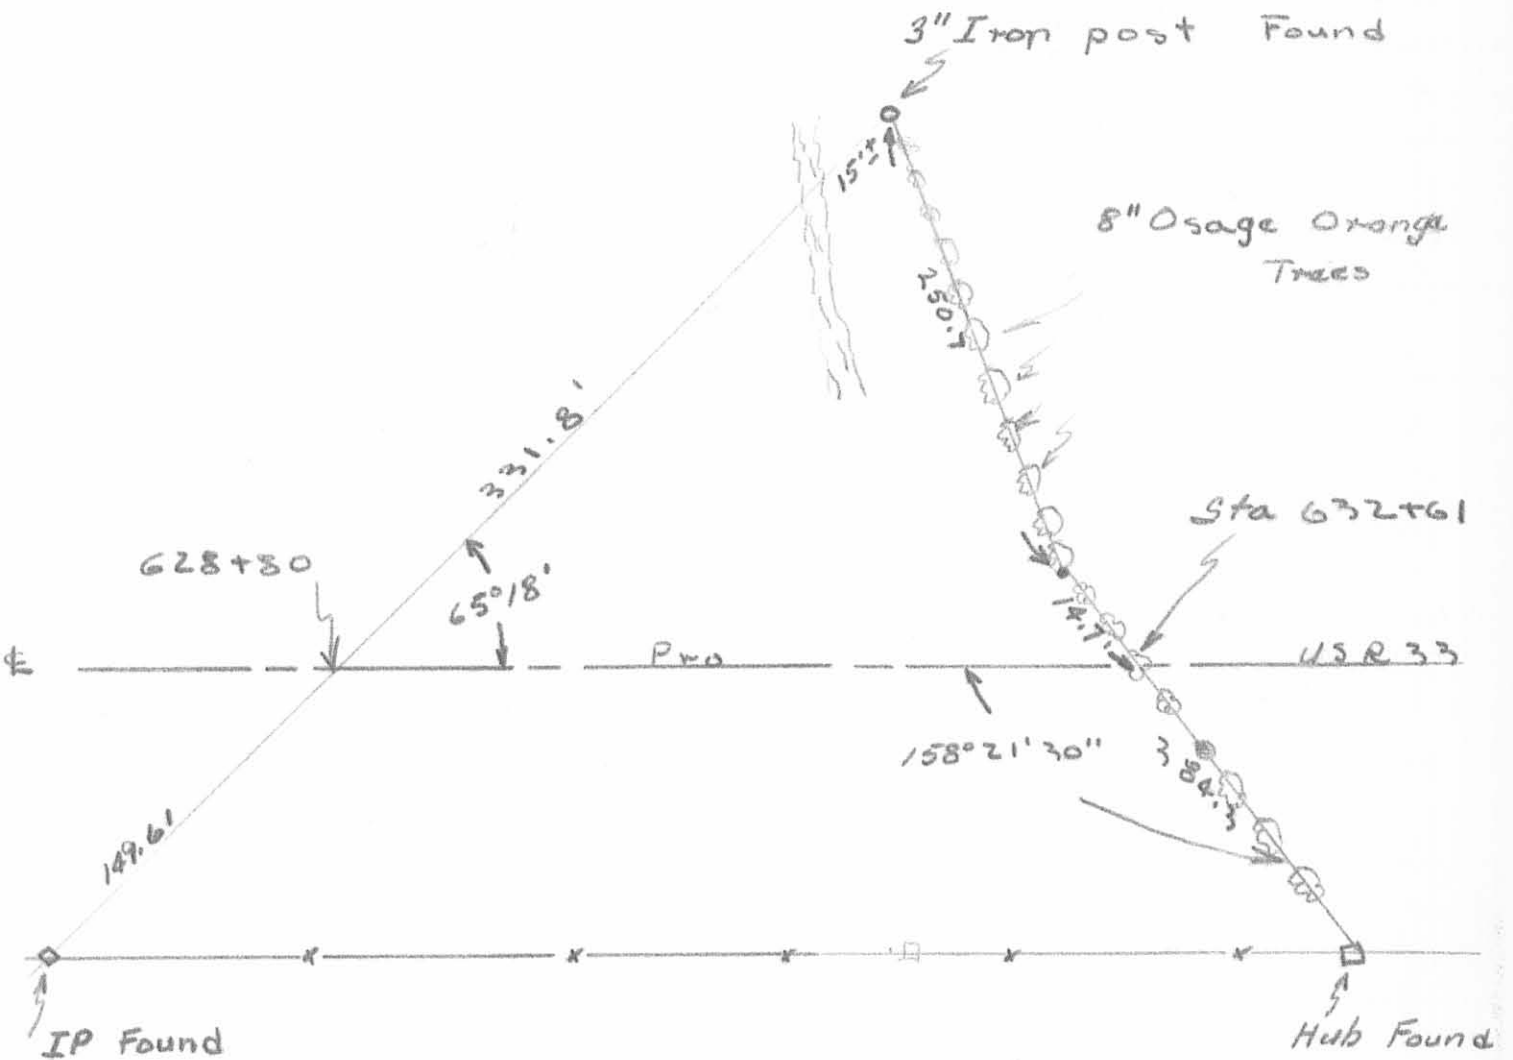

INDEXED ON MAP
4060 2P