

Henry

McCORMICK SURVEY

June 5, 1971

The following described real estate situated in Virginia Military Survey 9929, **McArthur** Township, Logan County, Ohio and being more particularly described as follows:

Commencing at an iron bar in the centerline of County Road 39, said iron bar being Station 50+00 as shown on Page 13 of Field Book No. 579; thence with said centerline S. 0°55' W. 91.35 feet to an iron bar, said iron bar being the beginning point for this description; thence with said centerline S. 0°55' W. 35.4 feet to an iron bar at the northeast corner of Leonard E. Henry's 0.97 acre tract; thence with said Henry's north line S. 82°19' W. 270.2 feet to a point at the northwest corner of said Henry's 0.97 acre tract; thence with said Henry's west line S. 7°41' E. 165.0 feet to the northeast corner of Charles E. Snapp's 2.52 acre tract; thence with said Snapp's north line S. 82°19' W. 525.8 feet to a corner post at said Snapp's northwest corner; thence N. 7°41' W. 200.0 feet to an iron bar; thence N. 82°19' E. 801.2 feet to the place of beginning.

Containing 2.63 acres more or less.


The above described 2.63 acres being on the east side of Grant McCormick's 98.93 acre tract.

INDEXED ON MAP

4833

ID



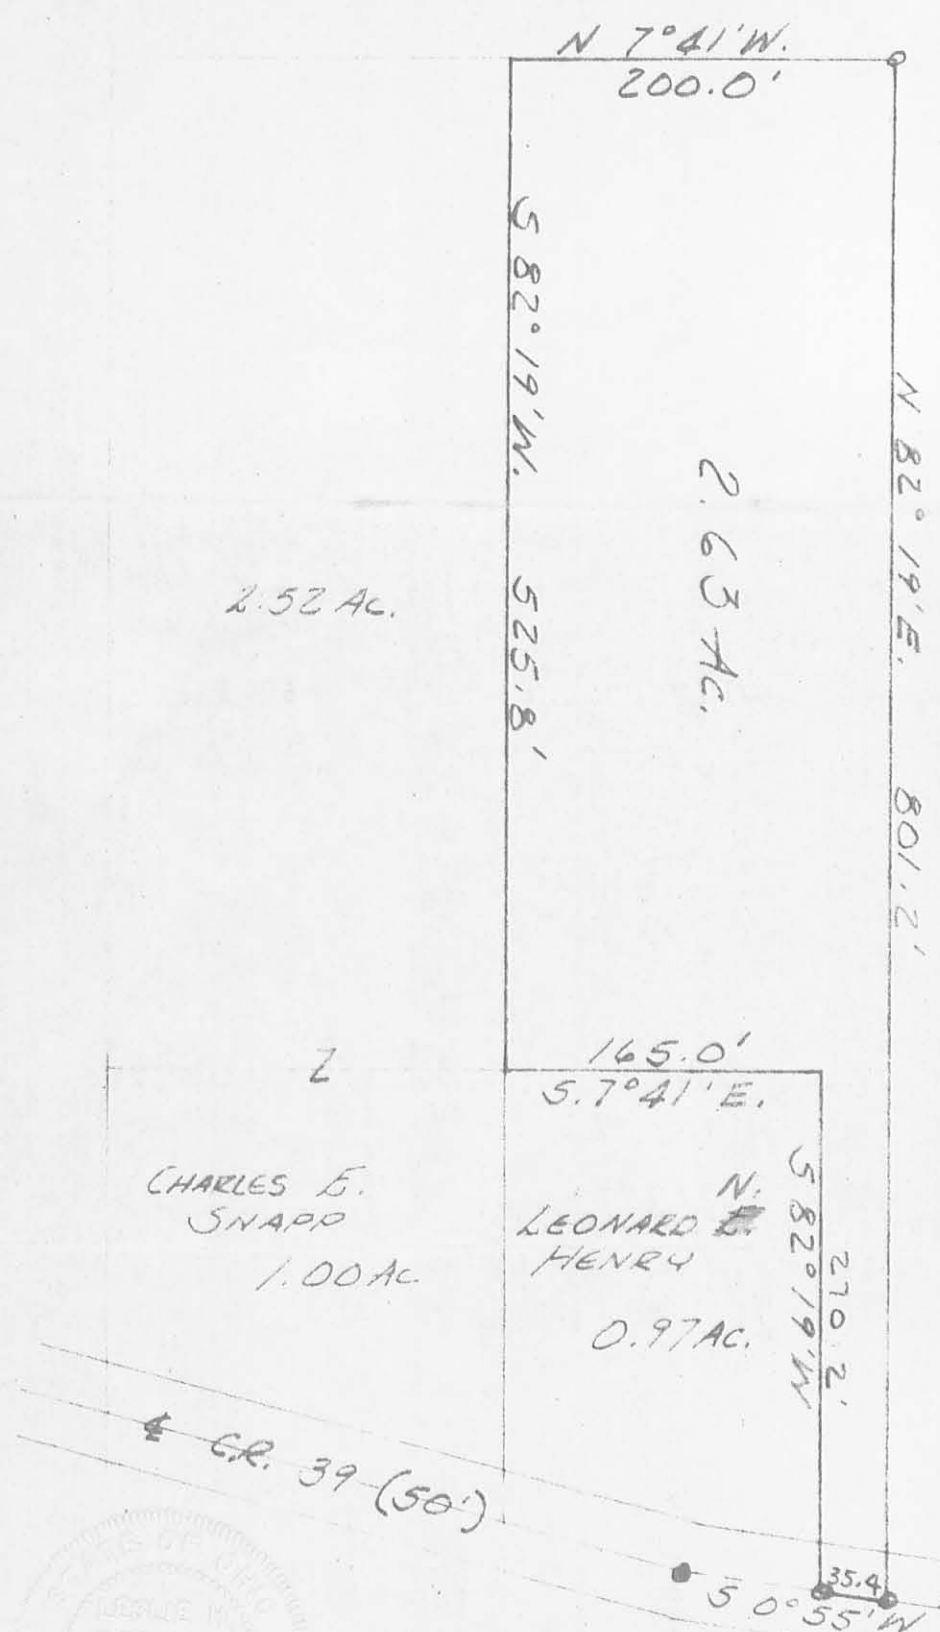

Mc CORMICK SURVEY
 JUNE 5, 1971
 V.M.S. 9929
 Mc ARTHUR TOWNSHIP
 LOGAN COUNTY, OHIO

SCALE 1" = 100'
 O = IRON BAR
 O = IRON PIPE

REF. F.B. 579



LESLIE H. GEESLIN
 REG. SURVEYOR 5248

INDEXED ON MAP

4833
 IP