

270

May 1837

N^o 379

W. Corner of the Section

R. Oak 15th 20th 14th
W. Oak 16th 530th 37th

A Stone & E Corner to H. W. White

This plat represents the survey and subdivision of the NW 1/4 of Sec. 8, T. 3. R. 13. N. R. 2. made for S. A. New say. May 10. 1837.

San Hopkins Co. Sur. S. C.

8411

W. Oak 20th 6th 11th
W. Oak 16th 530th 37th

A. 46th 100
Midway down stream
of T. A. New

S. A. New to Reed
84th 100 acres.

W. Oak 16th 530th 37th
W. Oak 16th 530th 37th

8696

States.

Miss. River

N^o 380


8412

Surveyed May 26. 1837 for Joseph Wallaw part of Military Survey N^o 9903 as follows. Beginning in the Westward line of said Survey at a W. Oak log wood & Elm on a hill side, thence S 45th E 40th pole to a Bur Oak with bend of a creek thence S 50th E 18th pole, to a Red Oak, thence S 75th E 30th pole crossing the bend of a Creek at 20th pole to a large White Oak thence S 14th E 152th 50th pole crossing a Creek at 20th pole to a Stake on the South side of a Mill Race, thence on the South and West side of said Race N 65th W 34th pole to a Stake, thence N 25th W 18th pole to a stake, thence N 80th W 48th pole to White Oak in the Westward line of the Survey, thence N 11th W to the beginning containing

San Hopkins Co. Sur. S. C.

N^o 380

8413

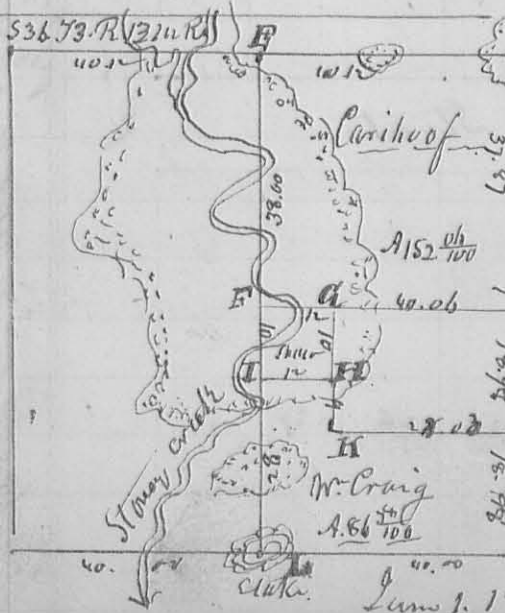

Stake D. Corner, a true Meridian with 40th E variation - Description of Corner -
A. W. Oak 12th South 26th links the other down
B Stone & White Oak 30th N 32 E 24 links
C W. Oak N 83 W 26 links, Wide over 11th 55th 49th
D Stone in Prairie. See C corner
E White Oak 18th East 42 links
Bur. Oak 20th S 75th W 27th H. W. O. 15th 59th 32
A F. C. H. L. Stake in a Prairie -
San Hopkins Co. Sur. S. C.

June 1. 1837