


202
KEY ON MAP

T.3. R.13

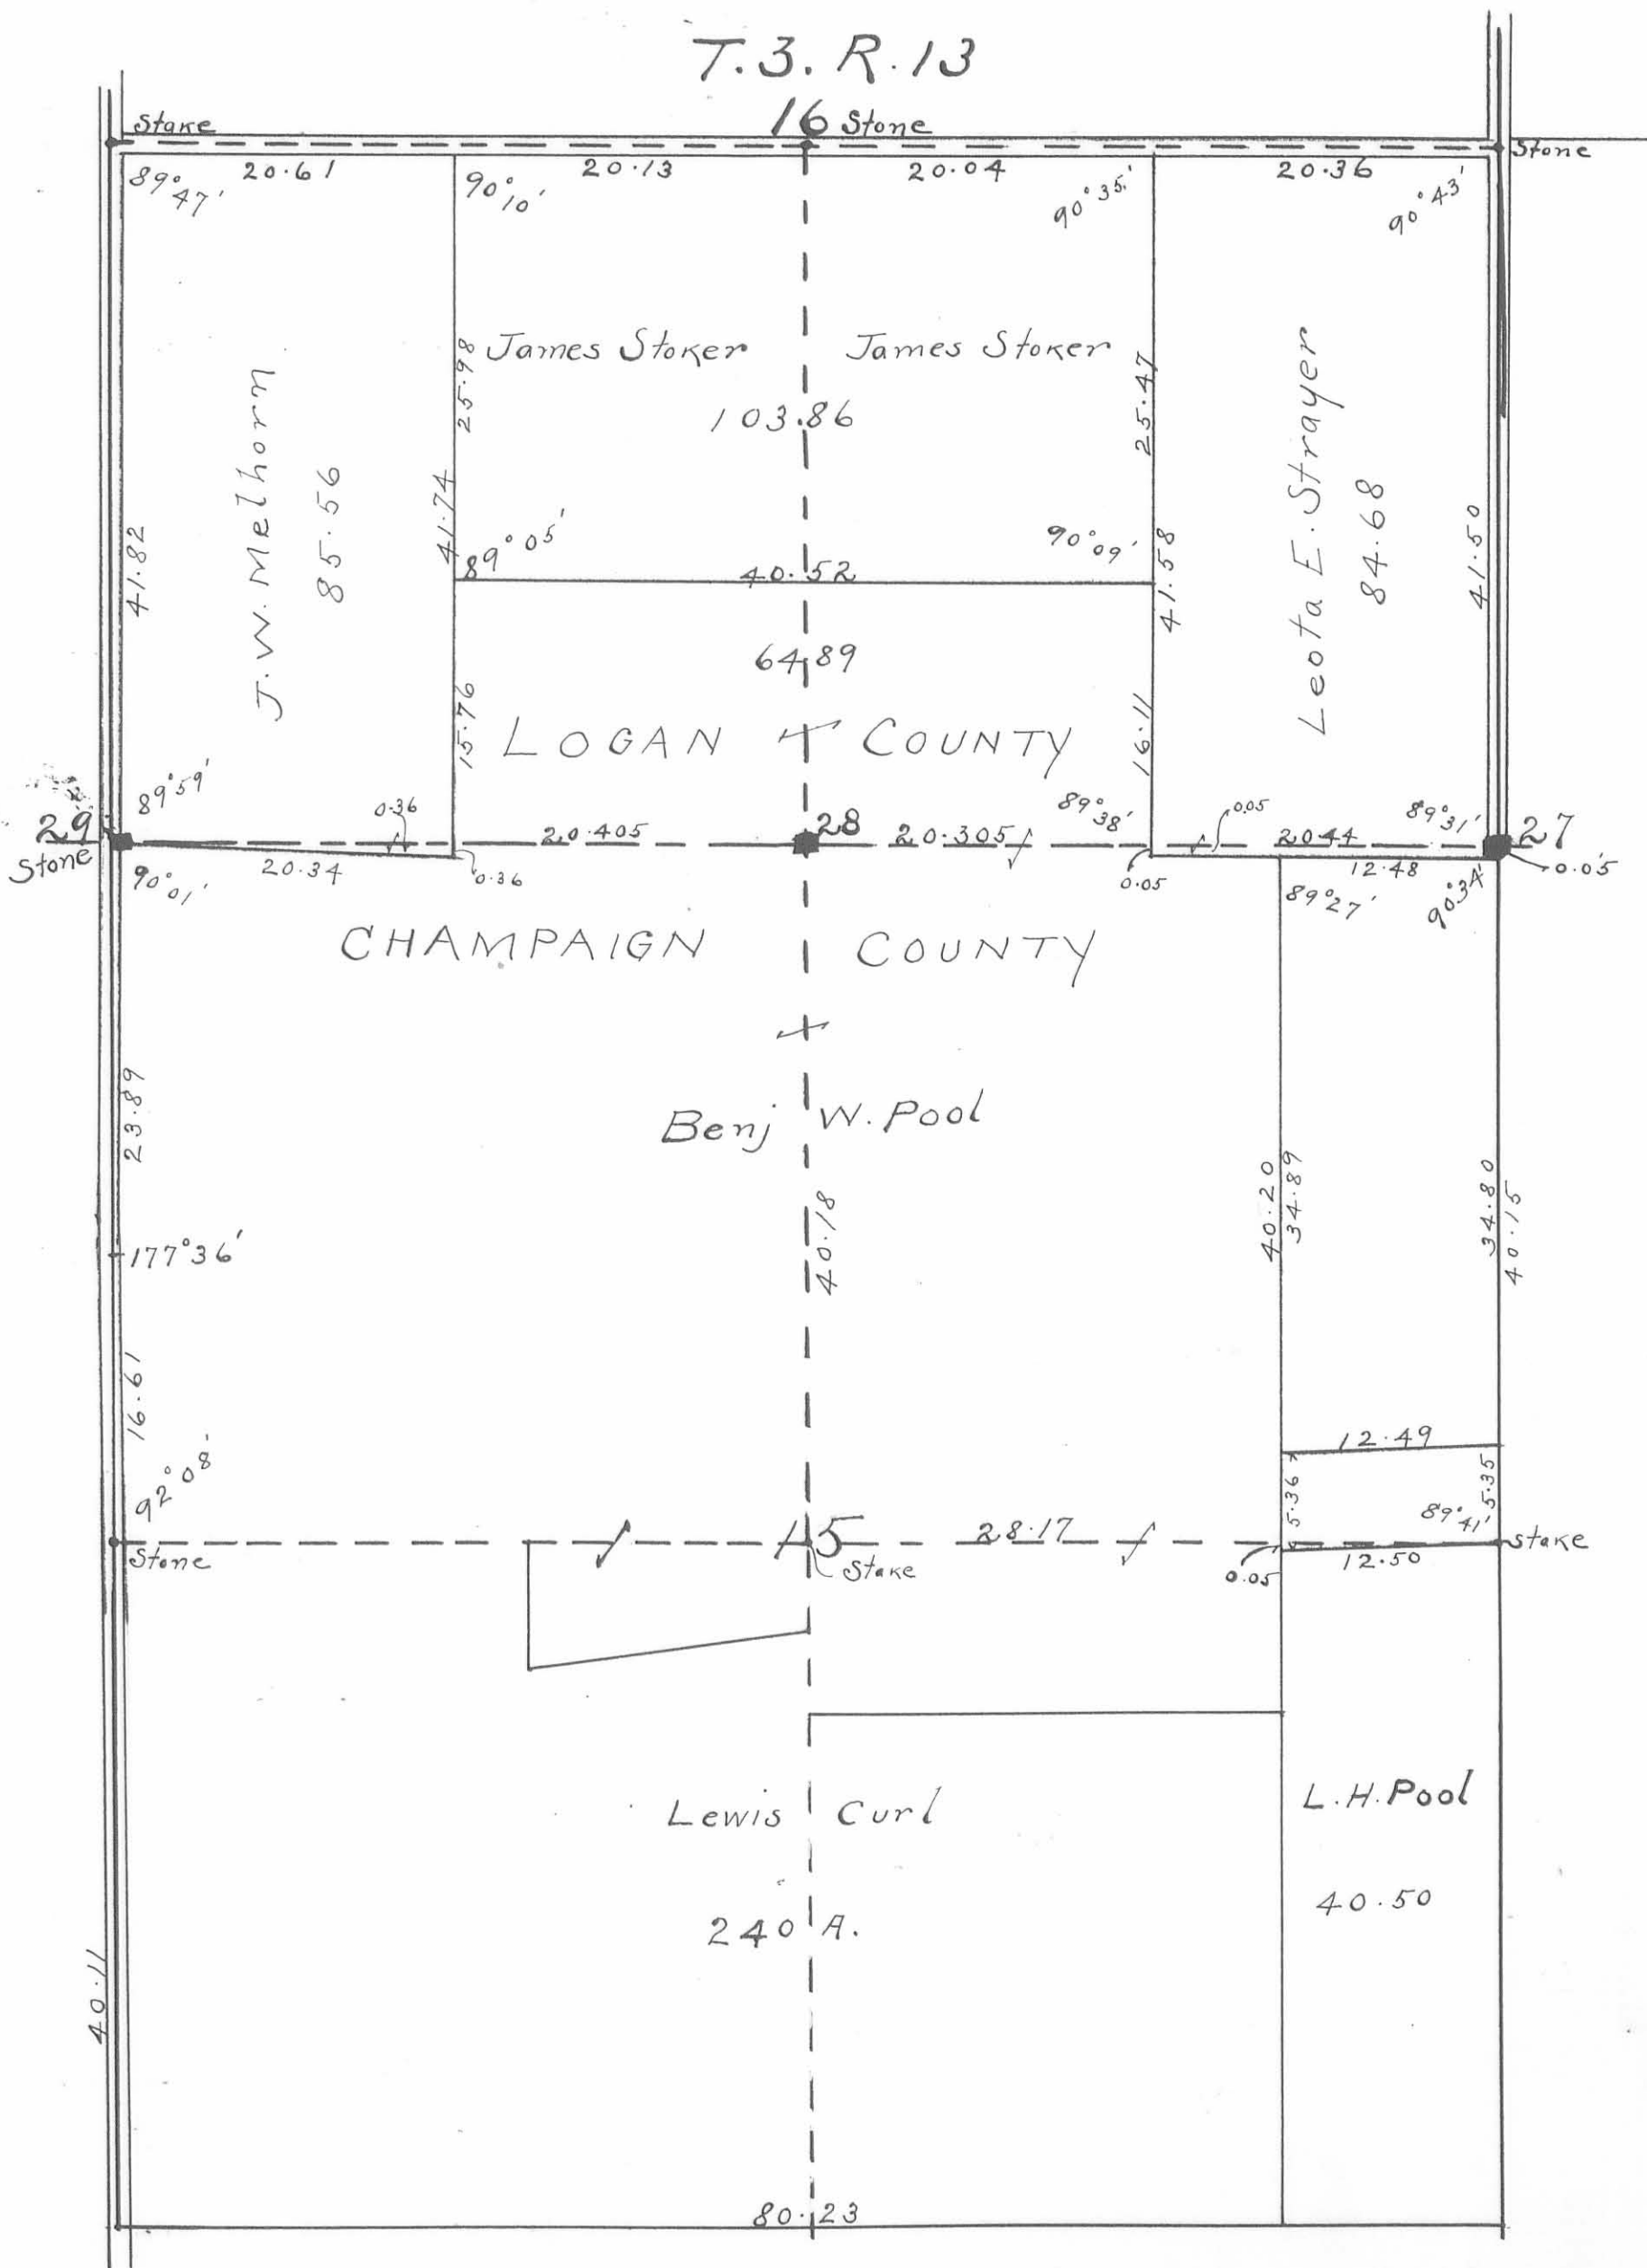

Monuments:
 No. 27 ~ Stone on line at Section corner.
 No. 28 ~ Stone on line at Qr. Sec. Corner.