

Road. 11
Miami and Pleasant Twp.

Free Pike Record 2 Page 145

DeGraff - Bellefontaine Pike 1870

Begin stake S.W. Cor., Sec. 1-3-14

50' Except 60' stake ^{920'} 5½ To ^{990'} 7½ = 16 Rods = 264'
Station = 8 Rods.

Road 43 { There are Two 60' stretches
stake 192¾ To 193¾ 16 Rods
stake 251 To 253½ 20 Rods

50' Sta 0+00 To 32+49 Pike Record.
(60 at Hill 264)

60' Sta 32+49 To
Commissioners Journal 5 - Page 167
1837

1798


INDEXED ON MAP.

Road 11

Station 0+00 to 5+85
Accurate & Not established
Houses and Buildings not noted


1798

INDEXED ON MAP

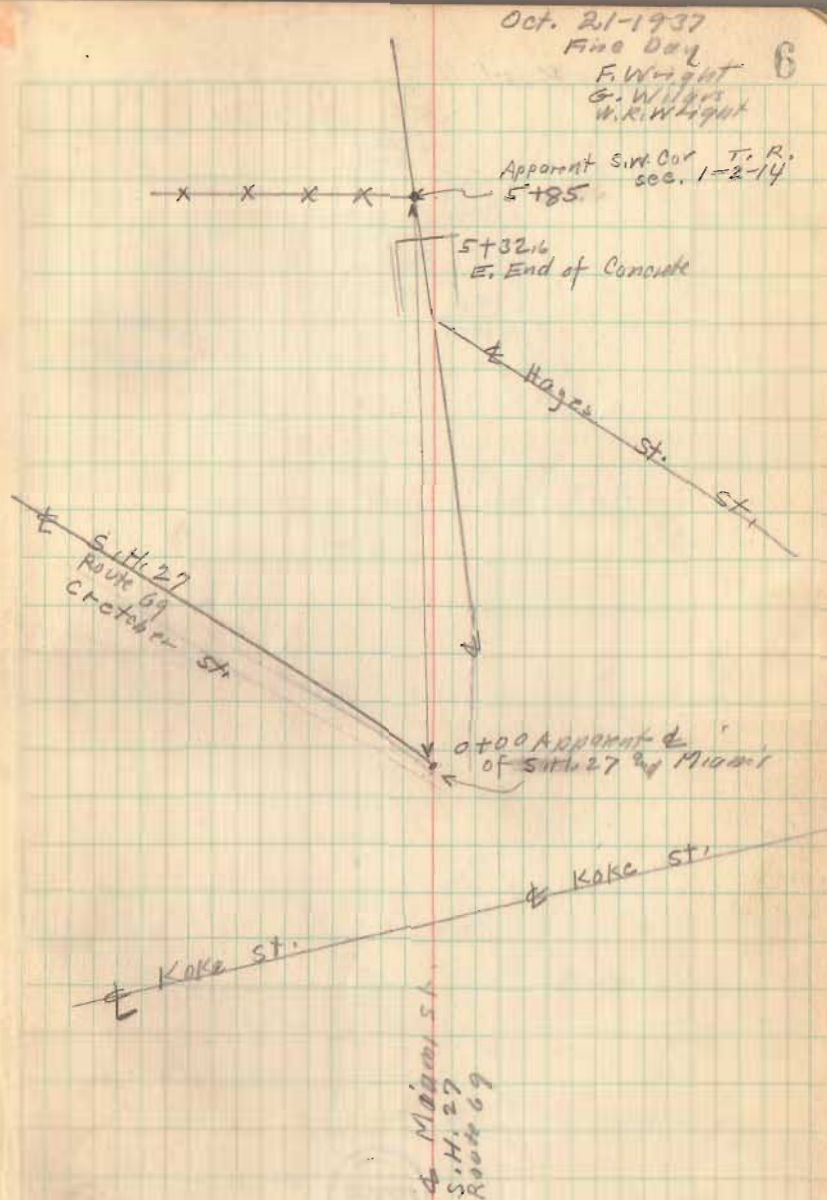

Road 11

10-21-37



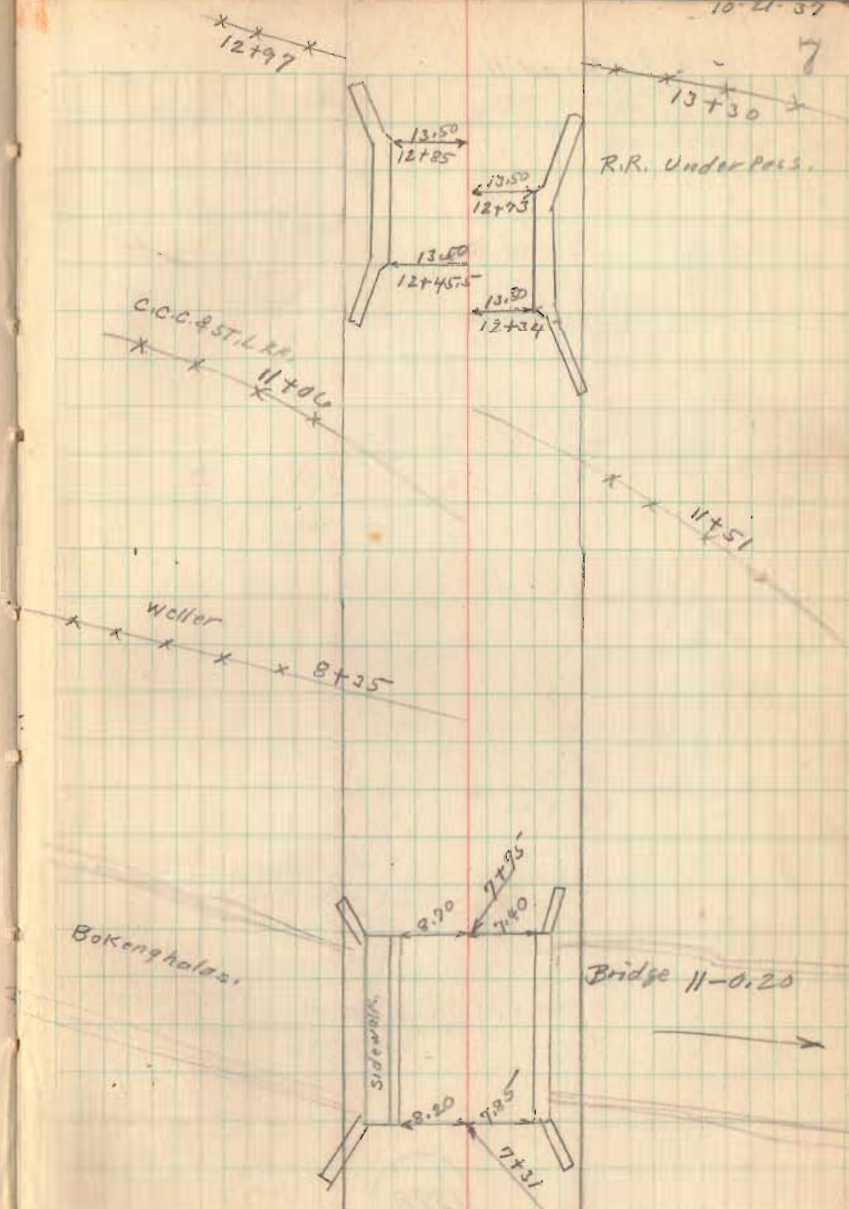


1798

INDEXED ON MAP

Road 11

10-21-32

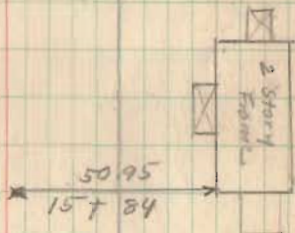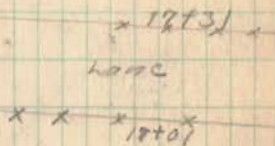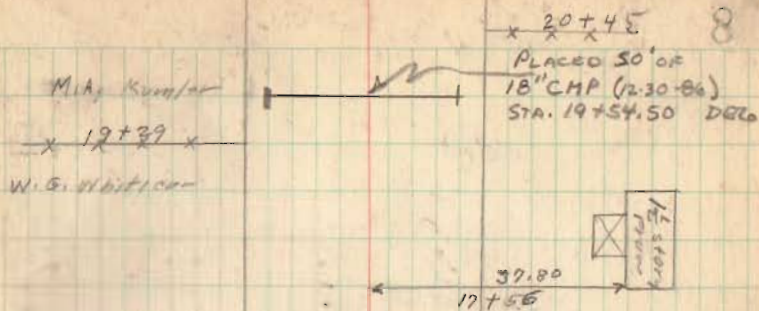

1798

INDEXED ON MAP

Road 11


10-21-37

32481

Missie Miller

29789

J.A. SHAW

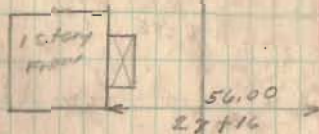

Geo. Mohr

25+72

M.A. Kuntz

1798

INDEXED ON MAP

Road 11

58+00

52+00

48+00

46+02.94

45+02.34

44+02.34

42+00

39+00

34+00



R/W Posts

Approx 90
Foot Scale

J. Huber

J. Huber

O.W. Loffer

Iron
48+00
20° 53' Right

Iron
46+02.94
36° 17' Right

Iron
45+02.34
23° 50' Right

30.02 30.02

234.0

316.0

316.0

306.5

306.5

63.0

26.70

30.15

33.20

23.70

10' width

10' width

Sec. 31-3-14

(No Fence)

Sec. 1-3-14

3/4 Iron 18' long
N. End of Tar

Steel
Sec Book
559
Page 65

24" Elm
2' dia

28.40

18.05

62.30

Sec. 36-4-10

Wood Post

000 Timber Pins

Sec. 6-3-13

10' Elm

12' Oak

12' Oak

10

(Sec Book C Page 52)

Road 205

1287.00

339 Sec Book 390-A

Page 86

Ignored Post

54.20

12' Oak

Miller

12' Oak

12' Oak

O.W. Loffer

North
(Needle)

Geo. Moore

000 Post

000 Post

10' Elm

10' Elm

Iron
52+49
88

Iron
52+49
88

Mohr Dead
Val. 149-205
Gives 111 Points
(1815 Feet)
An ear to
Angle in
Pike

Mohr Dead
Val. 149-205
Gives 111 Points
(1815 Feet)
An ear to
Angle in
Pike

Mohr Dead
Val. 149-205
Gives 111 Points
(1815 Feet)
An ear to
Angle in
Pike

Mohr Dead
Val. 149-205
Gives 111 Points
(1815 Feet)
An ear to
Angle in
Pike

Mohr Dead
Val. 149-205
Gives 111 Points
(1815 Feet)
An ear to
Angle in
Pike

Iron
52+49
88

Iron
52+49
88

Road 11

71+91

68+00


63+00

1798

INDEXED ON MAP

Oct. 22 - 1937
Cloudy
E. Wright
G. Wilson
W. R. ...

11

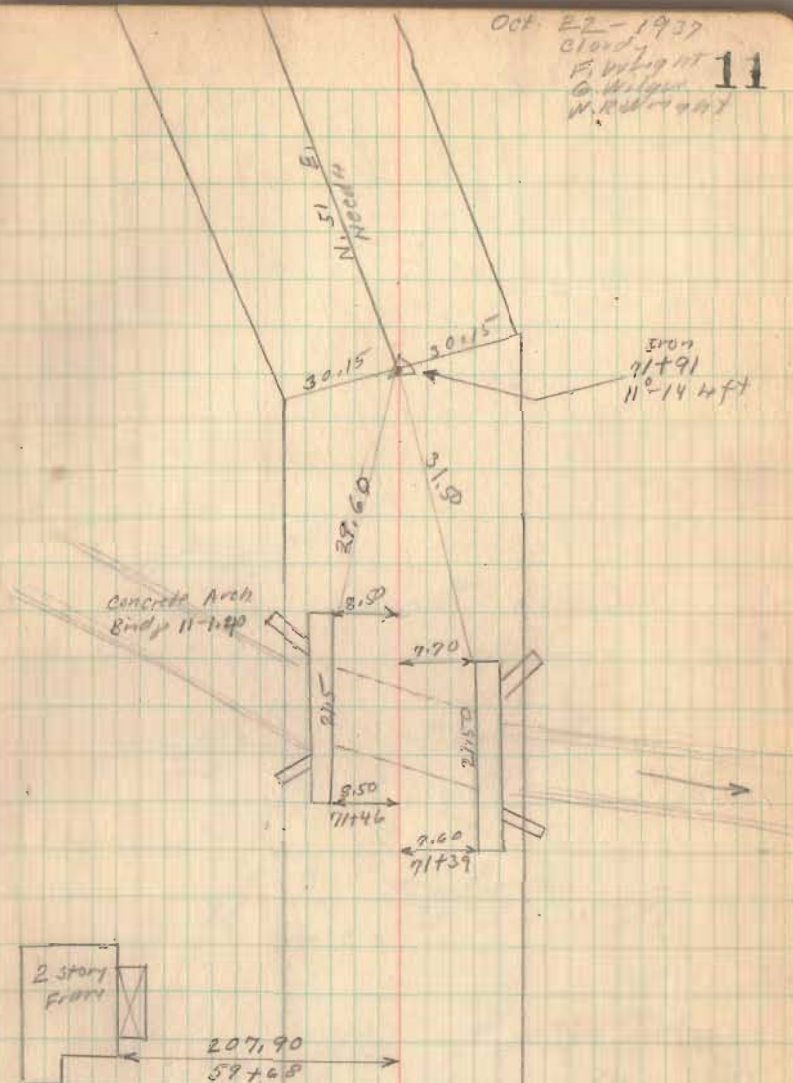

Road 11

Cooke Survey

Jan. 13, 1965

D. Dodson
L. Geeslin

82+50



78+50

74+77

74+77

1798

INDEXED ON MAP

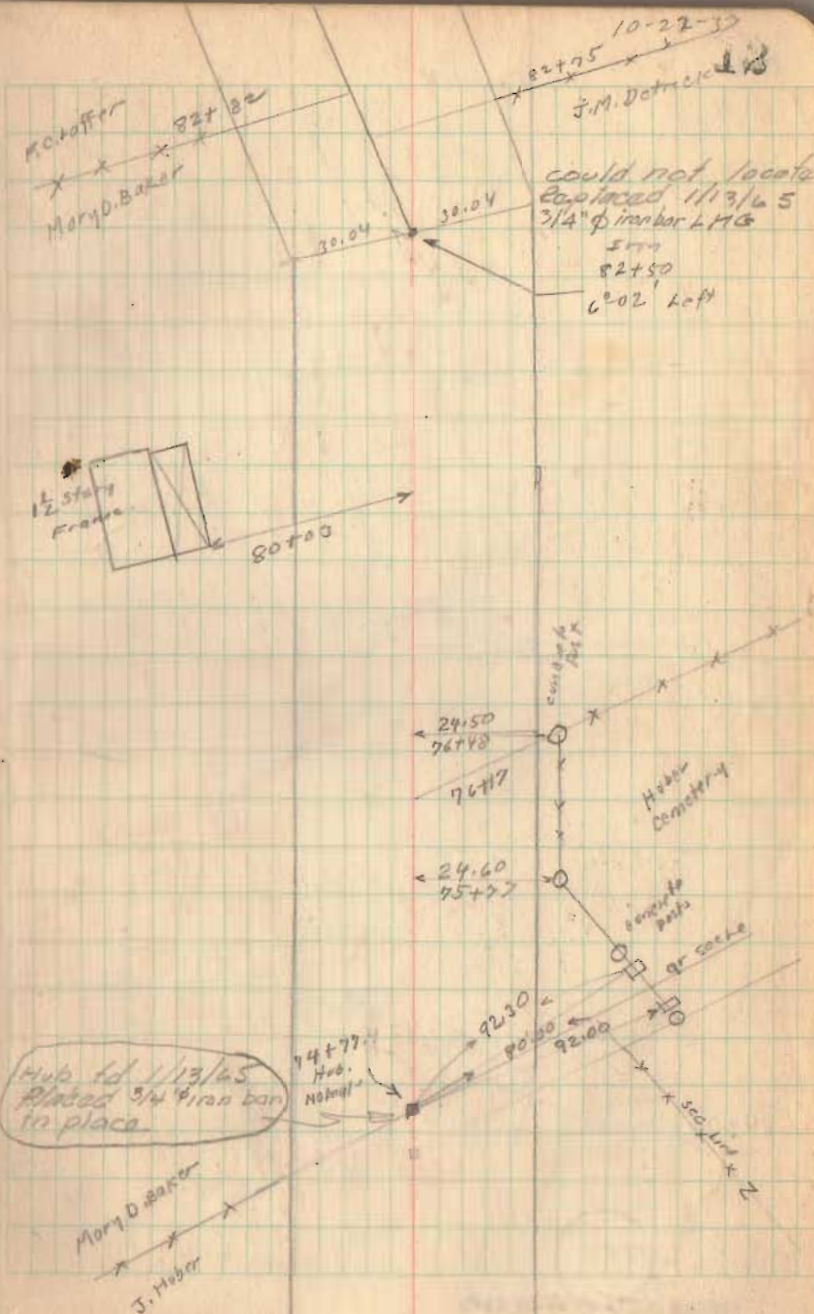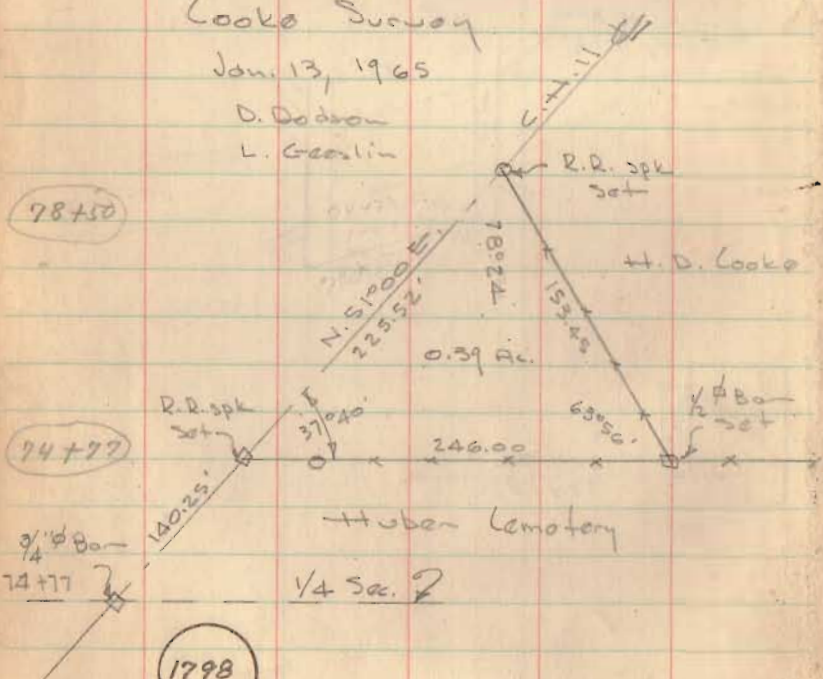

Hub Id 11/13/65
Placed 3/4\"/>

Road 11


10-22-37

13


84+00

1798

INDEXED ON MAP

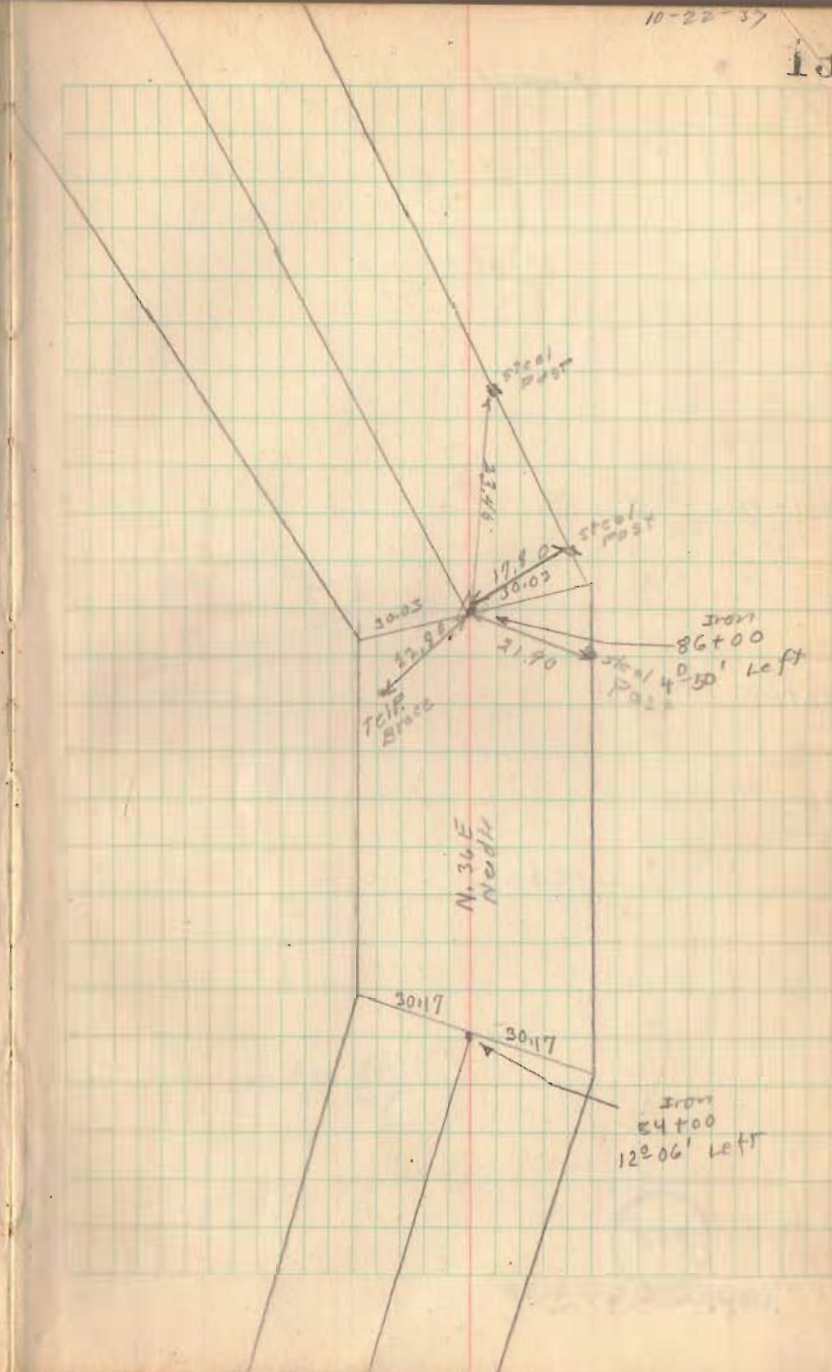

Road 11

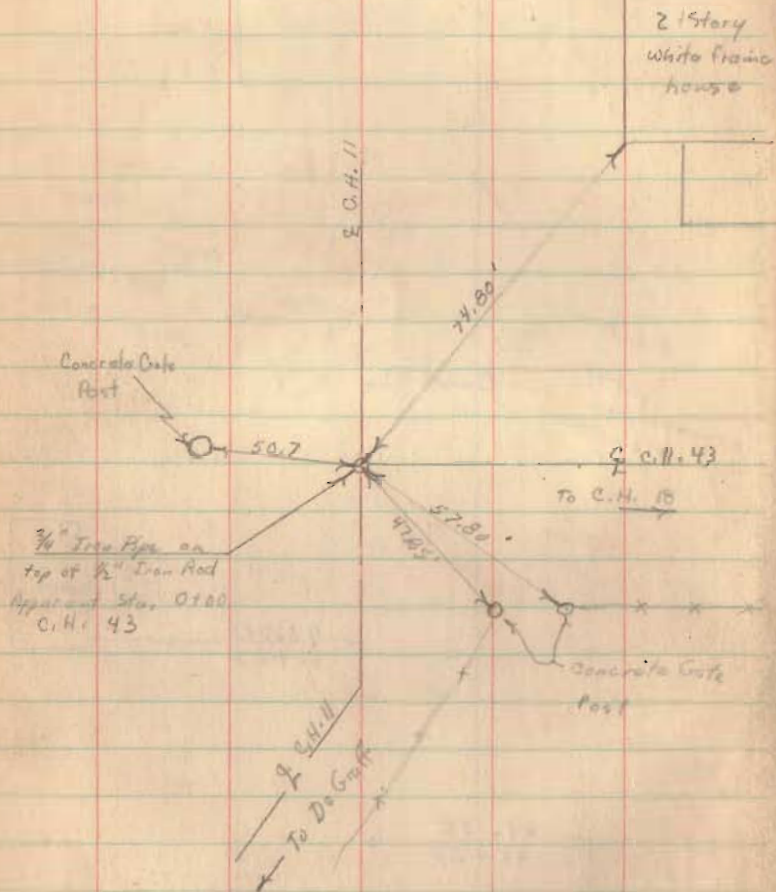

179B

INDEXED ON MAP

10-22-37

15

