

Survey in the N.W. and N.E  
 quarters of 5. 28 T4 R13 and  
 N.E 1/4 5. 34 T4 R13 Miami  
 and Union Prop for Arthur Holycross  
 and J. R. Harner

5-16-21

Found stone in road at N.E. corner  
 34 and N.W. corner of 28. (Green stone  
 set on end about 8' below surface)

Found stone in road at N.W. corner  
 of N.E. 1/4 section 34. Approx 8' square  
 about 6' below surface.


Measure 40.06 chs. between above stones.

Set nail near center of bridge for  
 N.W. corner Holycross set 3/4" iron pipe 0.25  
 chs. west of corner and 1/2" iron pipe  
 east of corner both on the N. line of  
 5. 34 as shown by stone at N.E. cor  
 of section and stone at quarter point.

Found stone 6.75 ch west of S.E  
 corner past of Holycross and a links  
 south of fence between Rausenberger  
 and Holycross.

C. F. Lyke  
 W. E. Elliott.  
 Arthur Holycross  
 John Harner.

North. Exp day 24

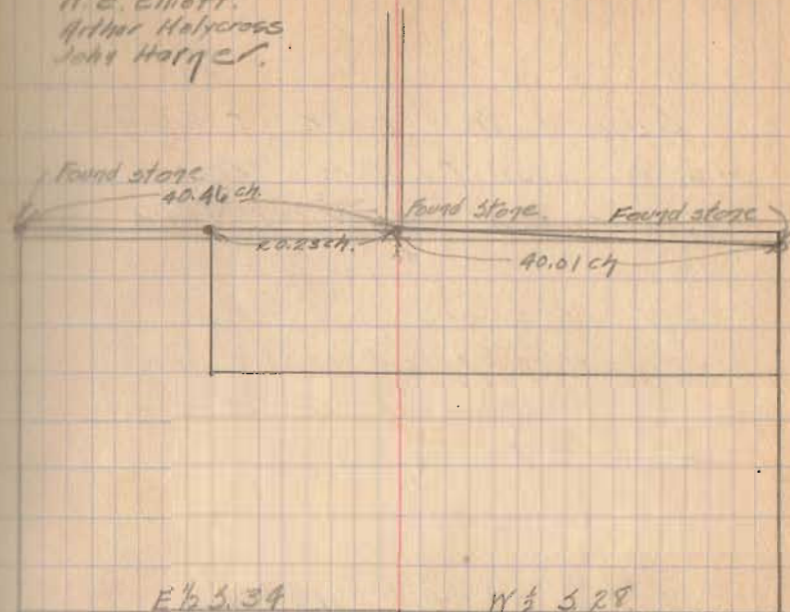

INDEXED ON MAP

2227

Logan Co. Measurement  
 Champaign Co.

Chained from stone at N.E. cor  
Hollywood to I.P. in cross roads at  
N.E. corner of Harner 20.29 chs.

Run random line from 10' west of stone  
at N.E. corner of Hollywood to 15 1/2' W.

Bearing of line S. 5° W.

→ at R.S. stone of Champaign Co  
Line.

$$\frac{15}{80} \times 5\frac{1}{2} + 10' = \underline{11.03'}$$

Measure E 11' on line between  
Hollywood and Rausenberger and  
get S.W. corner Harner (Set stake)

This point falls west of present  
fence