
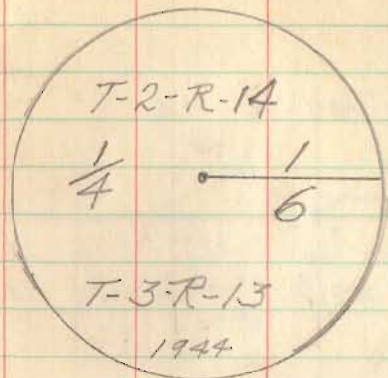


(1)

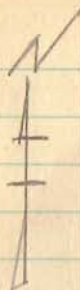


Oct. 9-1944

Dyset
Robbins
M^{rs}. Adams

Set Concrete Mon. 4' long 5" below
Surface of road 45.
Stamped as above.

See Field Book 619 p-10

2638

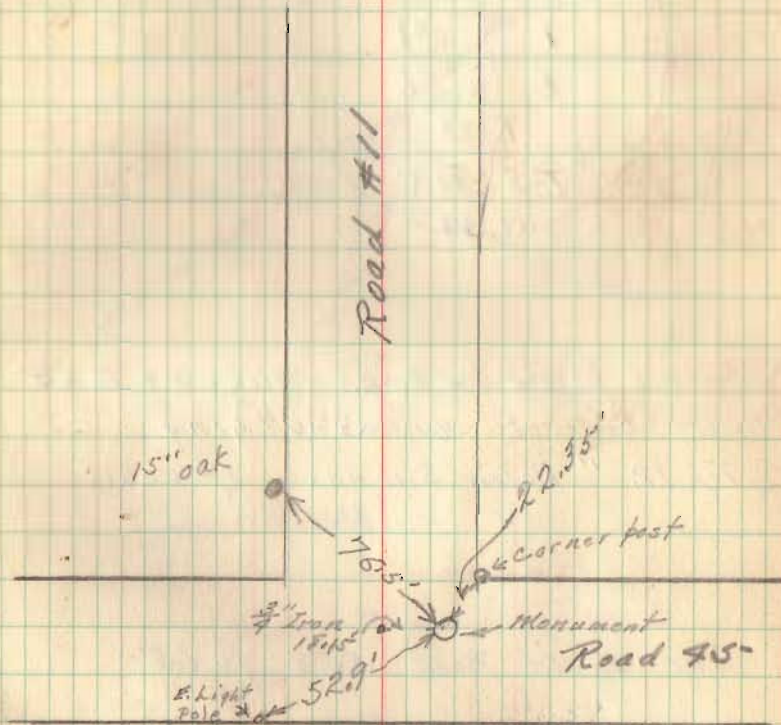

INDEXED ON MAP

2638

Measaut &
Miami Trps.

INDEXED ON MAP ✓