

CLAYTON - SCHAFER SURVEY

The following described real estate situated in the Township of Miami,
County of Logan, State of Ohio and being a part of Section 23 Town 1 Range 8
and being more particularly described as follows:

Beginning at a small iron set in the centerline of S. R. No. 235 at the
northeast corner to L. Wayne Clayton's present 65.44 Acre tract and in the west
line of Bertha M. Donald's present 55.89 Acre tract;

Thence with the west line of Donald's tract and the east line of Clayton's
tract, S. $6^{\circ} 30.3'$ E. 1,423.84 feet to an iron bar set, passing through a large
concrete post at 31.70 feet;

Thence S. $83^{\circ} 29.7'$ W. 200.00 feet to an iron bar set;

Thence N. $6^{\circ} 30.3'$ W. 435.60 feet to an iron bar set;

Thence N. $83^{\circ} 29.7'$ E. 170.00 feet to an iron bar set;

Thence N. $6^{\circ} 30.3'$ W. 978.13 feet to a small iron set in the centerline of
S. R. No. 235, passing through an iron bar set at 947.43 feet;

Thence with the centerline of S. R. No. 235, N. $64^{\circ} 40.0'$ E. 31.70 feet to
the place of beginning, containing 2.677 Acres, more or less.

The above 2.677 Acre tract being surveyed out of L. Wayne Clayton's present
65.44 Acre tract.


I hereby certify that this is an accurate description of a survey made by
me on June 9, 1983.



Daniel E. Gilbert, P.S.
Reg. Sur. No. 5402
1041 N. Main St.
Bellefontaine, Ohio 43311

6850 1D


INDEXED ON MAP

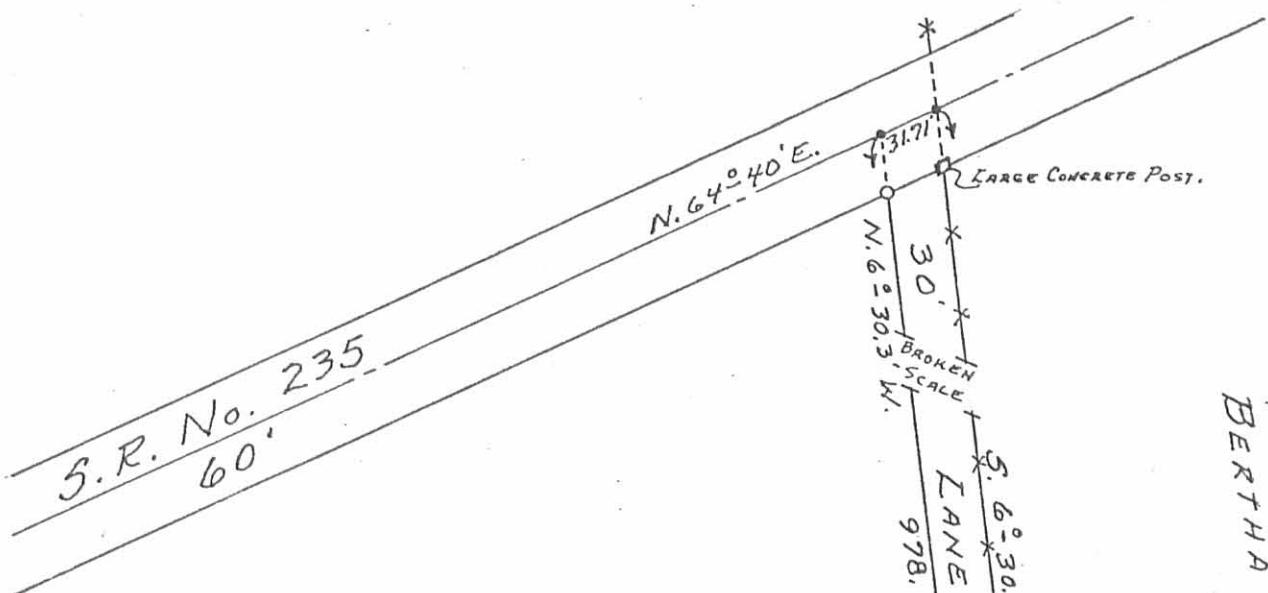

L. WAYNE CLAYTON

$$\begin{array}{r} 65.440 \text{ ACRES} \\ - 2.677 \\ \hline 62.763 \text{ ACRES} \end{array}$$

* - SMALL IRONS IN ROAD.
0 - 5/8" X 30" REBARS. SET.

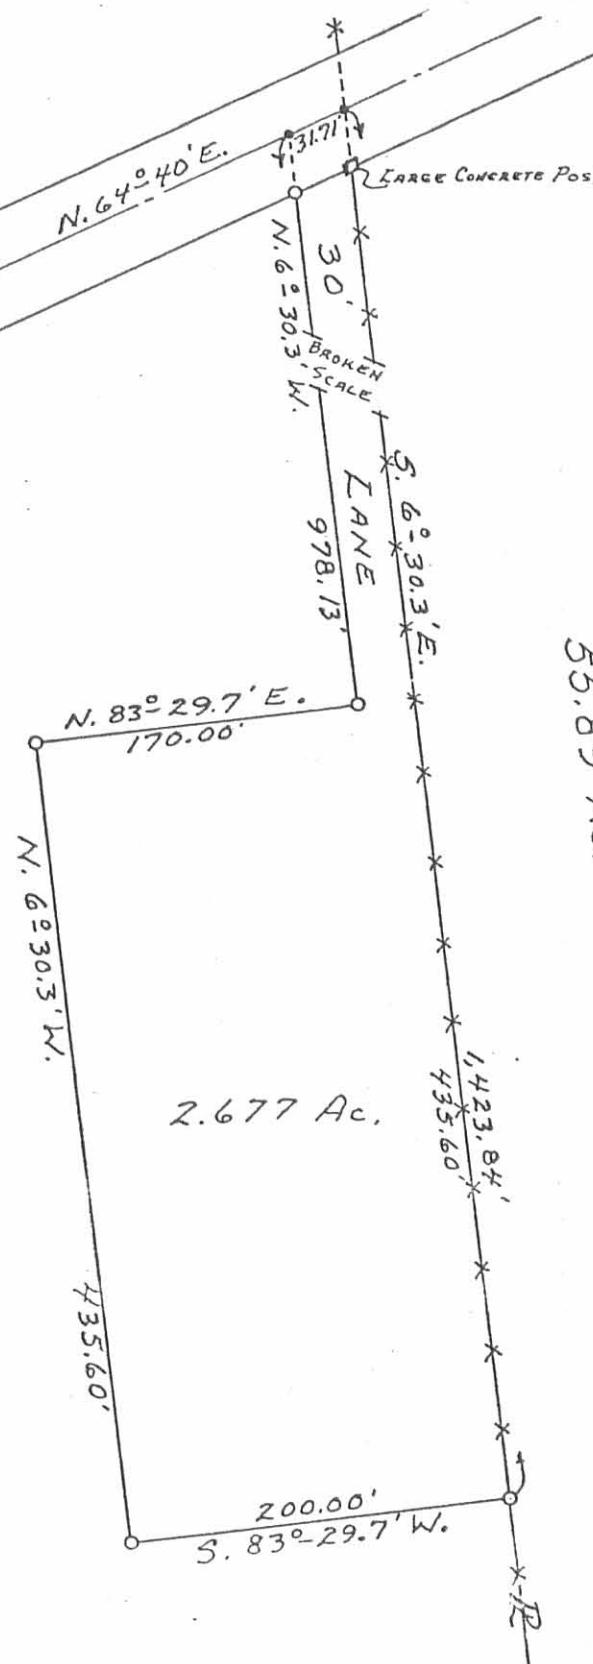

BERTHA M. DONALD ET/VR
55.89 Ac.

INDEXED ON MAP

CLAYTON-SCHAFFER SURVEY
SECTION 23 T. 1 R. 8
MIAMI TOWNSHIP
LOGAN COUNTY, OHIO
JUNE 9, 1983

SCALE: 1" = 100'

SURVEYED AND PLANNED BY:
DANIEL E. GILBERT, P.S.
REG. SUR. NO. 5402
1041 N. MAIN ST.
BELLEFONTEINE, OHIO 43311