

CAL.
J.H.I.
TT.
C.S.

6-16-36

Road 166
Munroe Twp.

See Book 521 Page 53
for smucker survey

1742

INDEXED ON MAP

362.8

510.7

873.5

South

Smucker

Found stake

362.8

0°-57'

10°-54' (Double)

Found stake

12' apple tree

N16E 261'

321.1

15" Hickory

502.2

510.7

16°-03'

32°-16' (Double)

10006

87.7

Set 1/2" bar

438.7

S14 607

Route 287

Set spike

212'

502.2

30'

30'

4500

30'

30'

Road 166

'A" stake 2' from N.E. 26.7
12' west E 27.5

7/13/36
"C"

Found bolt and old stake
1' - below surface and
about 2' N. of Line
fence to E.

Telephone Pole N.W. 12.5"
Old post E 17.9'

Searched for monument
203.9' S. of stone at "D"
Found nothing. Believes
this distance is error.

1742

INDEXED ON MAP

Smucker


Vertic kiser

'A" □

Found stake

Smucker

Vertic kiser

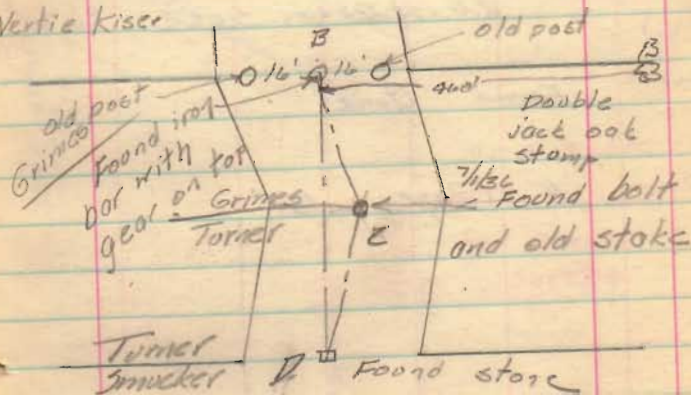

Road 106

"A" Found stone

30" Maple S. 2 1/2 W. 29.5'

30" " S. 50 W. 52.4'

30" " S. 2 W. 52.4'

"B" 1/2" Pipe (Found)

12" Hickory stump N. 11 E 33.5'

N.D. of Red oak S. 62 E. 36.2'

"C" Found Stone

D "A" Page 13

Road 171

"A"

Not obtained

B

Stake marked

12" (Red oak) N. 11 E

Stake marked

SEE BOOK

102 200521 Page 50

for Smucker

Survey

125.0'

Stake 10' W.

1742

INDEXED ON MAP