




4/28/43

Found 3/8" x 30" re-inforcing rod
 Removed rod + placed monument in
 same position. Approx. 5" below surface
 of road.

Monument stamped as shown above.

J. H. Inskeep
 Lane Kerns
 Paul Fout

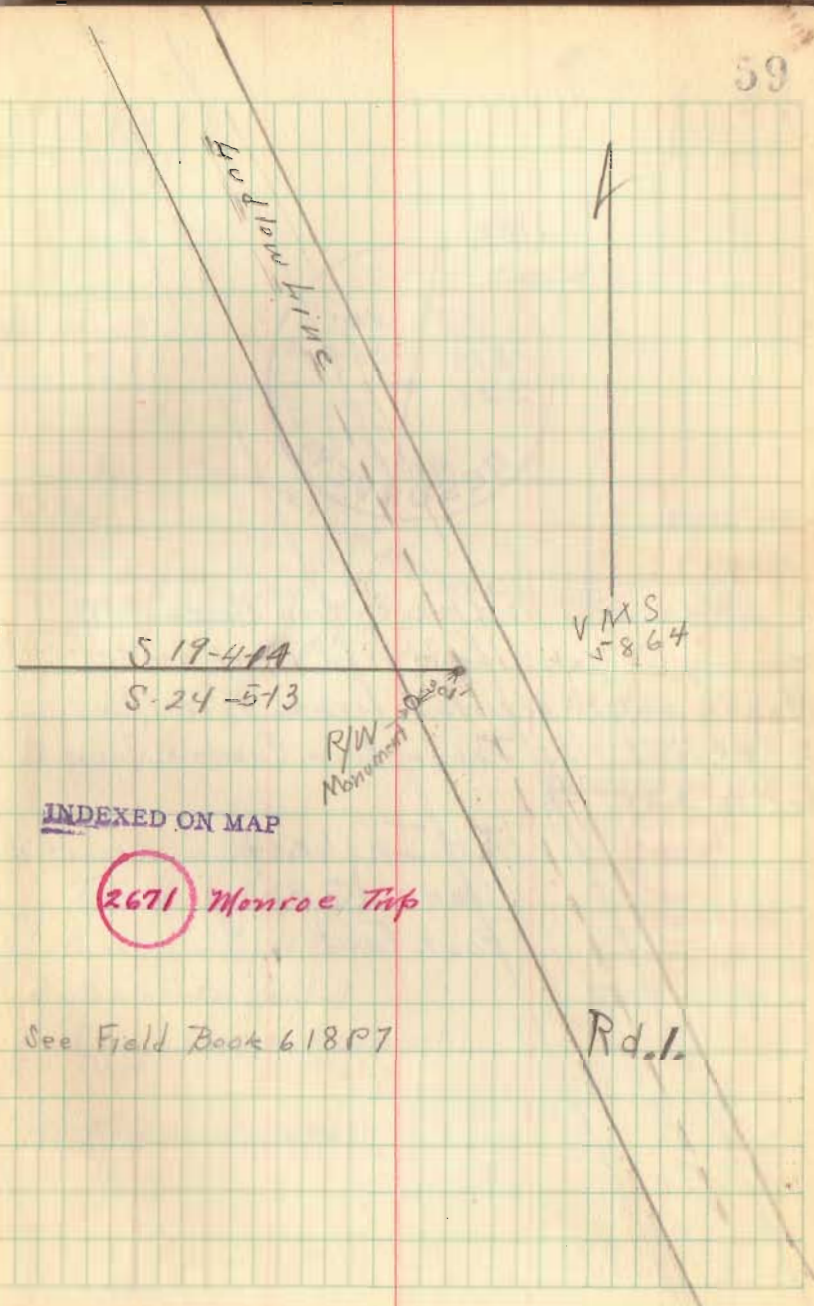

See Field Book 618P7