
DANIELS SURVEY
Sec.29 T-5 R-13 Liberty Twp.
Sec.23 T-5 R-13 Monroe Twp.
July 24, 1971

The following described real estate situated in Liberty and Monroe Townships, Logan County, Ohio and being part of Section 29, Town 5, Range 13 and part of Section 23, Town 5, Range 13, and more particularly described as follows:

Beginning at an iron pin in the center of County Highway No.5, said pin being N.50° 00'E. 376.5 feet from an iron pin in the east line of Orva J. Foulk's 44.50 acre tract, said pin being Sta. 99 + 77.5 as shown in Logan County Engineers field book 509, page 59; thence with the centerline of said C. H. No.5, N.50° 00'E. 43.0 feet to an iron pin; thence with said centerline N.65° 00'E. 828.9 feet to an iron pin, passing the west line of Sec.23, T-5, R-13 at 28.4 feet; thence South 450.7 feet to an iron bar; thence N.84° 42'W. 787.6 feet to the place of beginning.

Containing 4.16 acres more or less of which 4.13 acres are in Monroe Township and 0.03 acres are in Liberty Township.



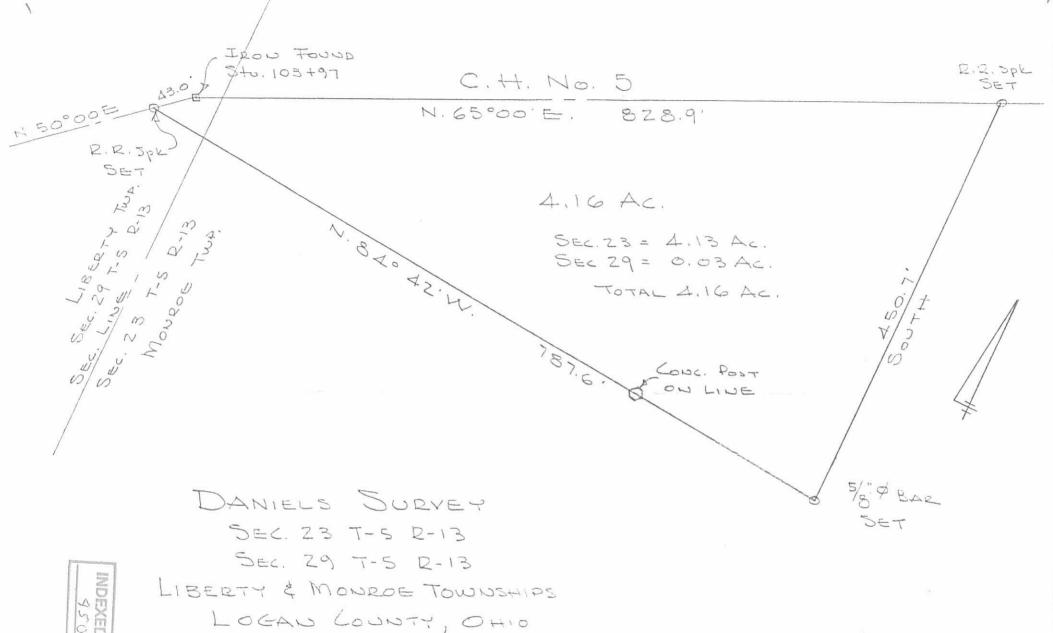

JULY, ZA, 1971

SCALE 1"=100'

NDEXED ON MAP

DAN L. DODSON
REG. DURUETOR AZTO
BELLEFONTAINE, O.
F.B. 18/ZZ

