


FB 708

MACACHEEK CEMETERY

V.M.S. 10091

MONROE TOWNSHIP

- A = 5" sq. Stone Found
- B = 1" ϕ BAR SET
- C = " " "
- D = " " " 45.1 N. OF S.E. COR. Long Post
- E = " " " = D PG. 21
- F = STONE FOUND = E. PG. 21
- G = 1" ϕ BAR SET 13.3 S. OF 15" W. CHERRY & 1.9' W. OF EX. FENCE

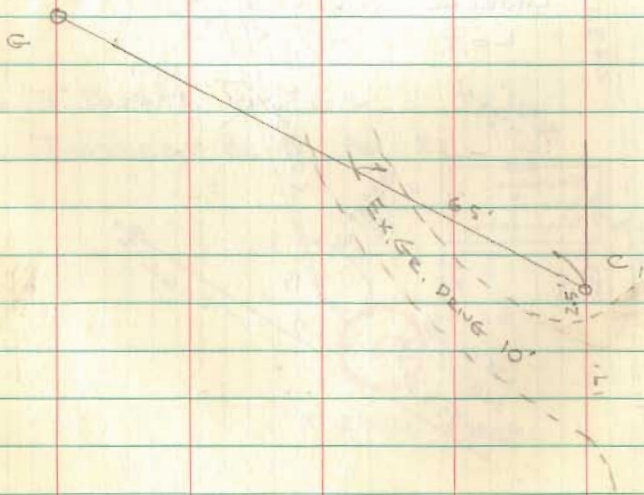

DODSON-GEELIN
H. Kim - NICHOLS

12/19/71
50°

22

