\ Received 3-21-94

LESLIE H. GEESLIN

REGISTERED SURVEYOR NO. 5248

P.O. BOX 274

RUSHSYLVANIA, OHIO 43347 TELEPHONE: (513) 468-2793

HALL SURVEY

March 18, 1994

The following described real estate situated in the State of Ohio, County of Logan, Township of Monroe being part of Section 19, Town 4, Range 14, and Section 24, Town 5, Range 13 and more particularly described as follows:

Beginning at a R. R. spike found in the centerline of Township Road 190 at the southeast corner of Larry Pearson's 18.796 acre tract as described in O. R. Vol. 119 Page 966.

Thence with said Pearson's east line N. 4° 53' 06" E. 709.10 feet to a 5/8 inch iron bar found.

Thence continuing with said east line N. 42° 45° 10° E. 441.68 feet to a 5/8 inch iron bar found.

Thence again with said line S. 82° 16' 45" E. 333.98 feet to a 5/8 inch iron bar found.

Thence again with said line N. 52° 24' 56" E. 223.46 feet to a 5/8 inch iron bar found at the southwest corner of Scott Robinson's 5.438 acre tract as described in O. R. Vol. 108 Page 587.

Thence with said Robinson's south line N. 52° 26' 36" E. 628.48 feet to a 5/8 inch iron bar set at the northwest corner of Charles Hall's 1.166 acre tract as described in O. R. Vol. 155 Page 647.

Thence with said Hall's west line and the west line of his 0.393 acre tract as described in O. R. Vol. 155 Page 653 S.31°21'17"E. 188.13 feet to a 5/8 inch iron bar found.

Thence with the south line of said 0.393 acre tract N. 63° 47' 08" E. 296.56 feet to a 5/8 inch iron bar found in the centerline of County Highway 1.

Thence with said centerline S. 14° 52' 53" E. 227.87 feet to aR. R. spike found at the northeast corner of Laurie Fisher's 1.031 acre tract as described in O. R. Vol. 134 Page 194.

Thence with said Fisher's north line S. 54° 09' 05" W. 328.01 feet to a 5/8 inch iron bar found.



Thence with said Fisher's west line S. 35° 55' 14" E. 149.73 feet to a 5/8 inch iron bar found in the north line of Tony Waltzer's 2.215 acre tract as described in O. R. Vol. 183 Page 310.

Thence with said Waltzer's north line S. 54° 11' 40" W. 414.69 feet to a 5/8 inch iron bar found in the north line of Joe E. Neer, Trustee, etal's 134.77 acre tract as described in O. R. Vol. 165 Page 541.

Thence with said Neer's north line N. 85° 15' 58" W. 183.24 feet to a 5/8 inch iron bar set.

Thence with said Neer's west line S. 4° 35' 30" W. 522.63 feet to a 5/8 inch iron bar found at the northeast corner of Luanne Rose's 2.210 acre tract as described in O. R. Vol. 201 Page 280.

Thence with said Rose's north line and the north line of Larry Simmons' 1.264 acre tract as described in 0. R. Vol. 108 page 130 N. 85 $^{\circ}$ 33' 24" W. 550.37 feet to a 5/8 inch iron bar found.


Thence with said Simmons' west line S. 4° 29' 51" W. 274.97 feet to a R. R. spike found in the centerline of said T. R. 190.


Thence with said centerline N. 85° 30' 00" W. 481.35 feet to the place of beginning.

Containing 29.751 acres more or less of which 0.159 acre is in the right-of-way of County Highway 1, 0.221 acre is in the right-of-way of Township Road 190, 14.397 acres are the remainder of Burley Hall's 66.18 acre tract as described in 0. R. Vol. 99 Page 441 in Section 19, Town 4, Range 14 and 15.354 acres are the remainder of his 24.82 acre tract in Section 24, Town 5, Range 13.

Bearings are based on an assumed bearing (N. 85° 30' 00" W.) for the centerline of Township Road 190 in this field survey by Leslie H. Geeslin, Reg. Surveyor 5248 on March 18, 1994.



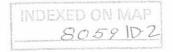

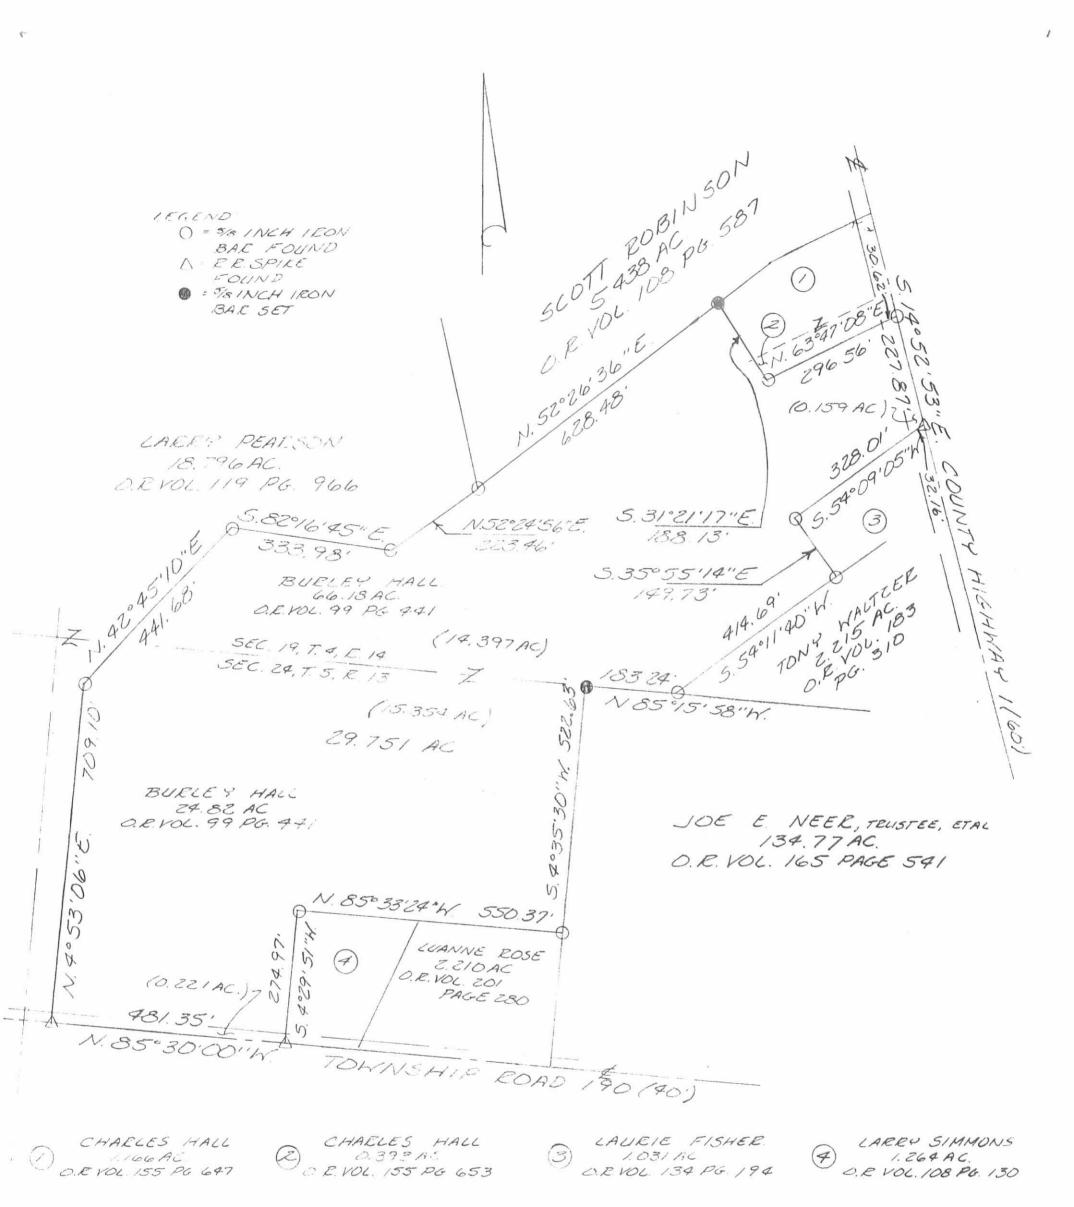

SCALE: 1"= 200'

SURVEY & THE REMAINDER & A 66.18 ACRE TRACT & SECTION 19, TOWN 4, EANGE 14 " A 24.82 ACRE TRACT 'SECTION 24, TOWN 5, COUNTY, OHIO FOR BURLEY HALL ON MACCH 18, 1994



8059 IP RUSHSYCVANIA, OH (513)468.2793

INDEXED ON MAP

Richard A. Bruce and Associates, Inc.

637½ South Main Street

Bellefontaine, Ohio 43311

513/599-2595



HALL SURVEY
18.796 AC. TRACT
S. 24, T. 5, R. 13
S. 19, T. 4, R. 14
MONROE TOWNSHIP
LOGAN COUNTY, OHIO

The following described real estate situated in the State of Ohio, County of Logan, Township of Monroe, being part of Section 24, Town 5, Range 13, and part of Section 19, Town 4, Range 14, and more particularly described as follows:

Beginning at a railroad spike found in the center of T.R. 190, in the west line of Section 24, and being the southeast corner of Victoria L. Maxon's 3.677 acre tract as described in O.R. 108, Page 136.

THENCE, with the west line of Section 24, N. 04° 47' 44" E. 801.49 feet to a re-survey monument, shown in Logan County Engineer's resurvey on July 28, 1960, found marking the southwest corner of Section 19, and the northwest corner of Section 24, passing a concrete right-of-way monument found at 20.00 feet.

THENCE, with the west line of Section 19, N. 03° 57' 32" E. 1185.25 feet to a 5/8 inch iron bar set marking the southwest corner of Doral C. and Janet Mae Neal's 38 acre tract as described in D.B. 243, Page 390.

THENCE, with the south line of said Neal N. 77°28' 56" E. 523.72 feet to a 5/8 inch iron bar found marking the northwest corner of Steven P. and Brenda S. Fahle's 11.526 acre tract as described in O.R. 107, Page 805.

THENCE, with the west line of said Fahle S. 16 14' 11" E. 728.54 feet to a 5/8 inch iron bar found marking the northwest corner of Scott S. Robinson and Rita R. Grimes Robinson's 5.438 acre tract as described in O.R. 108, Page 587.

THENCE, with the west line of said Robinson S. 12° 42' 52" E. 283.18 feet to a 5/8 inch iron bar found.

THENCE, S. 52° 21' 43" W. 223.95 feet to a 5/8 inch iron bar set.

THENCE, N. 82° 19' 19" W. 333.44 feet to a 5/8 inch iron bar set.

THENCE, S. 42° 40' 22" W. 441.46 feet to a 5/8 inch iron bar set.

THENCE, S. 04° 47' 44" W. 709.20 feet to a railroad spike set in the center of T.R. 190, passing a 5/8 inch iron bar set at 689,20 feet.



THENCE, with the center of T.R. 190, N. 85° 35' 40" W. 60.00 feet to the point of beginning.

Containing 18.796 acres, more or less, of which 17.616 acres are in Section 19, Town 4, Range 14, and 1.180 acres are in Section 24, Town 5, Range 13, of which 0.028 acres are contained in Township right-of-way.

The above described 18.796 acre tract being part of Burley E. and Patricia M. Hall's original 54.81 acre tract as described in O.R. 99, Page 441, and part of Burley E. and Patricia M. Hall's original 21 acre tract as described in O.R. 99, Page 441.

Basis for Bearing: Centerline of T.R. $190 = S. 85^{\circ} 30' 00'' E.$

This description prepared from an actual field survey.

Prepared by:

Richard A. Bruce, P.E., P.S.

Reg. Surveyor, No. 6993

July 9, 1990





