


N^o 391

June 1836

July 245

8383

W. F. Smith 2 1/2
W. 12 5/16 14
W. 30 5/16 42
W. 18 5/16 27

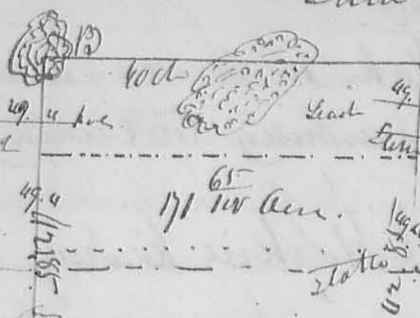

Surveyed June 4. 1836 for James Black
the N E q. of S 35 7/4 R 13 1/2 W. as follows

Beginning at the North East corner of said
Section. a white oak south 26 links thence
N 74 E 24 links (now down) thence with
the North line of the Section ending a sprain
to a Stake in a prairie (Wood run) thence
N 14 W 40 do. 85 links to Stake Loc 15

519 6 21 links in a prairie thence with
to Stake 540 E 12 links and then N 87 W 12 links (original
Corner here a White Oak 12 L. S 78 W 4 Links same 12 L. N 70 W
32 links, not found) thence N 16 W 42.85 to the beginning. Contain-
ing 171 ⁶⁵/₁₀₀ ac.

George Curran 2
Robert Laro 3 do. com.

Dan Hopkins, Co. Sec. G.

N^o 382

8384

Surveyed July 11. 1836 for Saml. Mason part of Military
Survey N 4478. as follows - Beginning at a White oak Sugar
3/4 Do. N W corner to Edward Mason's land thence West 123
poles to a Stake, thence North 8 poles to a Sugar & Elm, thence
N 77 E 102 poles to a Stake in the Jonesfield Road, thence in said
Road ^{57 1/2} 75.7 poles to a Stake, thence South 78 poles to the beginning
Containing 64 ⁷⁵/₁₀₀ ac.

Lep. Millner Saml. Mason Sec. do. Sec. Dan Hopkins, Co. Sec. G.

N^o 333

8385

Surveyed July 12th for George Moots part of Military
Survey N 4479 as follows. Beginning at Black Oak N E corner
to Thomas Catherington N. as a prairie, thence S 70 W 276 poles.
passing a stem near two White Oak ^{at 187 1/2} poles and ^{at 187 1/2} poles to a stem
in a prairie, thence S 28 W 203 poles passing a stem. Moots N E
Corner at 52 poles, to Thicker's original corner of the Survey, one
of them now down - These lines were run for the purpose of establish-
ing boundary between said Moots & Lewis & Thomas. at same
time Surveyed for J. Mottet and Brother part of same Survey
beginning as above thence S 70 W 137 poles to stem be. oak and
hickory. thence N 70 W 16 1/2 poles to 21 aspen thickly.

July 1836.

then N70E 137 poles to a Stake in the original Line -
then S20E 14 1/2 poles to the beginning containing 1240/100 acres.
then in Armstrong }
Jeffrey William } do men D Hopkins Co Secy. I. C.

N^o 334 Surveyed for ^{James} ~~George~~ Grimes a lot of Land, commencing at James
McPherson as agent for Walter Tunn, Beginning at a Stake in
a Line in S. W. things North line of survey N^o 4479. then N70
E 109 poles to a Stake, come to Benjamin Long, then N21W
177 poles, passing 2 black oaks, originally the beginning come to
the survey at 108 poles to a Stake, then S70N 107 poles to 2
hickories, then N20E 178 poles to the beginning containing
1197 2/100 acres.
George Mott 3
C. Rand 3 do men D Hopkins Co Secy. I. C.

N^o 335 Surveyed for McAnis & Roberts as follow, part of Lyn Star
line's Survey N^o 3323 Beginning at a corner between their
Corner and said Roberts, being S. E. corner to said Roberts about
Elm & Ironwood then N 70W 27 poles to a small Elm and oak
then N 80E 25 poles to a stake in a swamp, an oak 15 inches di-
ameter bears S 57E 29 links, then S 10E 130 poles to a post -
then S 80W 102 poles to a Stake, then W. Elm Cherry and dog
wood S E corner of the survey, then N 10W 102 7/10 poles to a small
oak and hickory, then N 70E 187 poles to the beginning
containing 128 - acres. at same time Surveyed as
follows. Beginning at S. E. corner of the original survey at little
Cherry and dogwood above named then N 10W 102 7/10 poles
to Bar oak & hickory - then N 80E 118 poles to 2 oaks then
N 10E 51 2/10 poles to a Stake, then S 80W 49 poles to a Stake, then
N 10E 51 2/10 poles to a stake in the South line of the original
survey then with said line S 80W 69 poles to the beginning
containing 64 acres -
D Hopkins Co Secy. I. C.