RICHARDSON SURVEY

May 15, 1971

The following described real estate situated in the Village of East Liberty, Ohio, and being part of Virginia Military Survey 4689. Perry Township and being more particularly described as follows:

Beginning at an iron bar at the southwesterly corner of McLain and Robinson's Addition to the Village of East Liberty in the center of Foundary Street; thence with the westerly line of said addition and the westerly side of Lawrence Colmery's 0.28 acre tract and Horace D. Wagner's 0.72 acre tract N. 33°08' W. 739.2 feet to an iron bar in the southerly line of Delmer Moore's 0.55 acre tract passing an iron bar at 489.6 feet; thence with said Moore's southerly line and the southerly line of Sarah G. Finkbone's 1.25 acre tract S. 55°51' W. 551 / feet to a steel corner post in the easterly line of T.E. Comstock's 49.1 act; thence with said Comstock's casterly line S. 32°51' E. 524 Steet to a corner post; thence N. 56°22' E. 285.9 feet to a steel corner post; thence S. 33°26' E. 208.0 feet to a point in the center of Foundary Street; thence with said Foundary Street N. 56°54' E. 267.3 feet to the place of beginning.

Containing 7.97 acre more or less.


The above described 7.97 acres being part of Florence E. Richardson's 9.21 acre tract.

I hereby certify the above to be a true and accurate description of a survey done by me.


INDEXED ON MAP

4843 ID

LESLIE H. GEESLIN Reg. Surveyor 5248

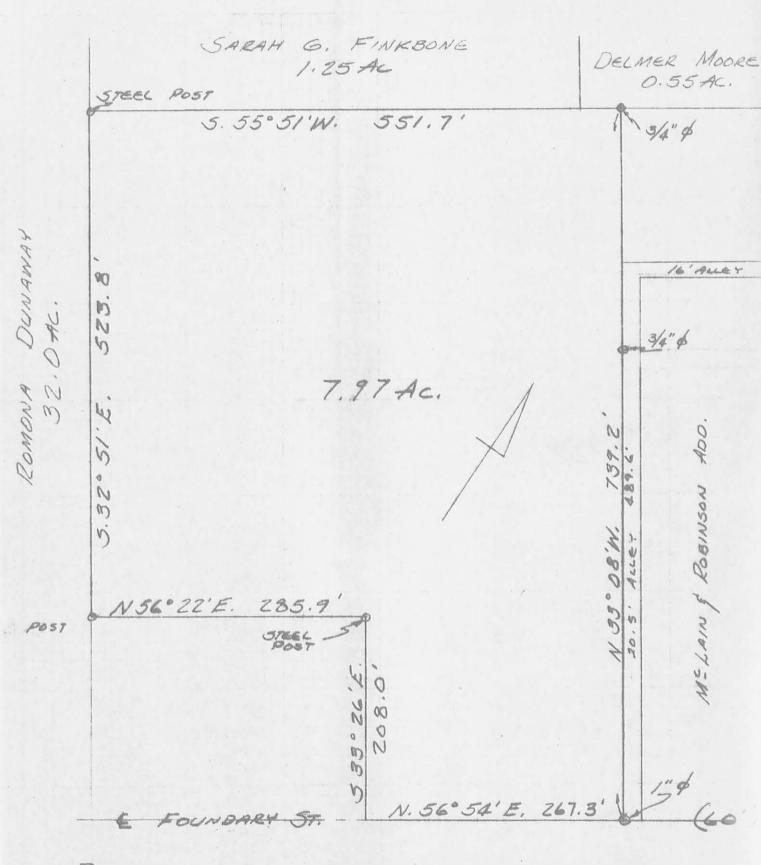

RICHARDSON SURVEY
MAY 15,1971
M.M.S. 4-689
DERRY TOWNSHIP
EAST LIBERTY
LOGAN COUNTY, DHIO

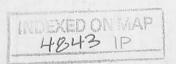

LESLIE H. GEESLIN REG. SURVEYOR 5248