


859

Survey No. 533. ✓
S1°W 113

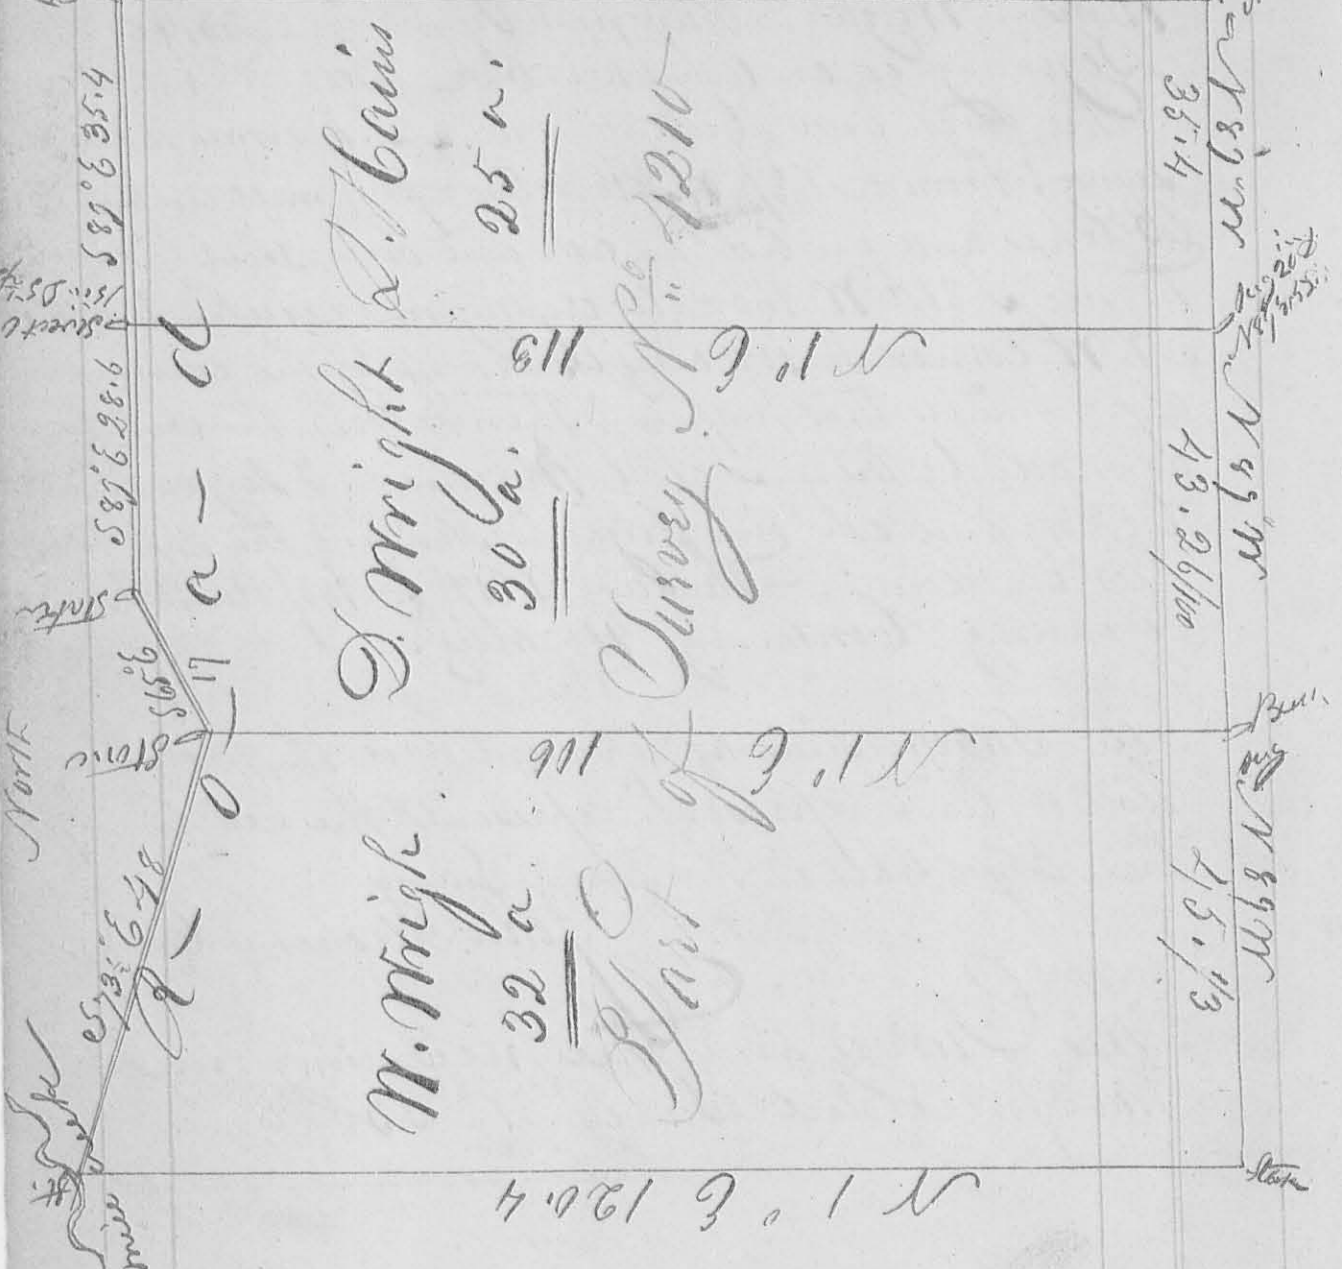

Surveyed and Subdivided part of Survey No. 4210 Sept. 2^d 1844 for William Wright and Others as represented by the annexed Plat.
J. M. Chapman
& Co

Wright & Bain

35.4
W 89 m

43.26 m

45.13
W 89 m

State