


Road 75

7-21-36

46

M. Moore
x 33+52 x
E. C. Morgan

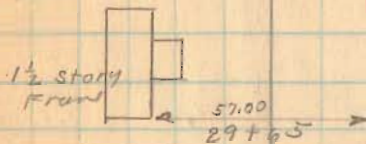

41+00


37+00

33+00

27+00

Concrete Open
Box

Concrete Slab
NO. 75-1.40

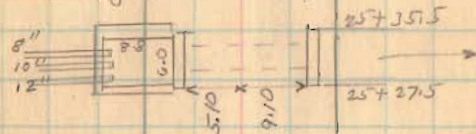

C. A. Young

N. W. Painter

24+26.5
stone found
0'-04' Left



E. C. Morgan

x 23+15 x

Luther H. Paul

1729

INDEXED ON MAP

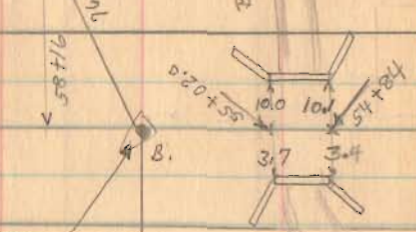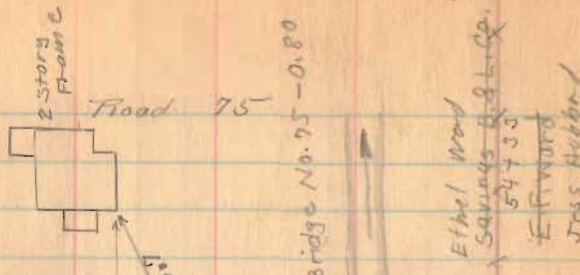

stone found.
57+65
No Angle

Was Not estine.
57+65

C.A. Young

61+00

57+00

51+00

45+00

1729

INDEXED ON MAP



16 Cedar
100.00
E. T. Stabler
Jess Hubbard



43+31
stone found
89+12' left

M.M.
E.T. Stabler

x 42+67 x
M. Moore

95 12
89 12

Flood 95

81+00

95+00

69+00

Produced A.B. to C. Drive Hub at C

67+00

1729

INDEXED ON MAP

7-21-36

±8

Maria Lakin

80+84

D.R. Lakin


← 20.8
98+90 → 12" Walnut

70+99
Hub Placed
0^e 23' left.

→ x x 2 x →

← 25.8
C H. 16W x → 0 Walnut
D.R. Lakin
x 70+99

Ethel Ward

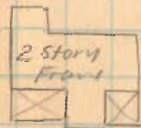

← 77.45
66+02

Road 75

Length 9761 Feet
length 1.84866 Miles
length 1.85 Miles.

97+00 Left Only

93+00

87+00

1729

INDEXED ON MAP

