
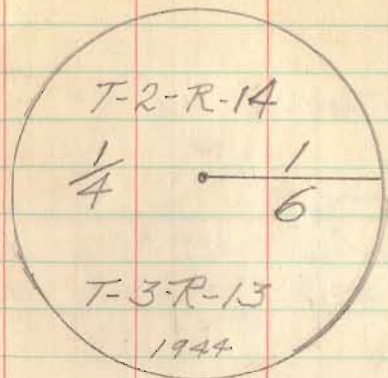


(1)

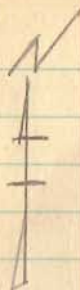


Oct. 9-1944

Dyset  
Robbins  
M<sup>rs</sup>. Adams

Set Concrete Mon. 4' long 5" below  
Surface of road 45.  
Stamped as above.

See Field Book 619 p-10

263

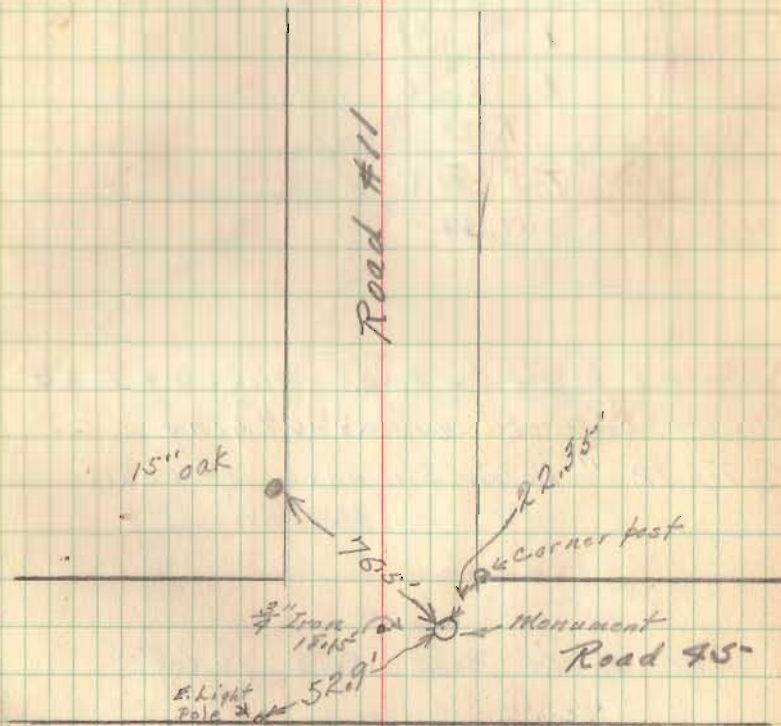

INDEXED ON MAP

2638

Measaut &  
Miami Trps.

INDEXED ON MAP ✓