


A record of the surveys made by the Surveyor of Logan County Ohio.

(8153)

Oct. 19th 1822

✓ Survey No 1

Surveyed for David B. Carpenter. Beginning at the N.E. corner of Section 34 Town 3 Range 14 a white oak 160th links distant 11 inches in diameter, a white oak 138th W 10 links dist. 10 inches in diameter, thence West 40 chains and set a stake, continued to the N.W. corner of said section in a prairie; thence South 80 chains to the S.W. corner of said Sec a white oak 11 inches in diameter 105th E 24 links dist. or 80th W 50 links dist. thence east 40 chains set a stake in the edge of a mill-pond, continued 80 chains to the N.E. corner a white oak 17 inches diam. 153th E 31 links dist. the bearing true at the latter stake area black oak 18 inches diam. or 59th W 39 links dist a white oak 30 in. diam. or 33th E 66 links dist. from this corner 40 chains set a stake continued 80 ch. to the stake set in the first line. returned to the stake in the center a white oak 21 inches diam or 8 links dist thence east 40 chains and covered in the east line of the Sec. an elm divided into 3 trunks 163th E 30 links dist. thence South to the S.E. corner of said Sec. to establish the corners of the South east quarter of Sec 34 Town 3 Range 14 of the 9th Meridian - There being no westerly variation from the original courses.

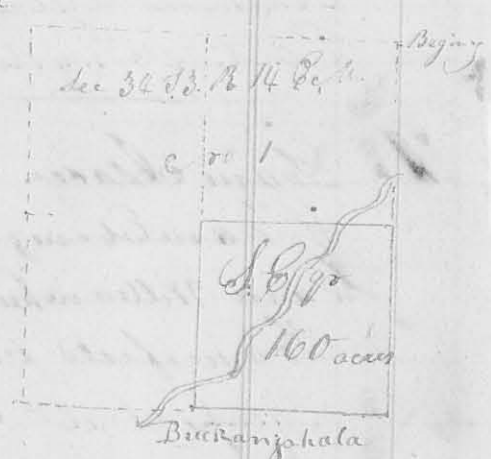

James Binley }
Thomas Powell } C.C.

James M. Harmon
Surveyor of Logan Co.

Decm. 9th 1822.

(8154)

✓ Survey No 2

Surveyed for Jesse Garwood; Beginning at two sugar trees and a beech or 30th W 44 poles from the north east corner of James Calderwood's Survey on the Mad River or 3137 and S.E. corner to said Calderwood's Survey or 3139; thence or 75th W 180 poles to a stone in the Sandusky road; witness trees a sugar tree 168th E 47 links dist. a beech or 43th E 60 links (crossed the Sugar camp branch 90 poles from the beginning and the river at 62 poles) thence or 16th E with said road crossing the River at 8 poles 190 poles to two beeches on said road; thence or 75th E (crossing a Spring branch at 14 poles, the Sugar camp branch at 190 poles 320 poles to