


from present appearance, respecting the Corn. Spruce.
 to plant a stone here, in the westerly line of Northingtons
 Sava Survey. Present as above of Capt. George Hume, Tenn.
 and also Present George Seaman marks a Hickory 7. 10
 N 46 W 1/2 S and Black Oak 12. 10 S 23 1/2 10 1/2 Sinks
 D Hopkins Co. Sur. D. C. O.

A. 375
= 1 =

S 16 1/2 R 14 M. R. S

8408

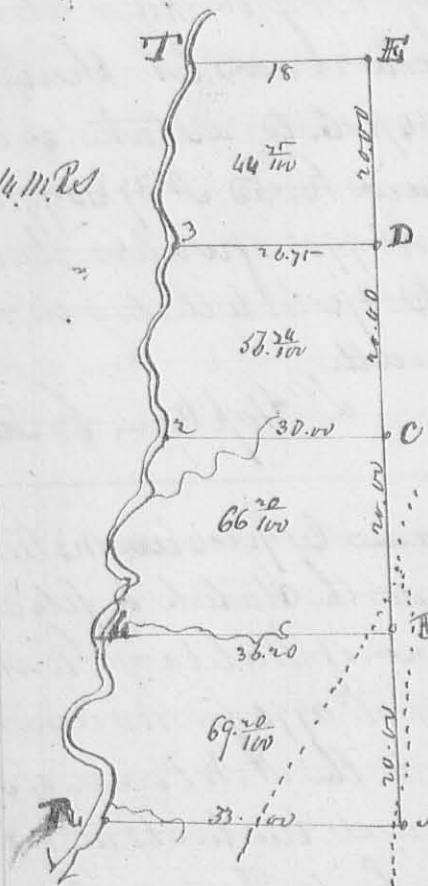

This map represents S 16. 1/2 R 14 M. R. S.
 true meridian course, Present variation
 40. 1/4

Description of Corners
 A. S. E. corner of the section at the oak
 11 1/2 N 49 E 2 1/2 Sinks the other two down
 B. Forked Juniper 10 1/2 P. Corner tree -
 C. Forked Hickory 18 1/2 P. N 80 W 16 1/2 Sinks
 13 1/2 Oak 8 1/2 P. N 5 E 42 Sinks
 D White Oak 10 1/2 P. S 7 W 27 Sinks
 Dogwood 2 ... N 21 W 26 "
 E Wh. Oak 36 1/2 P. S 64 W 27 Sinks the other down
 T R. Oak 18 1/2 P. N 18 E 33 S
 3. Hackberry 15 1/2 P. S 18 W 30 S
 W. Beech 12 1/2 P. N 19 E 14 S

2 - Wh. Oak 15 1/2 P. S 11 W 47 S. Wh. Oak 20 1/2 P. N 45 E 19 Sinks
 1. R. Oak 36 1/2 P. S 14 E 7 S. Ash 7 1/2 P. N 48 W 19 Sinks
 R. R. Oak 36 1/2 P. N 60 W 12 Wh. Oak 15 1/2 P. S 22 W 28 Sinks
 April 5. 1837
 Sur Hopkins Co. Sur. D. C.

A. 376
A.P.
1837

A. D. Seay
S. Seay & others

Survey for S. D. Seay part of Military Survey of
 as follows Beginning at a Red oak and dogwood. then
 N 70 W 86 poles to R. Oak, White oak & Hickory, the Red oak down
 then N 80 E 416 poles to a Wh. O. Hickory, both down, and White Oak
 then S 10 E 82 poles to a Stake in Prairie, then S 79 W 416 poles
 to the beginning. then returned on the last line 70 1/2 poles to 3 beech
 and White Walnut, and on a division line N 10 W 83 1/2 poles
 to a Stake in the north line of said lot - dividing the same into
 two lots of 109.2 acres each
 D Hopkins Co. Sur. S. C.