


S.  $3\frac{1}{2}^{\circ}$  E.  $105\frac{3}{10}$  Poles to a flat stone marked +  
 at Jones S. E. corner, from which a Beech  
 12 Ln. Dir. bears S.  $72\frac{1}{2}^{\circ}$  W. 32 links; a Beech 11 Ln.  
 Dir. N.  $13\frac{1}{2}^{\circ}$  E. 40 links; & an Skonwood  $\frac{3}{4}$  Ln. Dir.  
 N.  $60^{\circ}$  E. 15 links; Thence N.  $87\frac{1}{2}^{\circ}$  E.  $41\frac{3}{10}$  poles  
 to a stone in a County road, near a  
 large stump; Thence N.  $3\frac{1}{2}^{\circ}$  W. with said  
 road, 26 Poles to a stone from which a Beech  
 10 Ln. Dir. bears S.  $87\frac{1}{2}^{\circ}$  E.  $11\frac{1}{2}$  links; Thence  
 N.  $87^{\circ}$  E.  $42\frac{6}{10}$  Poles to a stone at Ezra Stiles  
 S. W. corner, from which an Elm 9 Ln. Dir.  
 bears S.  $51^{\circ}$  E. 50 links, & a W. Oak 11 Ln. Dir.  
 N.  $21^{\circ}$  E. 55 links; Thence N.  $21^{\circ}$  W.  $50^{\circ}$   
 Poles to the place of beginning, containing  
 $48\frac{5}{100}$  Acres

All the afore named witness trees are  
 marked thus 'X' cut in the side facing the  
 corner,

Abel Armstrong  
 & Ezra Stiles } Chain Men  
 I hereby certify that the foregoing plat &  
 report are correct, - J. C. Moore,  
 Co. Sur. of Legab Co. Conn.

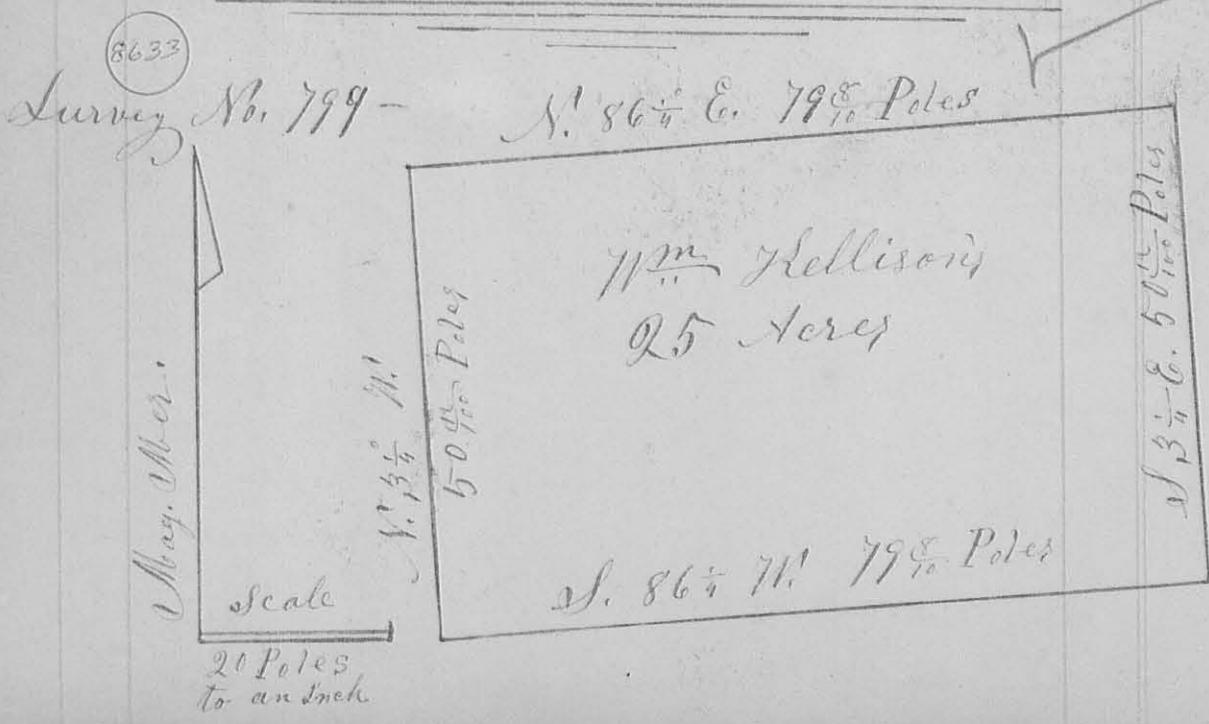

Surveyor's Office Bellefontaine Ohio

Nov. 11<sup>th</sup> A. D. 1858

The plat on the opposite page represents  
 Twenty five acres of land on the North  
 end of the East half, of the South West  
 quarter, of section No. 16 of Town No. 1,  
 and Range No. 8, E. Mer. Me. in Miami Township  
 of Logan County in State of Ohio, as surveyed  
 on the 23<sup>rd</sup> day of October A. D. 1858, by me,  
 H. C. Moore, County Surveyor of Logan County  
 Ohio, at the request of Asalom Chamberly,  
 of said Township, for the purpose of laying  
 off said 25 acres to Wm. Kellison, and  
 establishing the lines and corners thereof  
 (Said Chamberly having deeded said 25 acres  
 to said Kellison prior to said survey.)

Beginning at a Stake at the N. W. corner  
 of said East half, of the S. W. quarter, of section  
 No. 16, Town One & Range 8 from which a Black  
14 Ln. Dir. bears S. 4 $\frac{1}{2}$ ° W. 17 links, and  
 a beech 11 Ln. Dir. N. 59° W. 12 links distant;  
 Thence with the N. line of the sd. S. W.  
 quarter N. 86 $\frac{1}{4}$ ° E. 79 $\frac{3}{10}$  Poles to a stone at  
 the N. E. corner of sd. S. W. quarter from  
 which an Ash 16 Ln. Dir. bears N. 55° W.  
 25 links; Thence with the East line of  
 said quarter, S. 3 $\frac{1}{4}$ ° E. 50 $\frac{4}{100}$  Poles to a stake  
 which I drove at the S. E. corner to the  
 said 25 acres, from which I marked  
 a Forked Logwood, each fork 4 Ln. Dir.  
 bearing South 83 $\frac{1}{2}$ ° W. 32 links, & a Beech  
22 Ln. Dir. S. 82° W. 67 links; Thence S. 86 $\frac{1}{4}$ °  
 W. (marking eight trees fore and aft, with  
 two hicks, & other trees & bushes near the  
 line with a blaze, facing the line)  
 79 $\frac{3}{10}$  Poles to a stake which I planted

at the S. W. corner to the sd. 25 acres,  
 from which I marked a Hickory 9 In.  
 Fir, bearing S.  $54\frac{1}{2}^{\circ}$  E. 16 links, & a Beech  
 18 In Fir, N  $64\frac{1}{2}^{\circ}$  W. 19 $\frac{1}{2}$  links distant; -  
 Thence with the West line of the sd.  
 E. half quarter N.  $3\frac{1}{4}^{\circ}$  W.  $50\frac{00}{100}$  Poles to  
 the place of beginning, containing 25 acres.  
 All the afore named witness trees are  
 marked thus, 'X', cut in the side facing  
 the corner.

Thomas A. Pool }  
 Henry Zimmerman } Chain Men,

I hereby certify that the foregoing  
 plat and report are correct.

H. C. Moore, Cor. Surveyor  
 of Logan Co. W. Va.