

Lot # 49  
Quincy Ohio

HI 109.52  
5.19  
0.39

Top C.B. = 100.00

109.52

F/L C.B. = 94.3

-5.7

6.00

S.E. Cor Bldg. = 100.4

99.46

N.E. Cor Bldg. = 100.3

99.1

N.W. Cor " = 100.4

6.5

Top Inlet = 99.46

-6.5

92.9

F/L Inlet = 92.9

INDEXED ON MAP


2589

Dodson  
Gilbert

2/22/61  
Rain


17

R.R. 7th  
Set

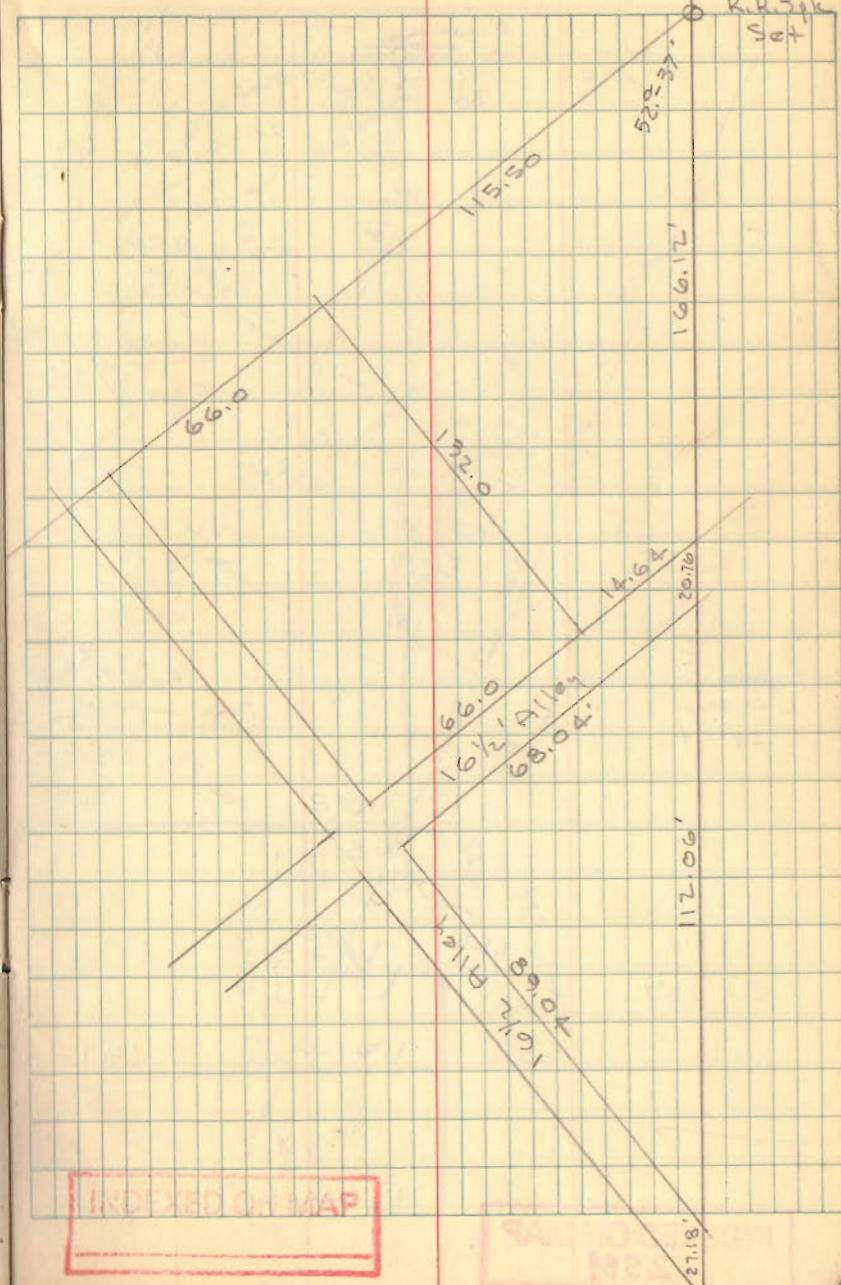

INDEXED ON MAP



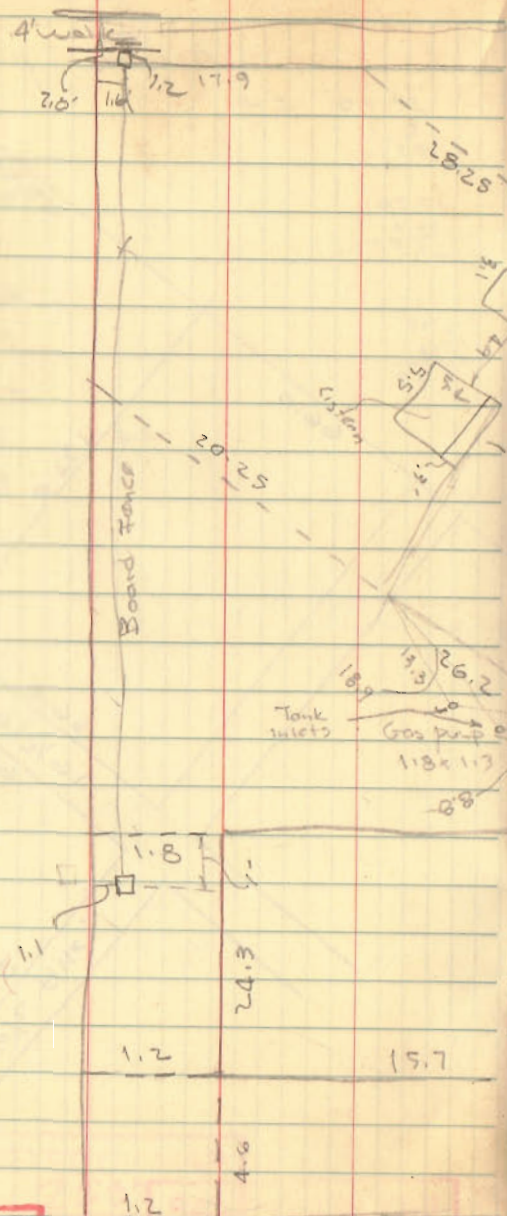

INDEXED ON MAP  
2589

