


Menaca Addition
Quincy Ohio

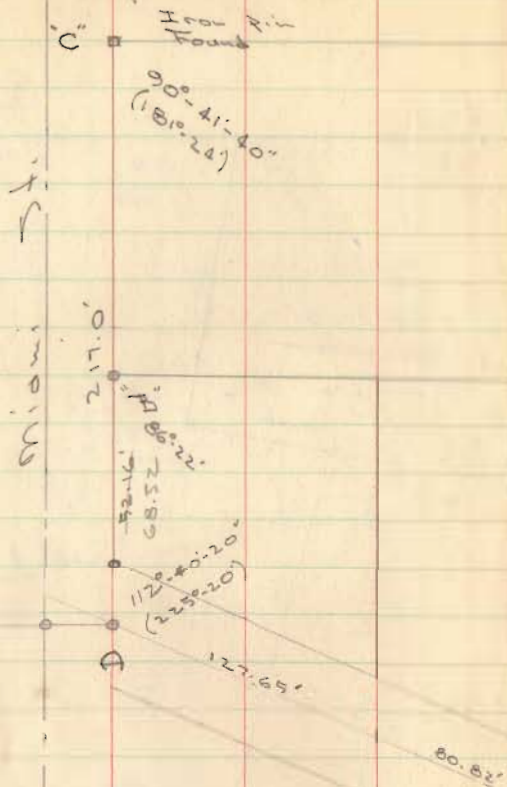


SEE BK 3, PG. 68 - LOT 192

INDEXED ON MAP
3138


D. Dodson
T. Richardson
C. Gebby

Aug. 1954


17

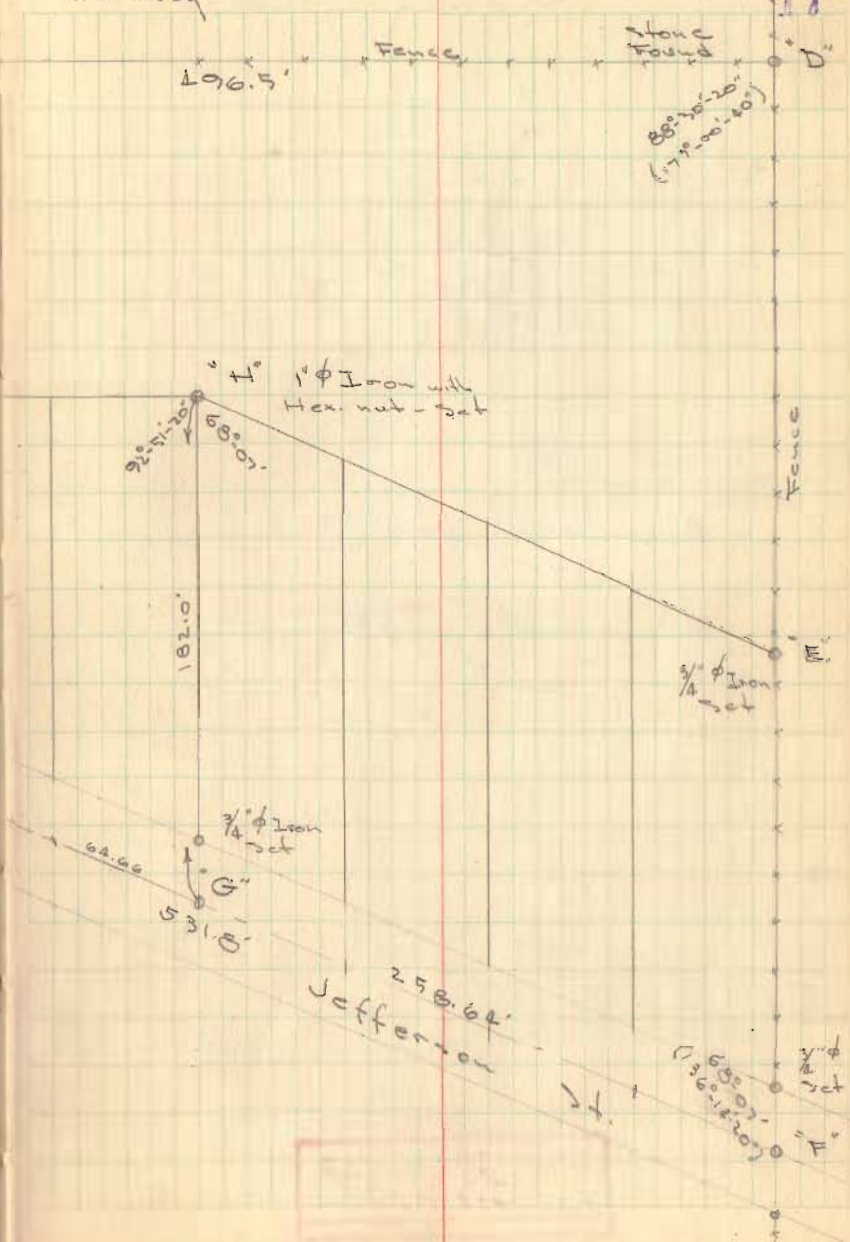

Mercer Add.
Quincy Cont'd

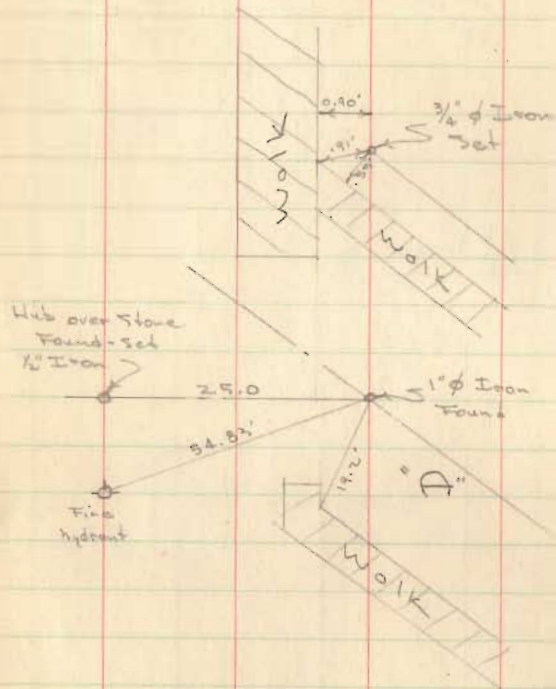


INDEXED ON MAP
3138

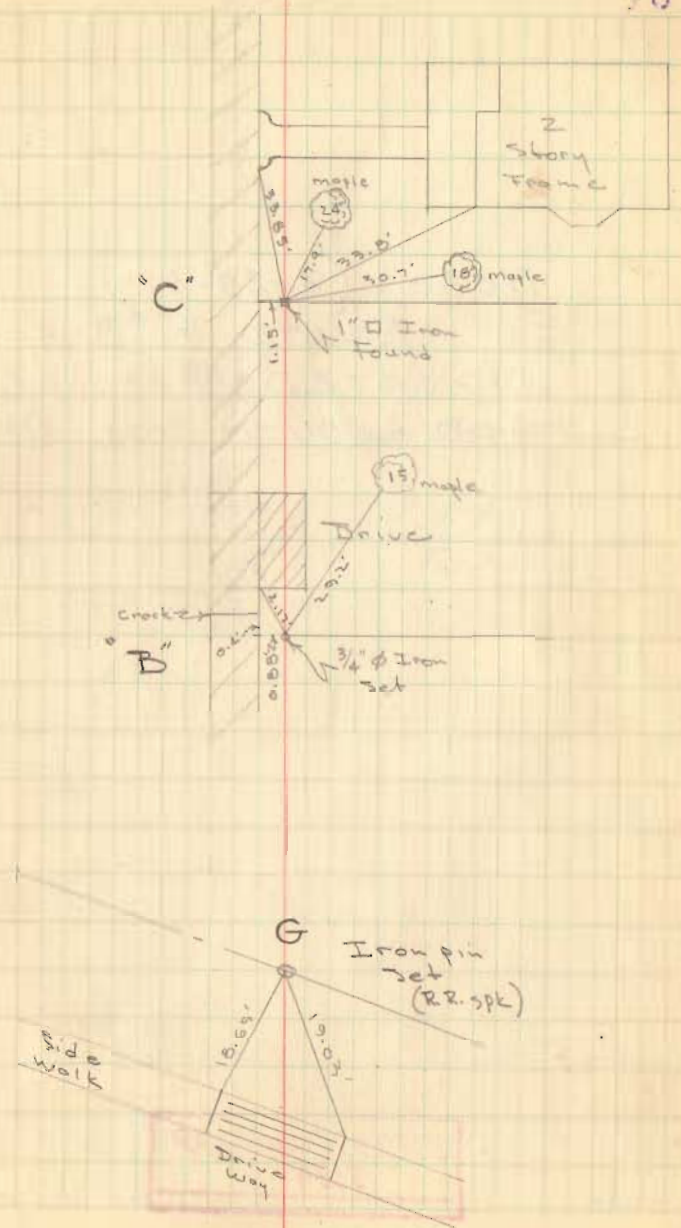

Mercer Add. Quincy
Cont'd

10

NOTE: (4-29-61)
FOUND $\frac{1}{2}$ " ϕ BAR AS
INDICATED - FITS LEACHES
ADD. - SOUTH SIDE OF ST

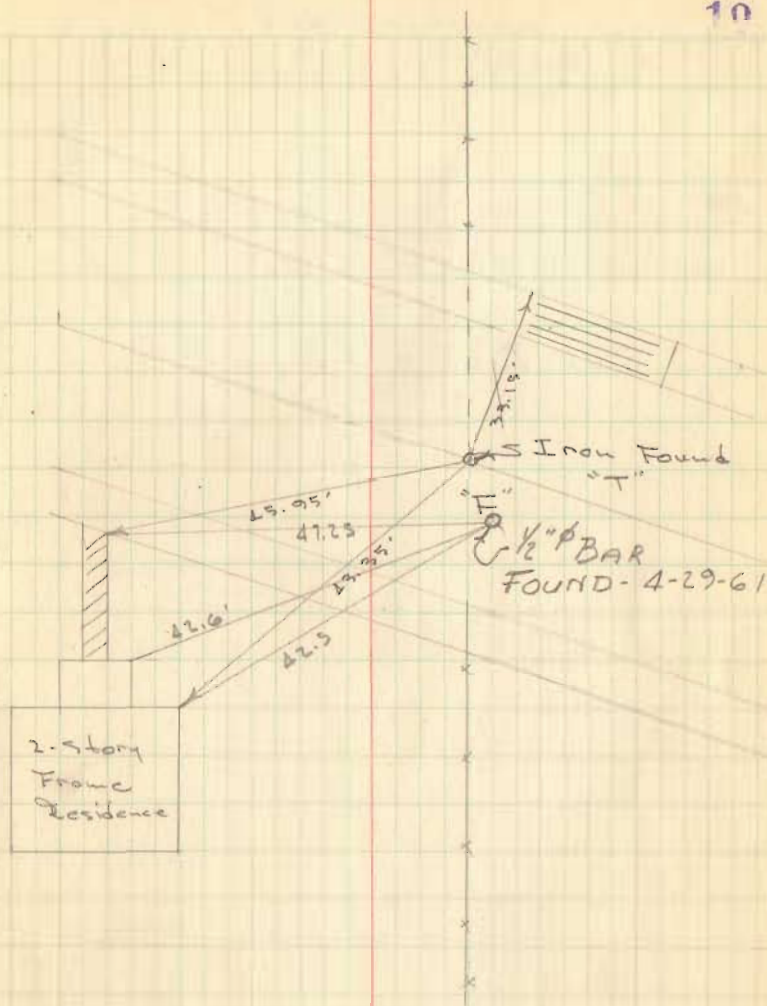

INDEXED ON MAP
3138