

Quincy
Alley between Conby + Miami


July 13, 51

O. Shirk
v. Detrick 77
G. Ricketts

Note: - See Blackley's Addition
to Quincy

See FB 492, pg 59

Over-run in lots 135, 136 + 137;
original plot shows 115.5' frontage
on New St, measured 123.0'
in this survey.

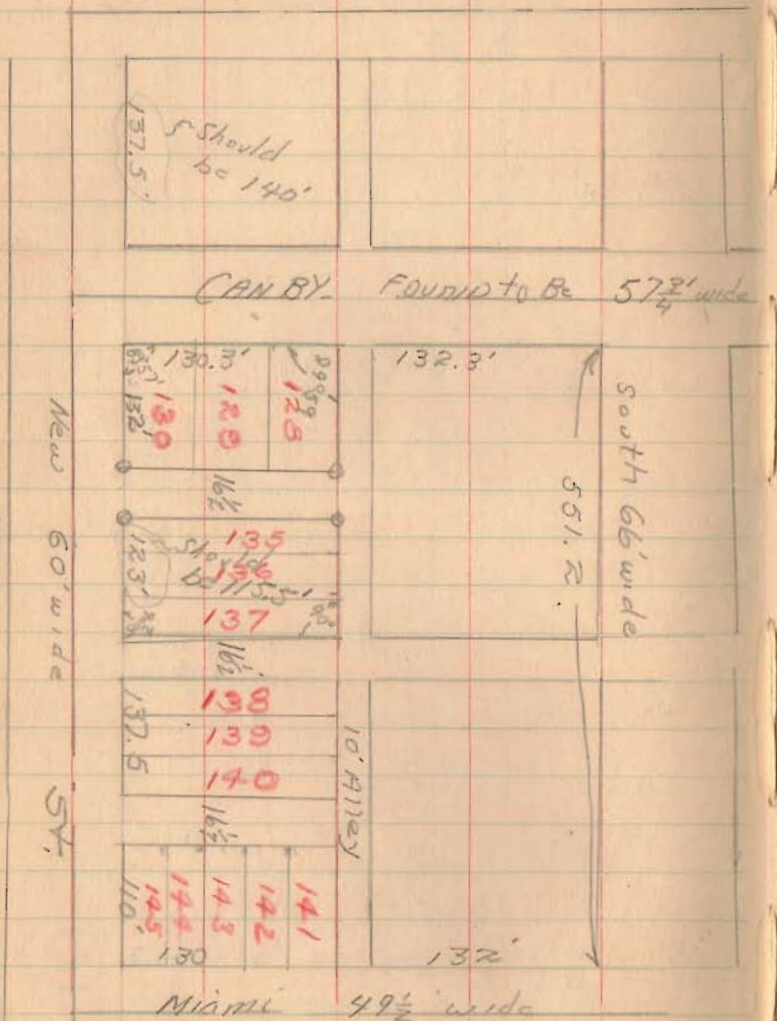

1989

INDEXED ON MAP

o - irons placed