


Survey for O'Connor WAMontgomery
Sept 18 1926 Ed Gore

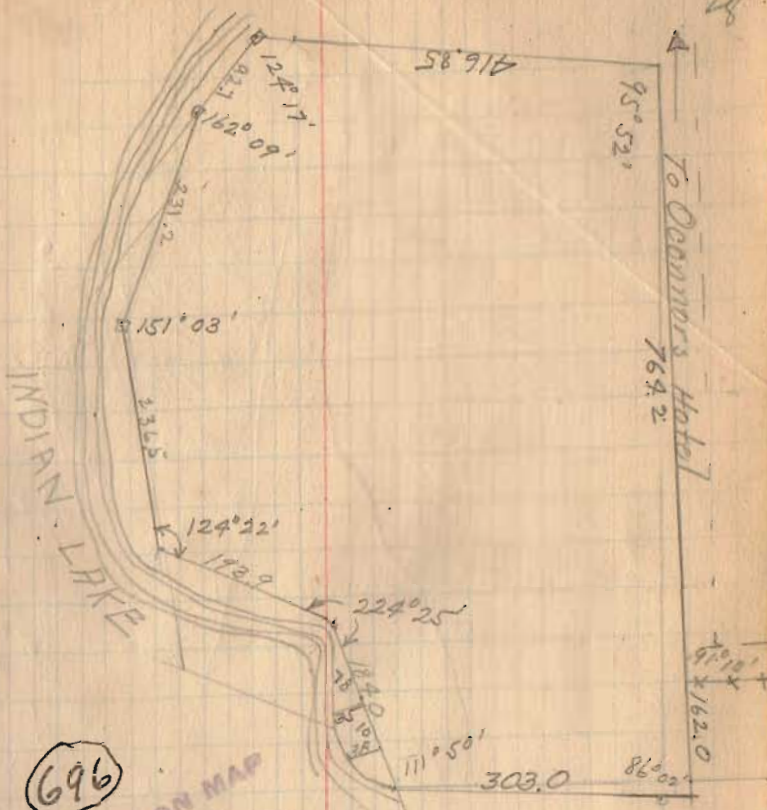

696
INDEXED ON MAP