



See Drawer R

(717)

INDEXED ON MAP


MLN  
8558  
455.8

N51W  
259.7  
42.17  
48.17  
46.57

N 45° 0'  
3447.2  
582 3/4 W

90° 15'  
46.57  
75.24

90° 41'  
90° 05'

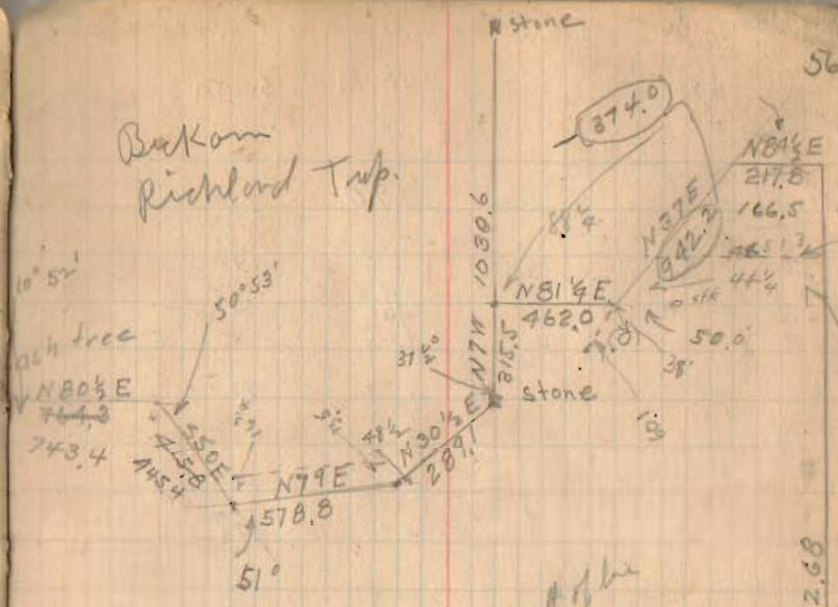

12° 48' at close to 10 ft of line

3077.8  
3678.9  
582 1/2 W  
7  
78 1/2

80° + 21'

57E 3032.68