

S. R. McCracker

N 83° E
25.53

A. Roebuck

Cement Post

1P

983

1P

LANDS OF

L.T. ^{2nd} C.A. EMERY

AS DEEDED TO THEIR CHILDREN

JUNE 23, 1916

SURVEY 9970

RICHLAND TOWNSHIP

LOGAN COUNTY

OHIO

Book D Page 68

Mary G. Dunn

N 7 1/2 W
41.87

I. B. Johnston
- and -
Ada L. Johnston
132.07 a.

Cement Post

8.59

S 83 1/2 W
13.43 Gas Pipe

20.47

Myra Leasure
N 7 1/4 W

J. M. Liggitt
- and -
Cecil M. Liggitt
127.07 a.

D

Bar

224

N 7 W

12.07

Post

Byron Corners

N 83 E

25.35

R. F. Elder
- and -
Nellie E. Elder

130.45 a.

Stone

51.85

Roebrick

R. S. Kitcher

S 6 1/2 E

Stone

25.07

S.E. Corner of Survey 9970

A II 25.25

Bridge

B

E

miami

River

Ditch

Cook

Bar

A

S 83 1/4 W

25.07

Stone

B

Bar

A

B-23

B-23

LESLIE H. GEESLIN

REGISTERED SURVEYOR NO. 5248

P. O. BOX 274

RUSHSYLVANIA, OHIO 43347

PHONE: (513) 468-2793

YODER TO MILLER SURVEY

May 23, 1977

The following described real estate situated in the State of Ohio, County of Logan, Township of Richland and being part of Virginia Military Survey No. 9970 and being more particularly described as follows:

Beginning at an iron bar at a southwesterly corner of Benjamin J. Miller's 132.07 acre tract as described in D. B. Vol. 352 page 183; thence with said Miller's south line N. $82^{\circ} 00'$ E. 796.80 feet to a $\frac{1}{2}$ " pipe in the west line of Wallace Byler's 129.67 acre tract as described in D. B. Vol. 352 page 853; thence with said Byler's west line S. $7^{\circ} 18.3'$ E. 63.00 feet to a $\frac{1}{2}$ " pipe; thence S. $82^{\circ} 00'$ W. 796.72 feet to a $\frac{1}{2}$ " pipe in a westerly line of said Benjamin J. Miller projected; thence with said projected line N. $7^{\circ} 22.5'$ E. 63.00 feet to the place of beginning.

Containing 1.15 acres more or less.

The above described 1.15 acres being on the north end of the east side of Eldon T. Yoder's 125.81 acre tract as described in D. B. Vol. 364 page 439.


Reference is hereby made to a plat of this description on file with the Logan County Engineer.

I hereby certify that the above is a true and accurate description of a survey made by me.

Leslie H. Geeslin

INDEXED ON MAP
983

2D

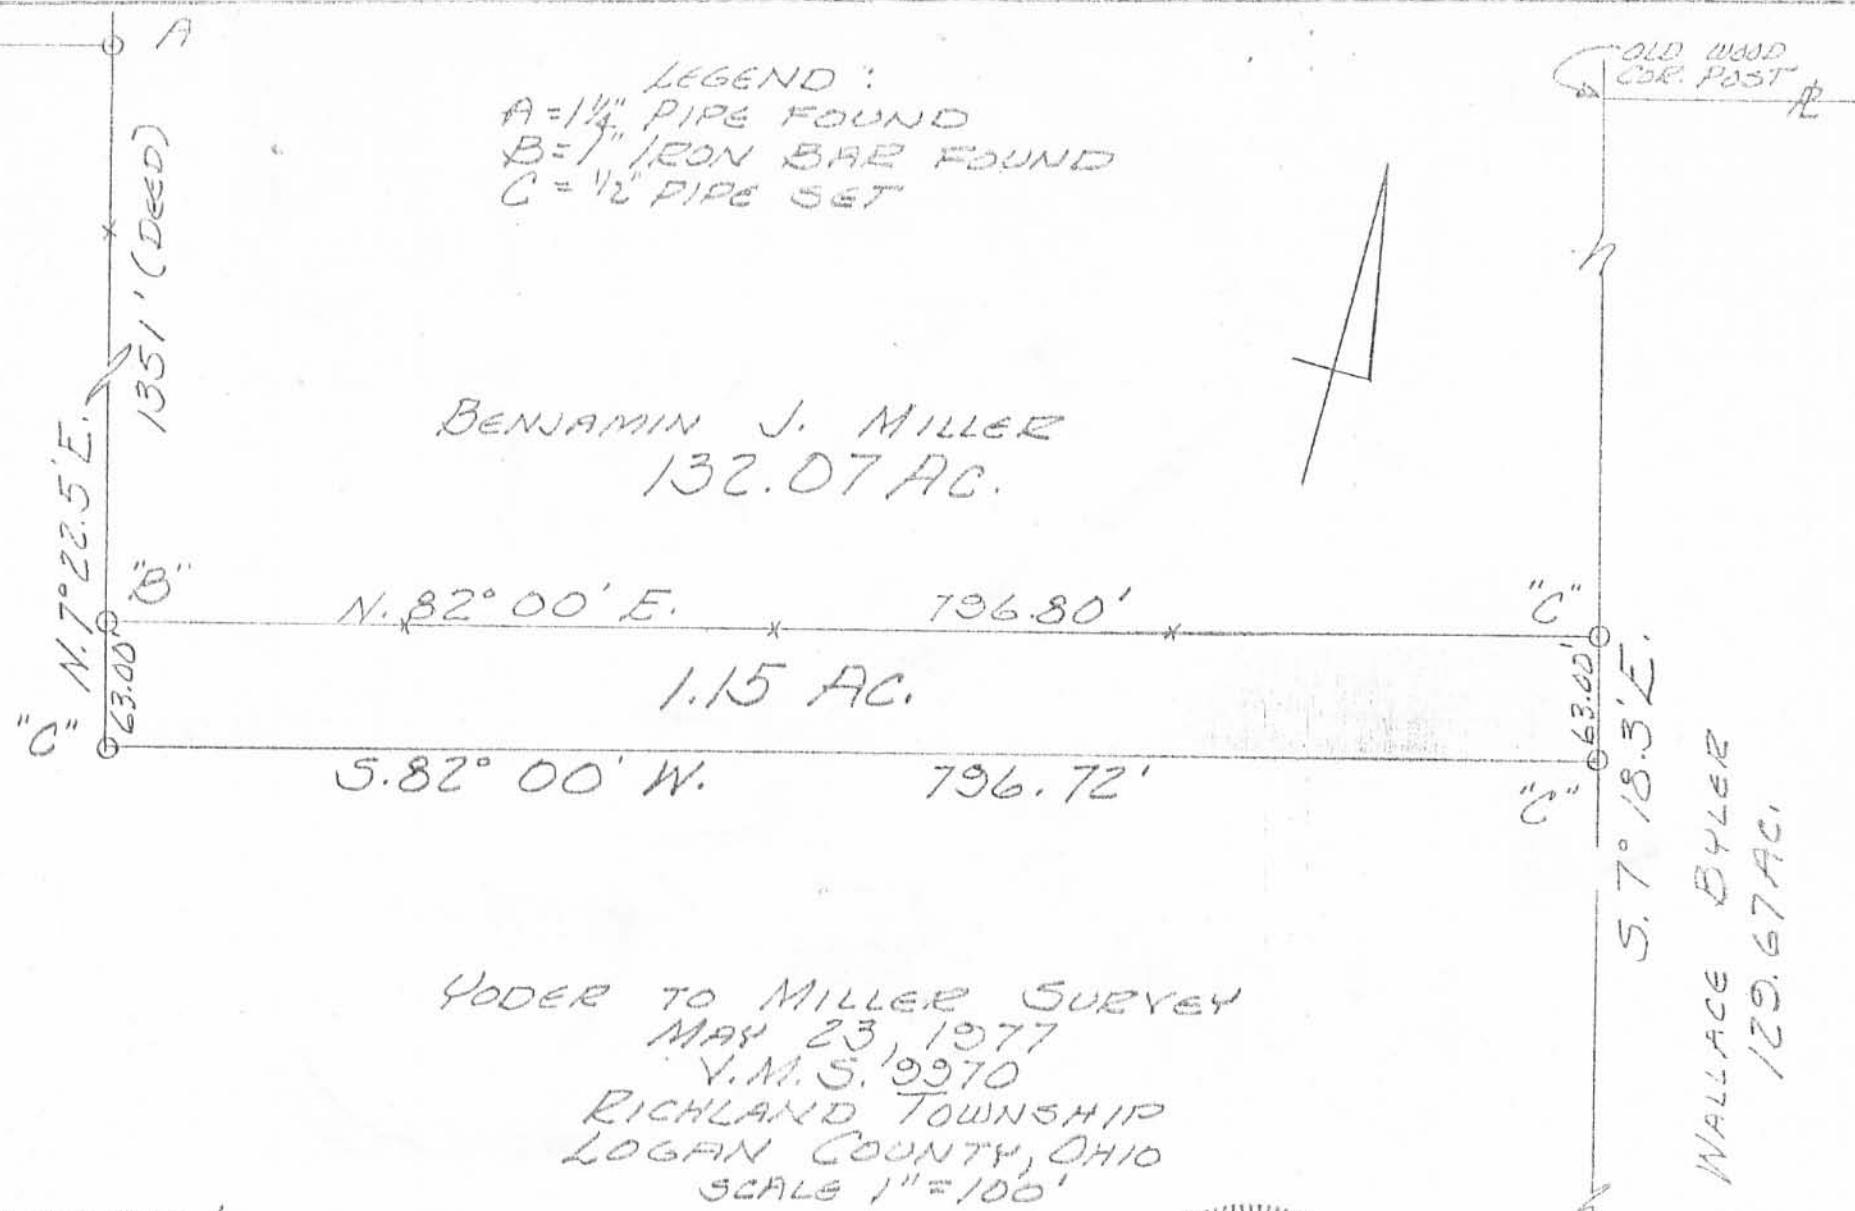

YODER TO MILLER SURVEY
 MAY 23, 1977
 V.M.S. 9970
 RICHLAND TOWNSHIP
 LOGAN COUNTY, OHIO
 SCALE 1"=100'

REFERENCE:

- DRAWER "R" 983
- D.B. VOL. 352 PG. 183
- D.B. VOL. 352 PG. 853
- D.B. VOL. 364 PG. 430

INDEXED ON MAP
 983

2P



LESLIE H. GEESLIN
 REG. SURVEYOR 5248
 DUSK SURVEYING CO., INC.

OLD WOOD
 POST ON
 N. SIDE MAMI
 DIVERT.

REC'D 3-3-95 SWJ OK ✓

LESLIE H. GEESLIN
REGISTERED SURVEYOR 5248
P. O. BOX 274
RUSHSYLVANIA, OHIO 43347
TELEPHONE: (513) 468-2793

MILLER SURVEY

February 17, 1995

The following described real estate situated in the State of Ohio, County of Logan, Township of Richland being part of Virginia Military Survey 9970 and more particularly described as follows:

Beginning at a 1/2 inch iron pipe found at the southwest corner of Benjamin Miller's 1.15 acre tract as described in D. B. Vol. 375 Page 534.

Thence with the south line of said 1.15 acre tract N. 82° 00' 00" E. 796.72 feet to a 1/2 inch iron pipe found in the west line of Paul Byler's 126.837 acre tract as described in D. B. Vol. 398 Page 566.

Thence with said Byler's west line S. 7° 18' 18" E. 50.00 feet to a 5/8 inch iron bar set.

Thence S. 82° 00' 00" W. 796.66 feet to a 5/8 inch iron bar set.

Thence N. 7° 22' 30" E. 50.00 feet to the place of beginning.

Containing 0.914 acre more or less.

The above described 0.914 acre tract being part of Eldon Yoder's 125.81 acre tract as described in D. B. Vol. 364 Page 439.

Bearings are based on an assumed bearing (N. 82° 00' 00" E.) for the south line of Benjamin Miller's 1.15 acre tract as described in D. B. Vol. 375 Page 534 in this field survey by Leslie H. Geeslin, Reg. Surveyor 5248 on February 17, 1995



RI A:\09\MILLER.SAM

Leslie H. Geeslin

INDEXED ON MAP
983

3 D

N. 7° 22' 30" E.

BENJAMIN J. MILLER
132.07 AC.
D.B. VOL. 352 PG 183

1.15 AC.

D.B. VOL. 375 PG. 534

N. 7° 22' 30" E.

N. 82° 00' 00" E.

796.72'

B

S. 82° 00' 00" W.

796.66'

A

0.914 AC.

A
B
S. 7° 18' 18" E.


ELDON T. YODER
125.81 AC.
D.B. VOL. 364 PG 439

PAUL BYLER
126.837 AC
D.B. VOL. 398 PG 566

SURVEY OF 0.914 ACRE TRACT
IN VIRGINIA MILITARY SURVEY
9970, RICHLAND TOWNSHIP,
LOGAN COUNTY, OHIO FOR
BENJAMIN MILLER.

FEBRUARY 17, 1975

SCALE: 1" = 100'

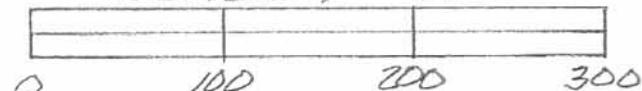

LEGEND:

A = 1/2" IRON PIPE FOUND

B = 9/8" IRON BAR SET



Leslie H. Geeslin

LESLIE H. GEESLIN
RUSHSYLVANIA, OHIO
PH 513-468-2793

JP

INDEXED ON MAP
J83

Received 6-8-99 OK JAH

LESLIE H. GEESLIN
REGISTERED SURVEYOR 5248
P. O. BOX 274
RUSHSYLVANIA, OHIO 43347
TELEPHONE: (937) 468-2793

MILLER SURVEY

September 24, 1997

The following described real estate situated in the State of Ohio, County of Logan, Township of Richland, being part of Virginia Military Survey 9970, and more particularly described as follows:

Beginning at a 5/8 inch iron bar found at the southwest corner of Benjamin J. Miller, etux's 0.914 acre tract as described in O. R. Vol. 254 Page 116.

Thence with said Miller's south line N. 82° 00' 00" E. 796.45 feet to a 5/8 inch iron bar found in the west line of Paul Byler's 126.837 acre tract as described in D. B. Vol. 398 Page 566.

Thence with said Byler's west line S. 7° 18' 18" E. 30.08 feet to a 5/8 inch iron bar set.

Thence S. 82° 00' 00" W. 796.41 feet to a 5/8 inch iron bar set.

Thence N. 7° 22' 30" W. 30.08 feet to the place of beginning.

Containing 0.550 acre more or less.


The above described 0.550 acre tract being part of Eldon T. Yoder's 125.81 acre tract as described in D. B. Vol. 364 Page 439.

Bearings are based on an assumed bearing N. 82° 00' 00" E. for the south line of Benjamin Miller's 0.914 acre tract in this field survey by Leslie H. Geeslin, Reg. Surveyor # 5248 on September 24, 1997.



Leslie H. Geeslin

INDEXED ON
983

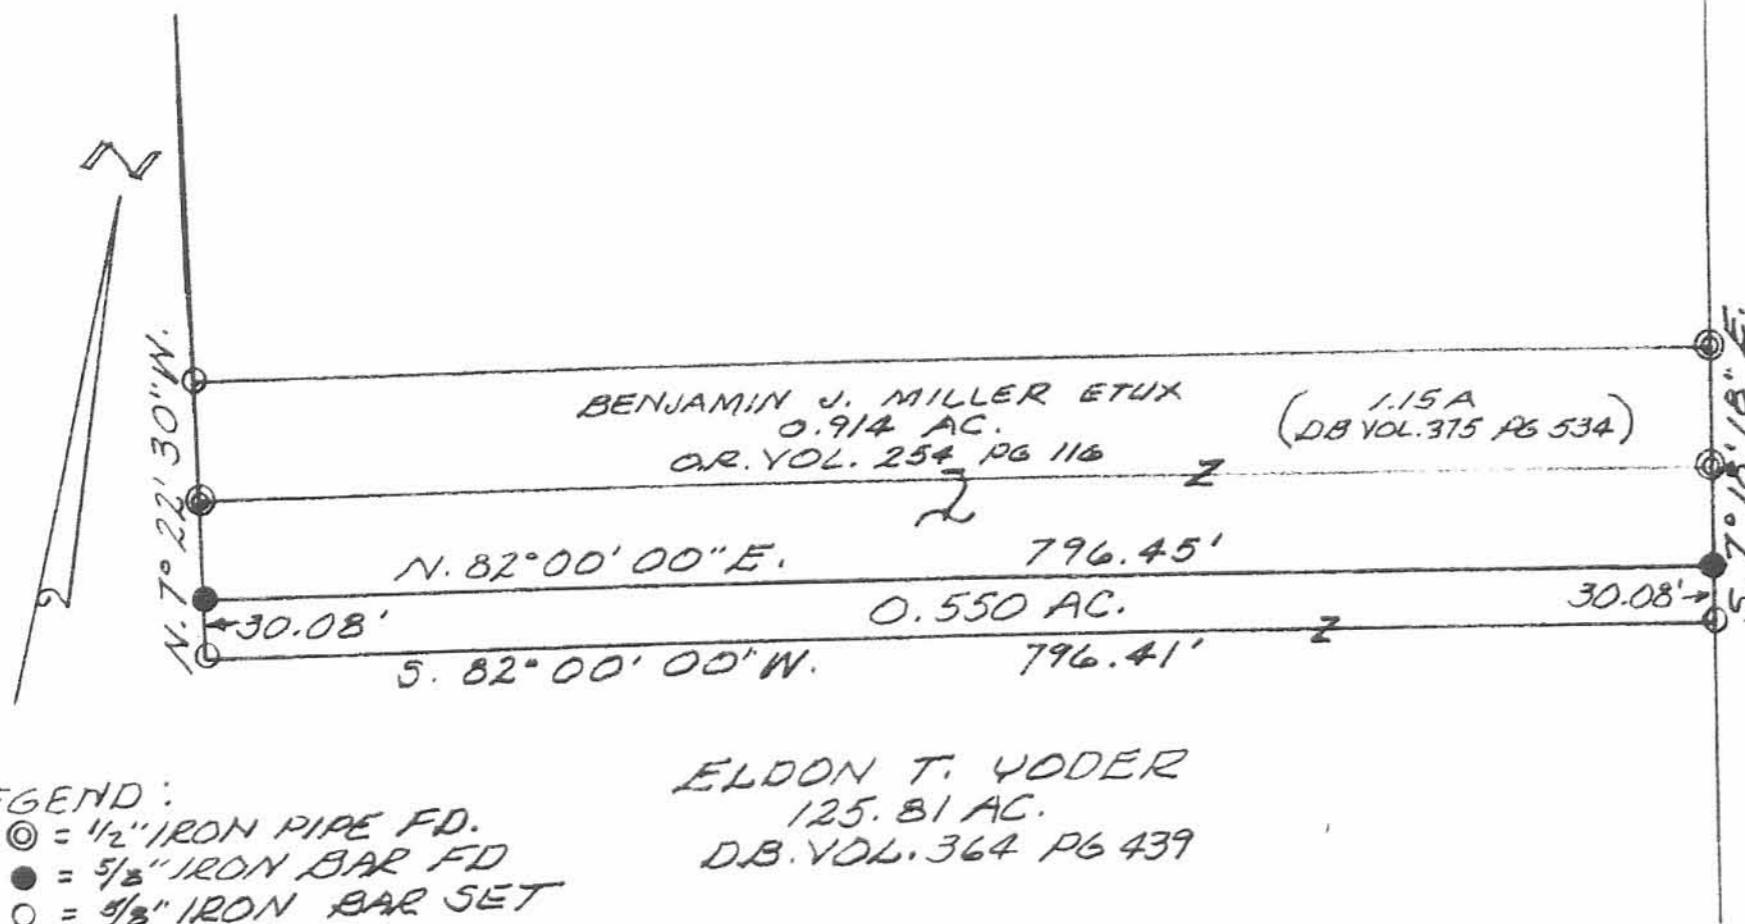


ELDON T. YODER
 125.81 AC.
 D.B. VOL. 364 PG 439

PAUL BYLGER
 126.837 AC.
 D.B. VOL. 398 PG 566

SURVEY OF 0.550 ACRE TRACT
 IN Y.M.S. 9970, RICHLAND TOWNSHIP,
 LOGAN COUNTY, OHIO FOR BENJAMIN
 MILLER.

SEPTEMBER 24, 1997
 SCALE: 1" = 100'

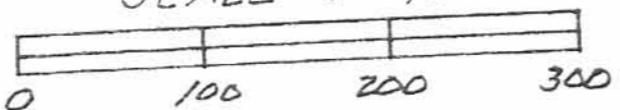

Leslie H. Geeslin
 LESLIE H. GEESLIN
 RUSHCYSYLVANIA, OHIO
 PH 937-468-2793

INDEXED ON MAP
 983