

Road. 254  
O'Connor Road  
Richland Twp.


{ see Book 500 Page 7<sup>9</sup>/<sub>8</sub>  
for old survey Before change

Stakes placed 25' from  $\perp$  for a 50' Road

1374  
INDEXED ON MAP

May - 4 - 1932  
Rainy  
Wright  
McKerahan

37

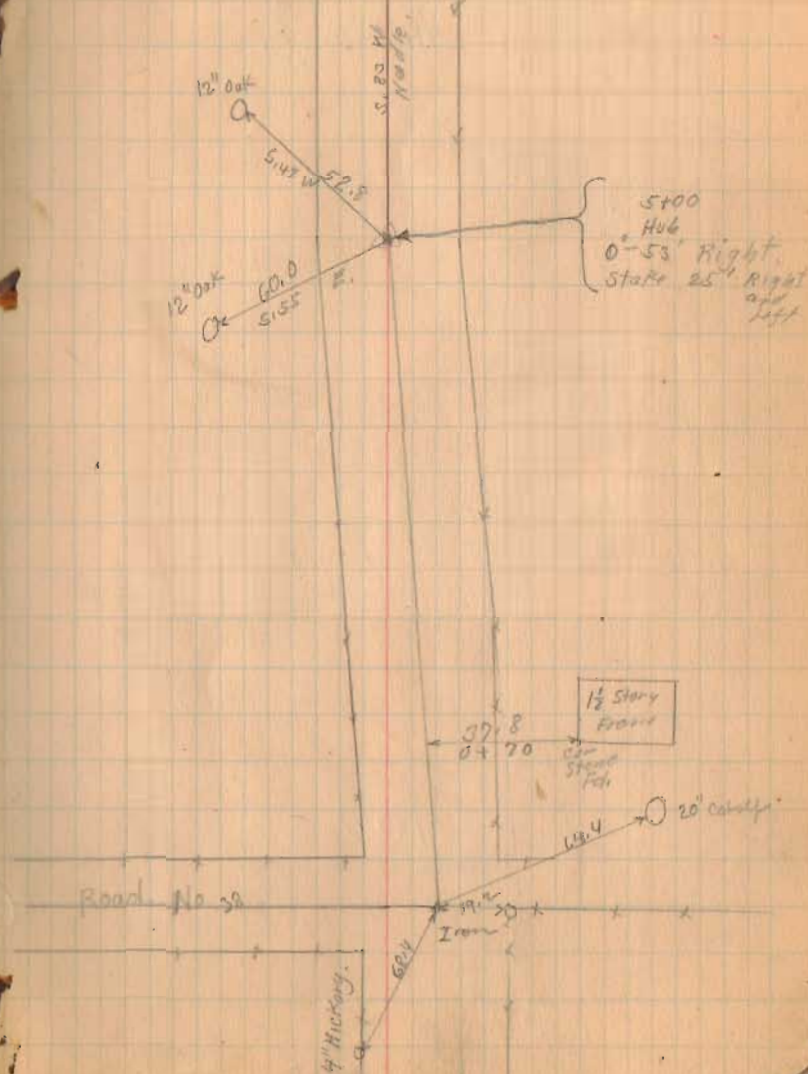

Road 254

See Print J-6 for Lots  
in O'Connor's Allotment.

1374  
INDEXED ON MAP

