
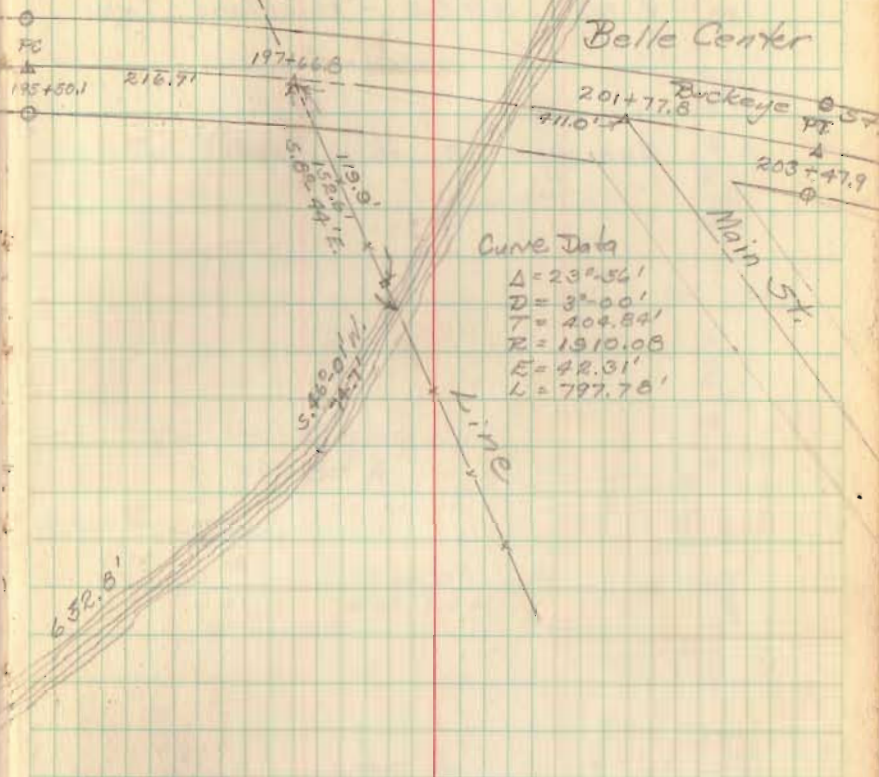


Survey for  
B+D Manufacturing Co  
from Wm. Ramsey

VMS 9989  
Richland Twp.

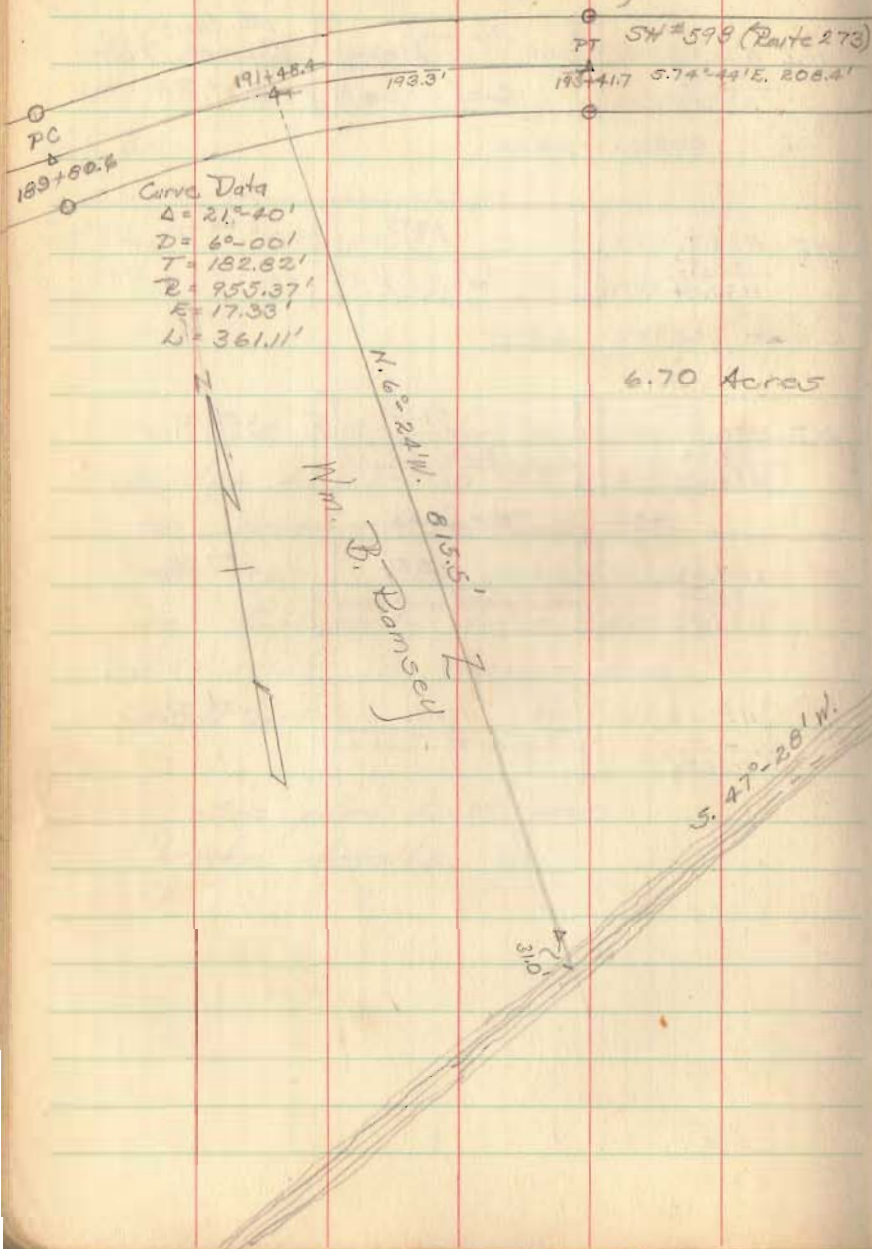

- - R/W Monuments
- △ - Iron pins
- - Wooden hub

Party June 1950  
C. Keyser  
D. Dodson  
J. Detrick  
B. South  
E. Care Jr.

See Plan L-13 pg 5  
for SH 593 (Route 273)

2056

INDEXED ON MAP