The following described real estate located in the Township of Richland, County of Logan, State of Ohio and being a part of Virginia Military Survey No.

9988 and being more particularly described as follows:


Beginning at an iron bar, the Northeast corner of Wendall E. Thaxton's 18.23 Acre tract and the Southeast corner of John Ivan Stout's 19.24 Acre tract and in the center line of C. H. No. 97; Thence S. 26° 15' E. 508.65 feet, with said center line of C. H. No. 97, to an iron bar; Thence S. 84° 30' W. 410.00 feet, passing through an iron bar at 30.54 feet (30.00 feet if measured at right angles) to an iron bar; Thence N. 5° 30' W. 475.65 feet to an iron bar set in the line between Thaxton and Stout; Thence with their said line, N. 84° 30' E. 230.94 feet, passing an iron bar at 200.40 feet, to the place of beginning, containing 3.50 Acres, more or less.

This parcel being taken from a 18.23 Acre tract of land in the name of Wendall E. Thaxton etux.

I hereby certify that this a true and accurate description of a survey made by me on December 16, 1967.

Daniel E. Gilbert Reg. Sur. No. 5402

> 1D 1166

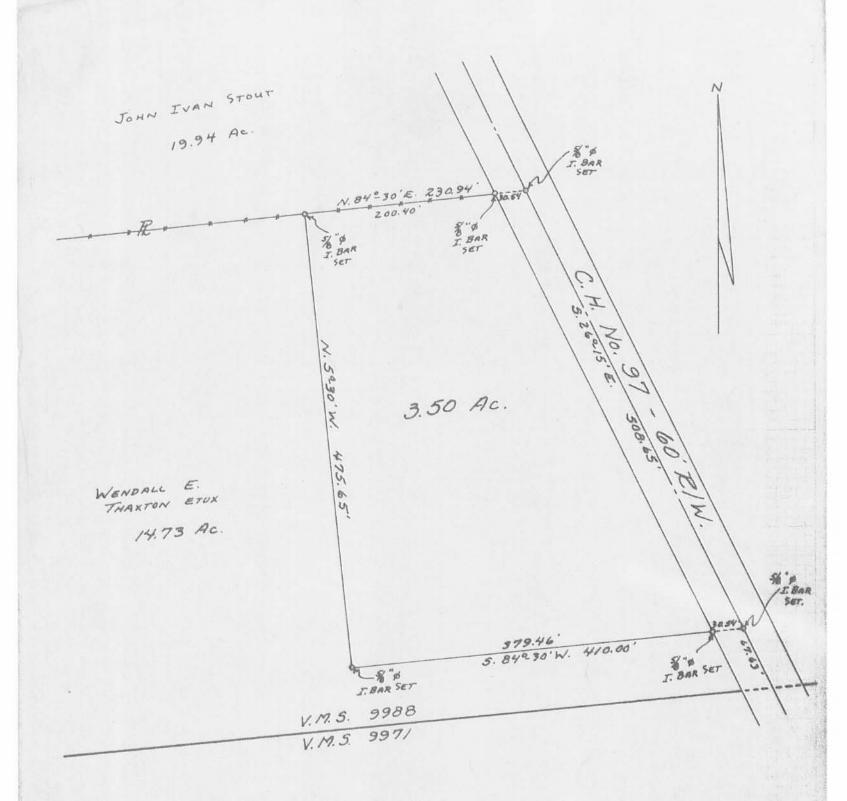



THAXTON-STOUT SURVEY
VIRGINIA MILITARY SURVEY 3988

RICHLAND TOWNSHIP

LOGAN COUNTY, OHIO

DECEMBER 16, 1967

SCALE: 1"= 100"

1P 4166

INDENED ON MAR

SURVEYED AND PLATTED BY: DANIEL E. GILBERT, REG. SUR. No. 5402