

Received 7-15-87

OK (C.R)

LESLIE H. GEESLIN  
REGISTERED SURVEYOR NO. 5248  
P O. BOX 274  
RUSHSYLVANIA, OHIO 43347

TELEPHONE: (513) 468-2793

STOUT SURVEY

July, 1987

The following described real estate situated in the State of Ohio, County of Logan, Township of Richland, being part of Virginia Military Survey 9988 and more particularly described as follows:

Beginning at a railroad spike at the northeast corner of Lois Taylor's 0.93 acre tract in the centerline of County Highway 97 that is S.  $25^{\circ} 49'$  E. 283 feet from the northeast corner of J. Ivan Stout's 15.92 acre tract as described in D.B. Vol. 199 Page 263 (said bearings is taken from D.B. Vol. 354 Page 10 and all other bearings are from angles and distances measured in this field survey).

THENCE with said Taylor's north line and said line projected S.  $85^{\circ} 41'$  W. 677.38 feet to a 0.625 inch iron bar, passing 0.625 inch iron bars at 32.24 feet and 270.00 feet.

THENCE S.  $1^{\circ} 42' 36''$  E. 170.50 feet to a 0.625 inch iron bar.

THENCE S.  $84^{\circ} 31' 12''$  W. 156.06 feet to a 0.625 inch iron bar.

THENCE N.  $5^{\circ} 07' 06''$  W. 152.40 feet to a 0.625 inch iron bar.

THENCE S.  $84^{\circ} 52' 54''$  W. 34.97 feet to a 0.625 inch iron bar.

THENCE N.  $3^{\circ} 34'$  W. 88.08 feet to a 0.625 inch iron bar.

INDEXED ON MAP  
5629 ID-1

THENCE N.  $87^{\circ} 21' 12''$  E. 48.42 feet to a 0.625 inch iron bar.

THENCE N.  $7^{\circ} 08' 42''$  E. 45.46 feet to a 0.625 inch iron bar.

THENCE N.  $80^{\circ} 55' 48''$  E. 120.57 feet to a 0.625 inch iron bar.

THENCE S.  $31^{\circ} 04' 35''$  E. 108.04 feet to a 0.625 inch iron bar

THENCE N.  $85^{\circ} 41'$  E. 641.75 feet to a railroad spike in the centerline of C.H. 97.

THENCE with said centerline s.  $25^{\circ} 49'$  E. 24.87 feet to the place of beginning.


Containing 1.484 acres more or less.

The above described 1.484 acre tract being part of J. Ivan Stout's 15.92 acre tract as described in D.B. Vol. 199 Page 263.



*Leslie H. Geeslin*

INDEXED ON MAP  
5629 ID-2

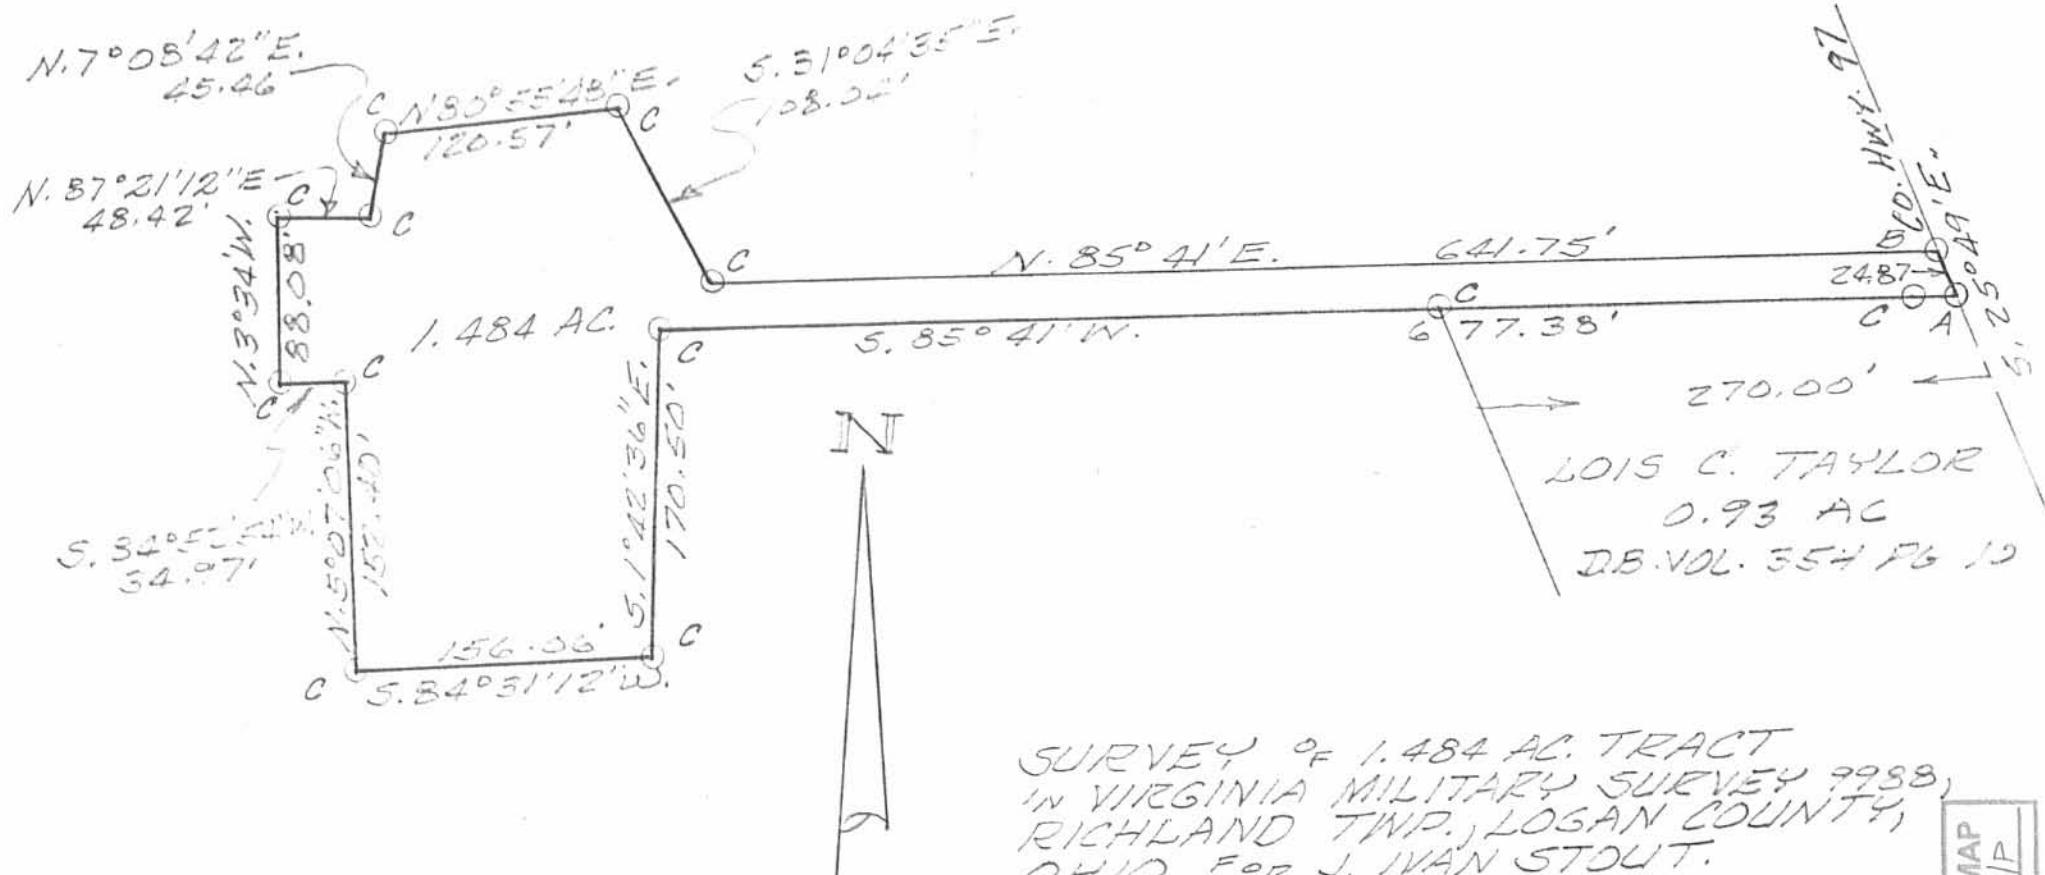


LEGEND :

A = R.R. SPIKE FOUND  
 B = R.R. SPIKE SET  
 C = 5/8" IRON BAR SET

SURVEY OF 1.484 AC. TRACT  
 IN VIRGINIA MILITARY SURVEY 9988,  
 RICHLAND TWP., LOGAN COUNTY,  
 OHIO FOR J. IVAN STOUT.



Leslie H. Geeslin  
 LESLIE H. GEESLIN  
 RUSHSYLVANIA, OHIO

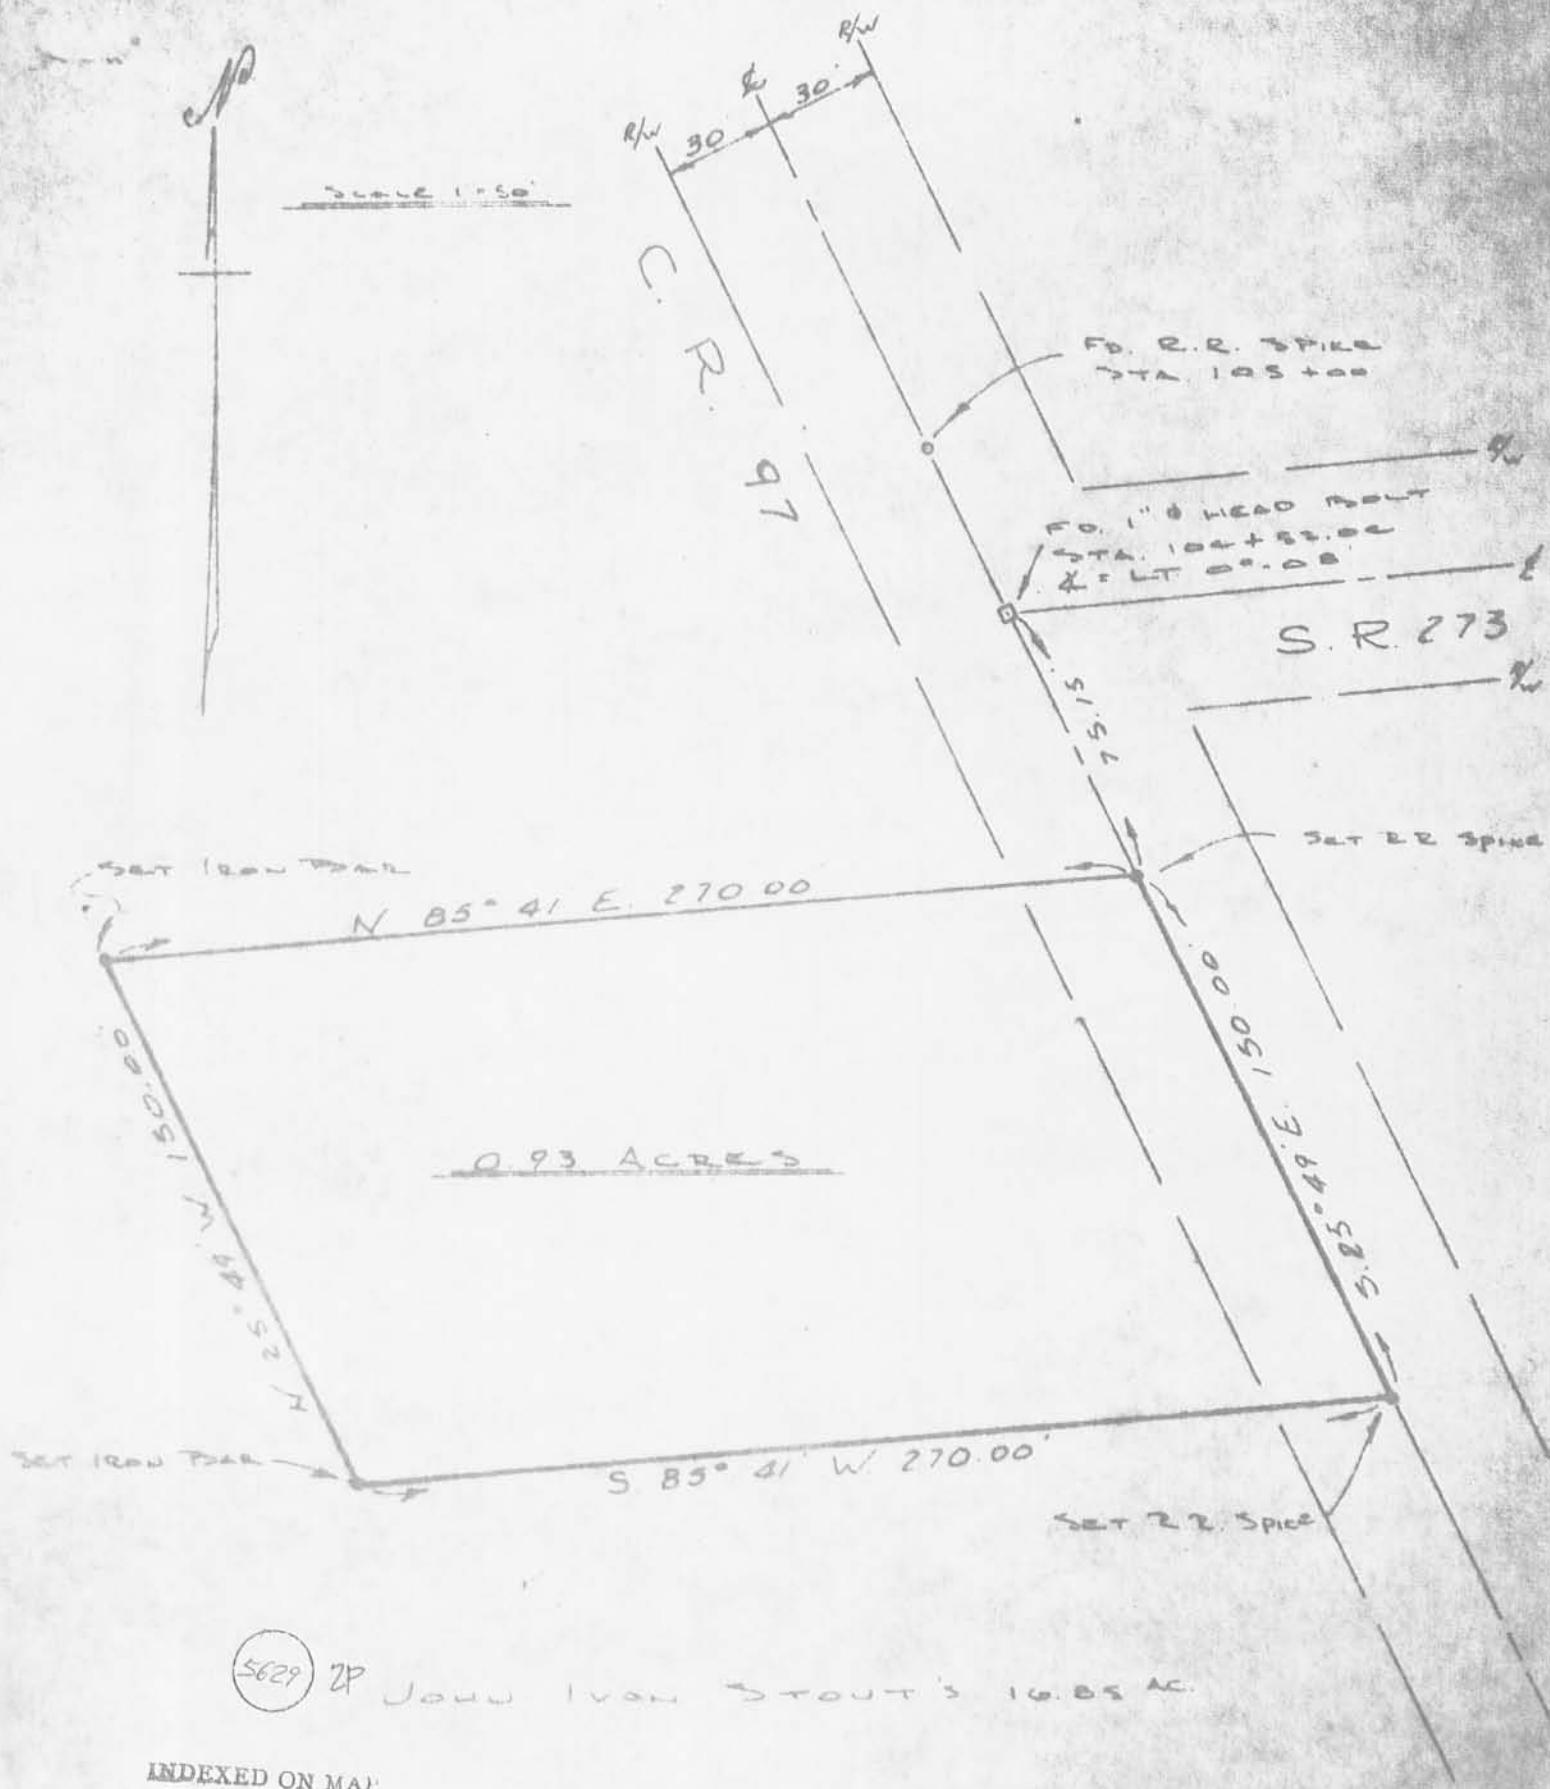

A SURVEY OF A 0.93 ACRE TRACT OUT OF  
JOHN IVAN STOUT'S 16.85 ACRES IN VIRGINIA  
MILITARY SURVEY 9988, RICHLAND TOWNSHIP,