



REC'D 8-26-96 SHY

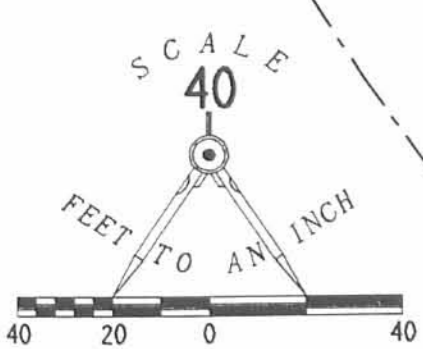

CURVE	DELTA ANGLE	RADIUS	ARC	TANGENT	CHORD	CHORD BEARING
C 1	135° 19' 05"	25.00'	59.04'	60.83'	46.25'	N 62° 57' 34" E
C 2	01° 59' 18"	597.96'	20.75'	10.38'	20.75'	S 50° 22' 32" E
C 3	04° 47' 48"	597.96'	50.06'	25.04'	50.04'	S 53° 46' 05" E
C 4	07° 29' 58"	383.10'	50.14'	25.11'	50.11'	S 59° 54' 57" E
C 5	03° 12' 02"	383.10'	21.40'	10.70'	21.40'	S 65° 15' 57" E
C 6	139° 14' 00"	25.00'	60.75'	67.29'	46.87'	S 02° 45' 02" W
C 7	33° 18' 29"	85.00'	49.41'	25.43'	48.72'	S 89° 01' 16" W
C 8	36° 19' 01"	85.00'	53.88'	27.88'	52.98'	N 56° 09' 58" W
C 9	33° 18' 29"	85.00'	49.41'	25.43'	48.72'	N 21° 21' 13" W

- LEGEND**
- 5/8" IRON ROD SET
 - 1" PIPE FOUND
 - ⊙ 1" PINCHED PIPE FOUND
 - 1" IRON ROD FOUND
 - ⊕ CONCRETE MONUMENT FOUND

RETRACEMENT SURVEY OF LOTS 149-156
 FERNWOOD NUMBER 2
 VIRGINIA MILITARY SURVEY 13393
 RICHLAND TOWNSHIP
 LOGAN COUNTY, OHIO

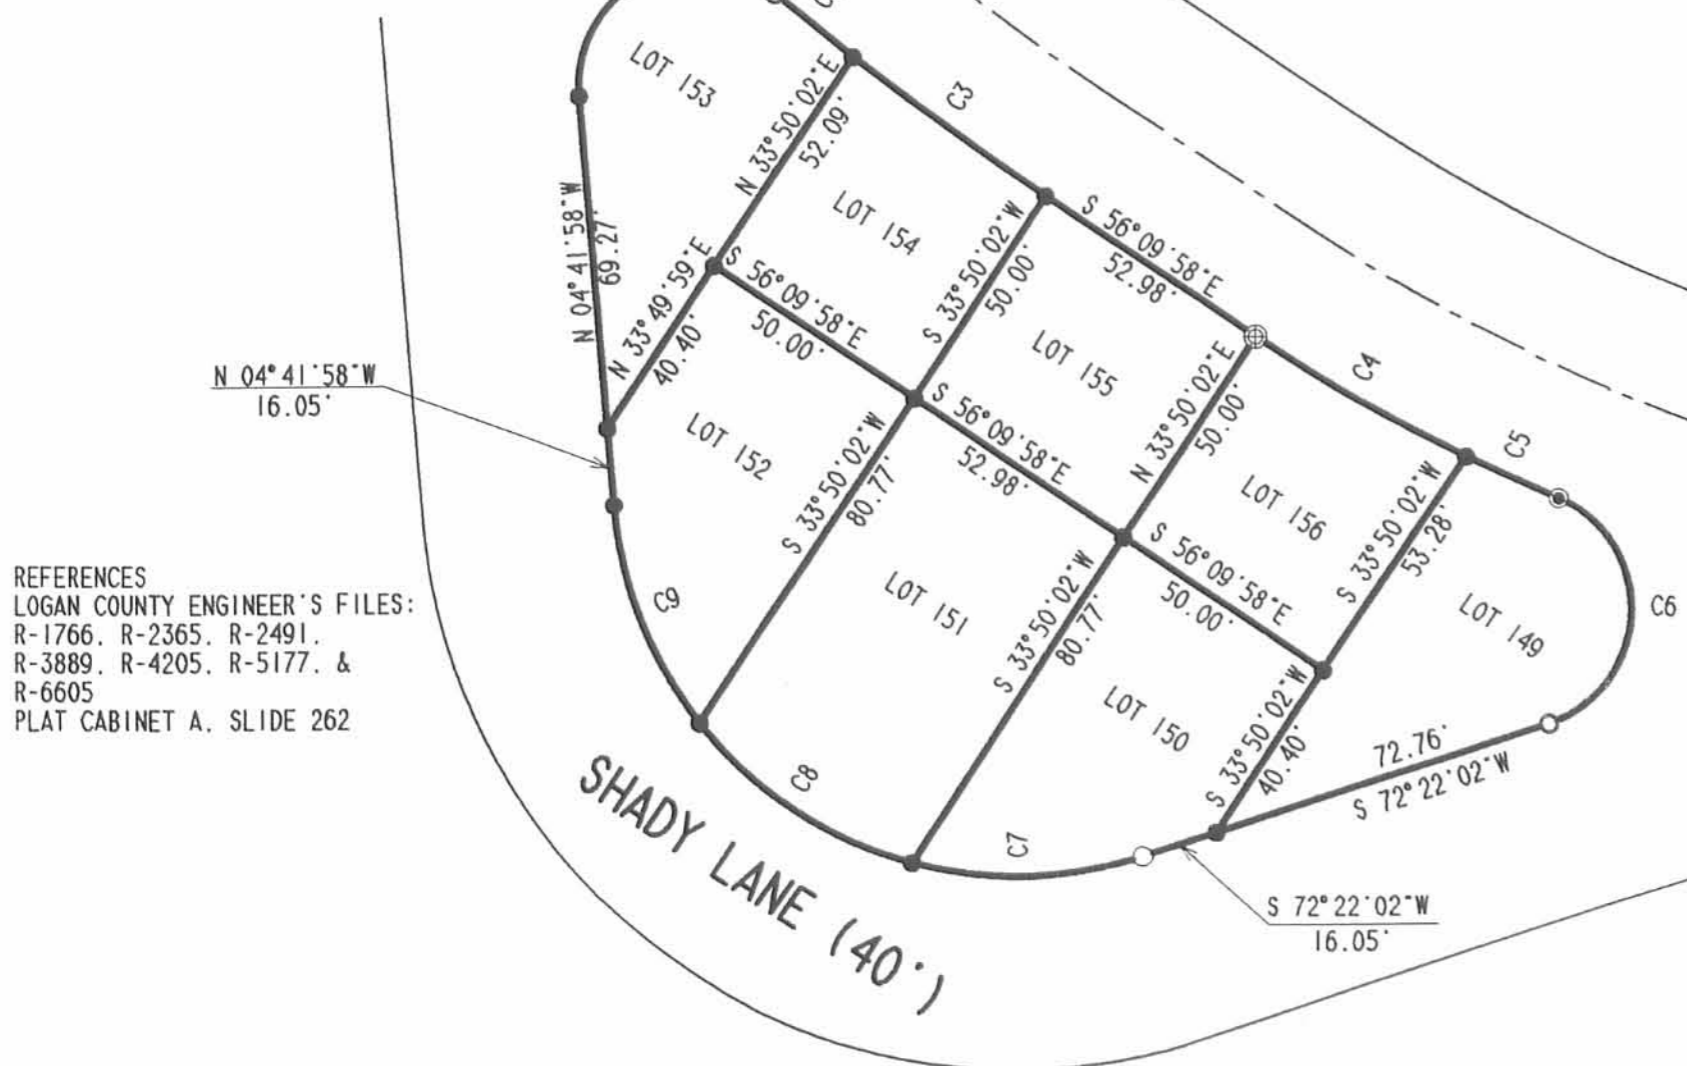

REFERENCES
 LOGAN COUNTY ENGINEER'S FILES:
 R-1766, R-2365, R-2491,
 R-3889, R-4205, R-5177, &
 R-6605
 PLAT CABINET A, SLIDE 262



SURVEYED BY:

 JEFFREY I. LEE
 PROFESSIONAL SURVEYOR 6359
 AUGUST 16, 1996

COPYRIGHT 1996 BY:
 LEE SURVEYING & MAPPING CO., INC.
 117 North Madriver Street
 BELLEFONTAINE, OHIO 43311
 (513) 593-7335

2 WORKING DAYS
BEFORE YOU DIG
 CALL TOLL FREE **800-362-2764**
 OHIO UTILITIES PROTECTION SERVICE.

INDEXED ON MAP
 9091 1P

ORIGINAL STAMP IN GREEN