

## Kitchen Line Survey

A  
B stake  
C stake  
D  
E  
F

11.M.S. 3327

$$AB = 2004.75'$$

$$BC = 1402.50$$

CD


DE

EF

$$FA = 2722.5$$


11-7-27  
AB S. 86°-30' W. (Needle)

see Book 403 Page 16

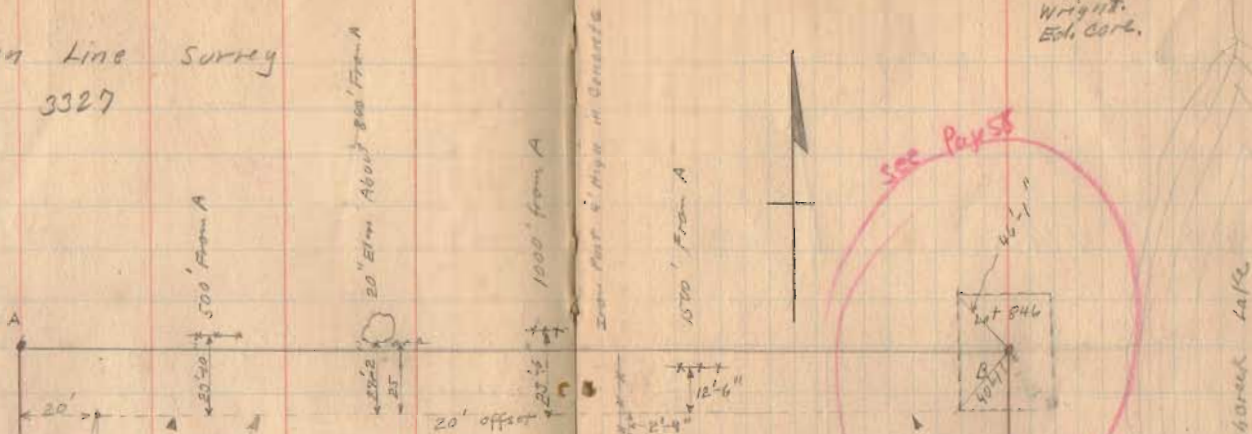


Nov. 7, 1927.

Ground Frozen  
Mch. Day To Work  
Wright.  
Ech. Carb.

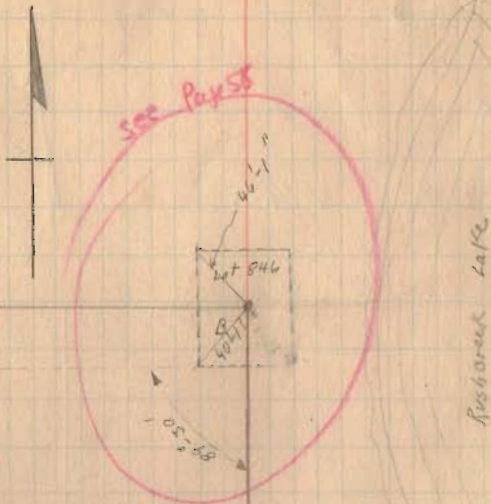

See Page 50

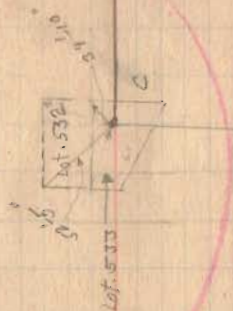


874  
549

INDEXED ON MAP

See Drawer

R

Kitabon Line Survey

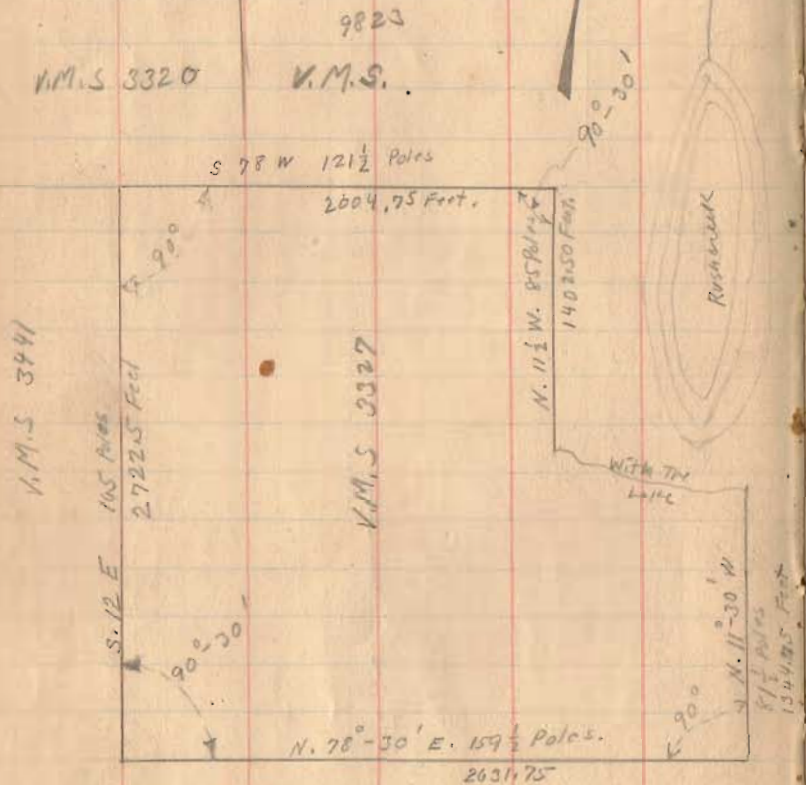

11-7-27

57

Sketch shows Lines as shown  
in deed  
Vol. Page.

Also See Book "A" Page 305.


See Survey (874) for Plat.









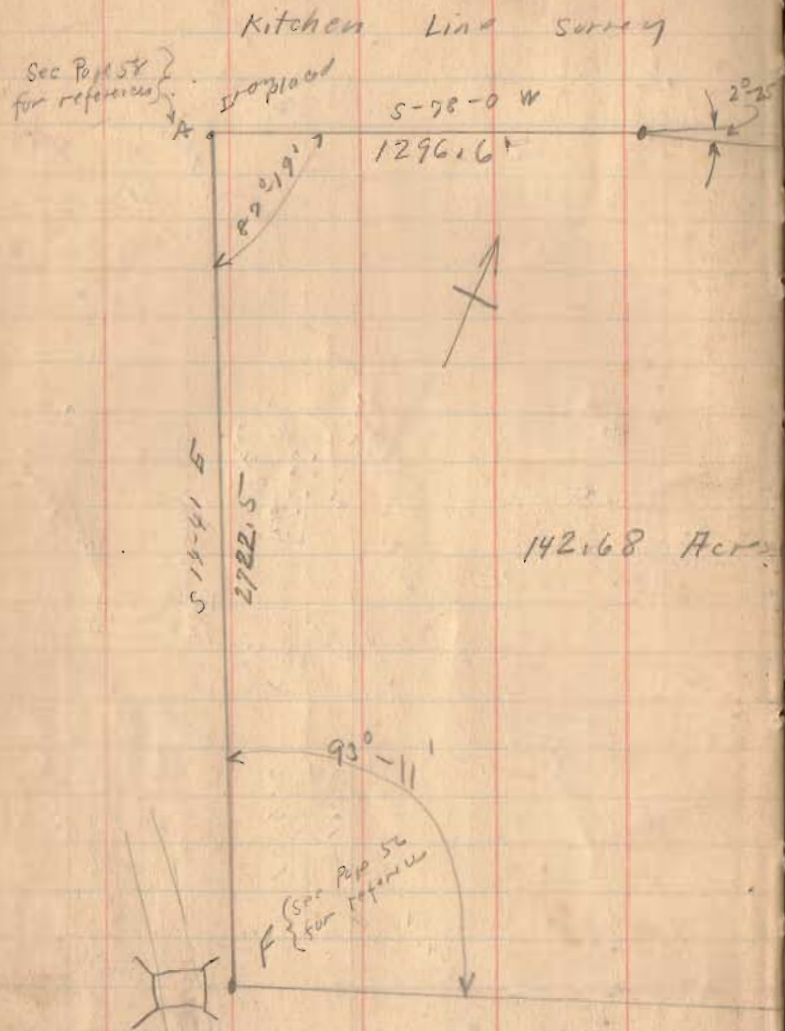

Note This Page  
Shows outside Boundries.  
See Page 56, 57, 59 for details

N<sub>1</sub> - 1927

60

S-80-25 W

708.2

See P<sub>1</sub> 57 For Reference

N. 10-05 W.

1402.5

S 71-55 W

832.0

see P<sub>1</sub> 57  
for reference

N-78-30 E

2631.7

N 11-30 W

1344.7

Mountain Lake  
Rushonak Lake.

See Book 490 Page 4