


Craig Survey
Lot 64 Roshsylvania.

Plat showing Lot from Plat Book
and Street widths.

See Plat Book Page 63

Isaac D. Craig Lot #64 Vol. 137 Page 267
Lot #63 Vol. 131 Page 401

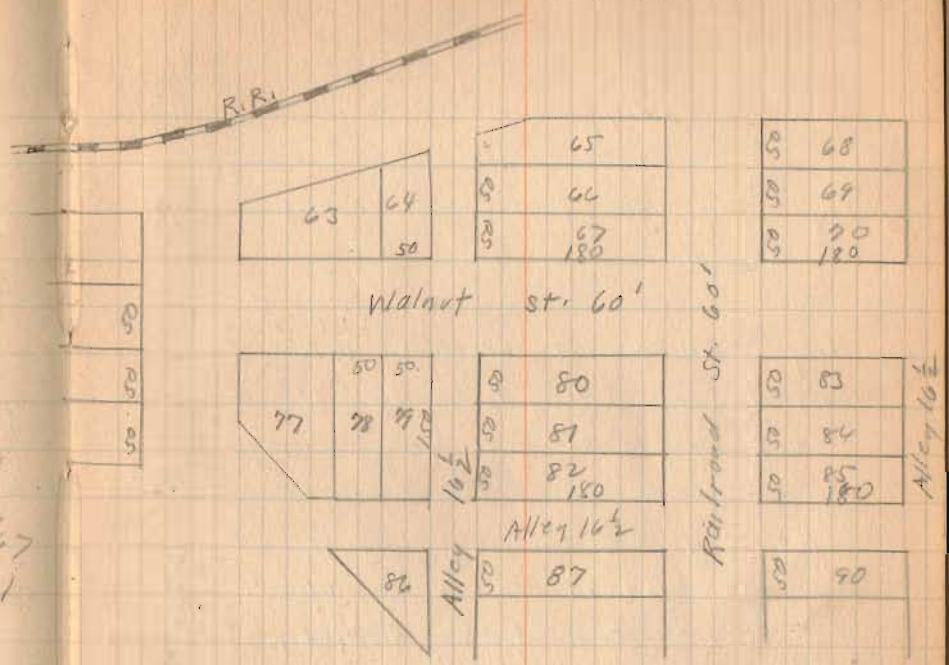

666
INDEXED ON MAP

(Continued)

7-30-28.

44

Craig Sarran

