

1060

INDEXED ON MAP

Rollins Survey
Rosharek Tap.
V.M.S. 9954 & 9955


See Map
Drawer R

- A. Iron Placed.
- B. Stone Found.
- C. Post.
- D. Stone Found
- E. Post.
- F. Iron Placed $\frac{1}{2}$ "
- G. " " 1" Pipe
- H. " "
- I. Post
- J. Post
- K. Post
- L. Post
- M. Post
- N. Post

ABCDEFA	28.73	Area V.M.S. 9955
	80.58	" V.M.S. 9954
	109.31	
G-H-I-J-K-L-M-N-G	45.60	" V.M.S. 9954
TOTAL	154.91	

March 20 - 1929
Clear - Muddy
Windy
Antrion
Wickensham

10

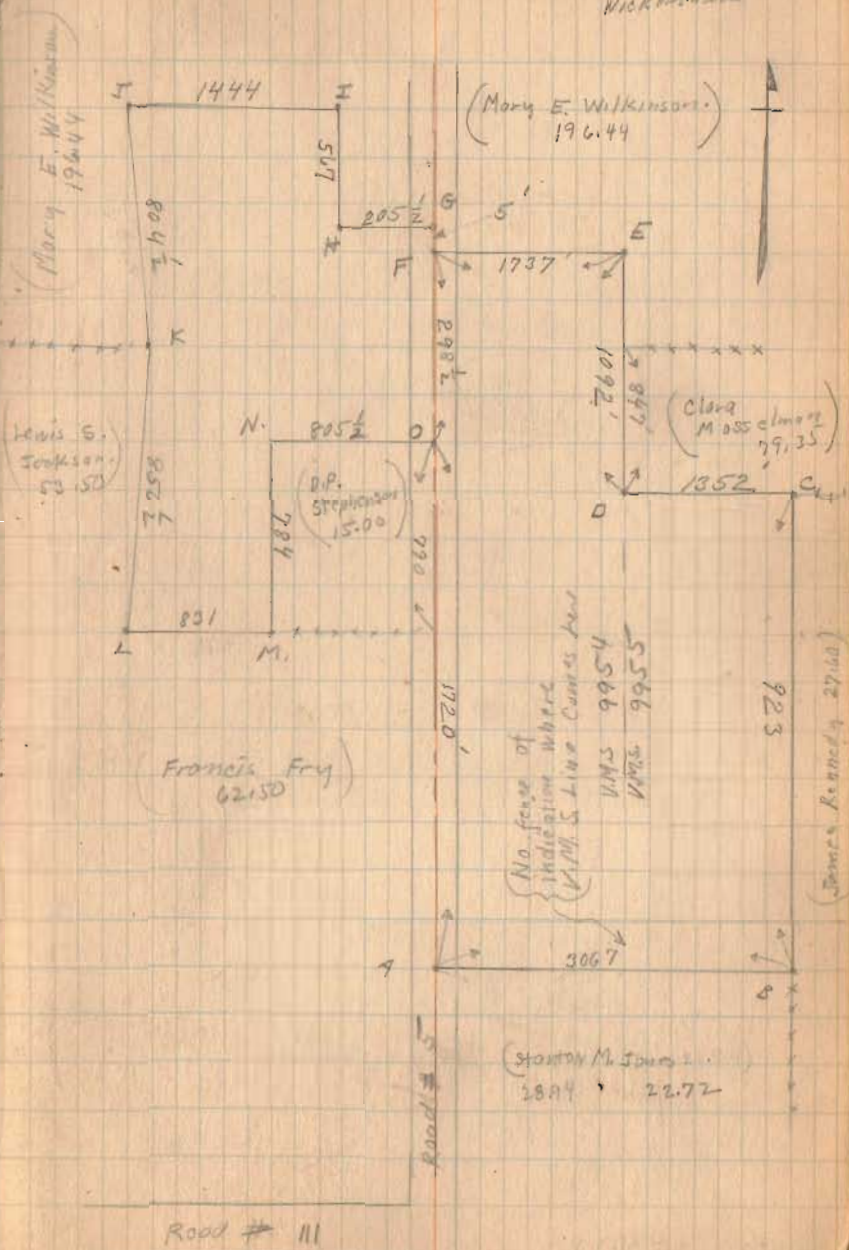


Road # 111

5-20-29

11

Rollings Survey

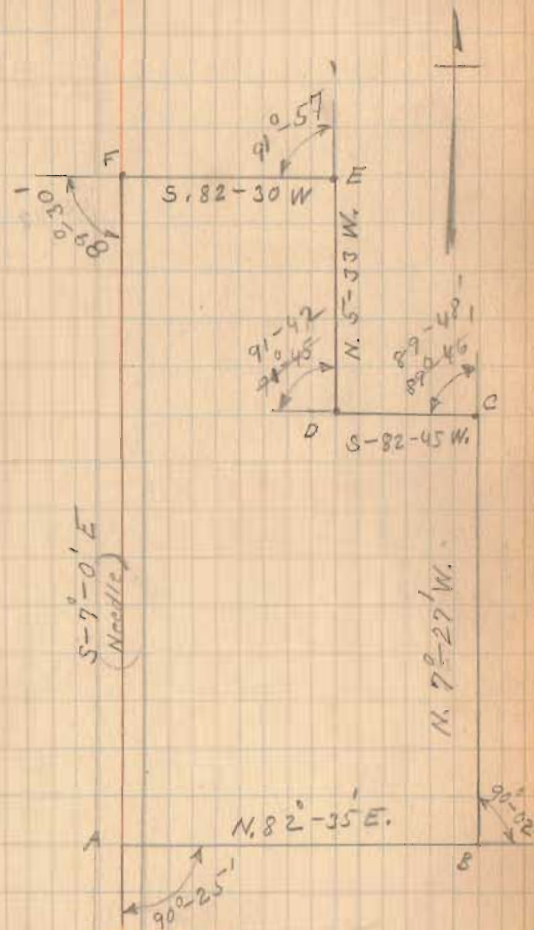


INDEXED ON MAP

Rollings Survey.

3-20-29


12

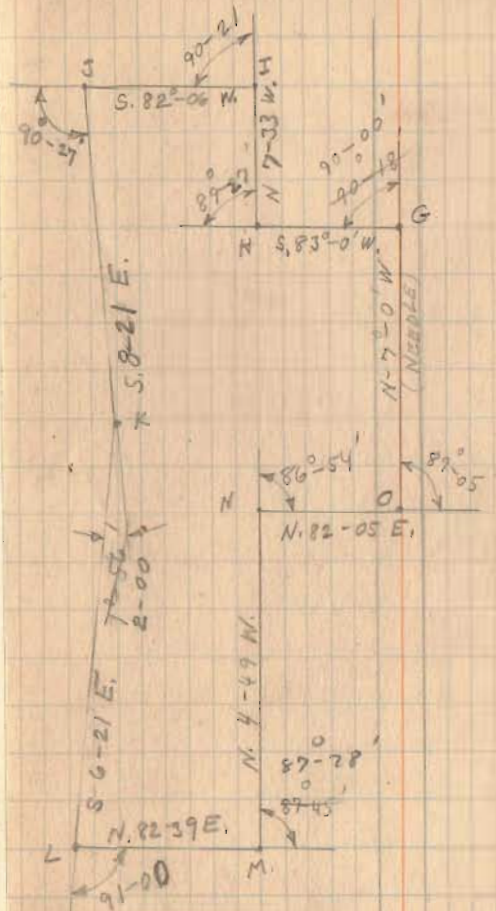

Rollings Survey.

3-20-29

73

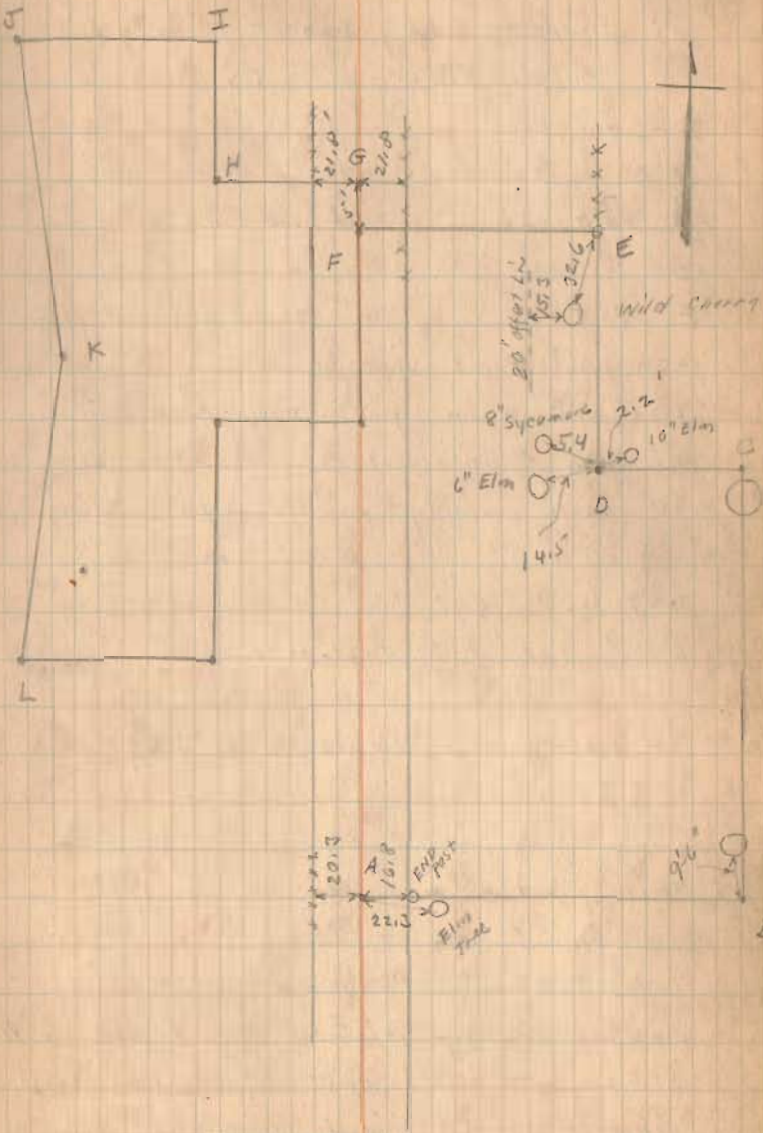

INDEXED ON MAP

1929

Rollins - West of Road.

The following described land being in V.M.S. 9954, in Rush-creek Township, Logan County, Ohio.

Beginning at a point in the center of Road # 5, said point being at the N.E. corner to D.P. Stephenson's 15 acre tract, thence N. 7° 0' W. with the center of said road 303½ feet to an iron, thence S. 83° 0' W. 205½ feet to an iron, thence N. 7° 33' W. 567 feet to a post; thence S. 82° 06' W. 1444 feet to a post, thence S. 8° 21' E. 804½ feet to L.G. Jackson's N.E. corner, thence S. 6° 21' E. 856½ feet to a post, thence N. 82° 39' E. 831 feet to a post at D.P. Stephenson's S.W. corner of a 15 acre tract, thence N. 4° 49' W. with Stephenson's W. line 784 feet to a post, thence N. 82° 05' E. 805½ feet to place of beginning said tract containing 45.60 acres more or less and being the same tract as surveyed March 1929 as shown and recorded in Surveyor's Book 479, Page 10.

1060 1D-1

Rollins - East of Road
V.M.S. 9954

The following described land being in V.M.S. 9954 in
Rushcreek Township, Logan County, Ohio.

Beginning at an iron in the center of County Road #5 said
iron being at the N.W. corner of S.M.Jones' 28.94 acre tract, thence
N.82° 35' E. 1715 feet to the East line of V.M.S. 9954, thence N.5° 33'
W. with the East line of said survey 2015 feet to a post, thence S.82°-
30' W. 1737 feet to an iron in County Road #5, thence S.7° 0' E. with
center of County Road 2018½ feet to place of beginning said tract con-
taining 80.58 acres more or less and being the same tract as surveyed
March , 1929 as shown as recorded in Surveyor's Book 479 Page 10.

INDEXED ON MAP

1060 1D-2


Rollins - East of Road.

The following described land being in V.M.S. 9954 and 9955,
in Rushcreek Township, Logan County, Ohio.

Beginning at an iron in the center of County Road # 5, said iron being at the N.W. corner of S.M. Jones' 28.94 acre tract, thence N. 82° 35' E. 3067 feet to a stone in James Kennedy's West line, the last described line passing from V.M.S. 9954 to 9955 at about 1685 feet, thence N. 7° 27' W. with Kennedy's West line 923 feet to a point in Musselman's S. line, thence S. 82° 45' W. 1352 feet to a stone in West line of V.M.S. 9955, thence N. 5° 33' W. with East line of V.M.S. 9954 1092 feet to a post; thence S. 82° 30' W. 1737 feet to an iron in the center of Road # 5, thence S. 7° 0' E. 2018 $\frac{1}{2}$ feet to place of beginning, said tract containing 109.31 acres more or less, 28.73 acres being in V.M.S. 9955 and 80.58 acres in V.M.S. 9954 said tract being the same tract as surveyed March 1929, as shown and recorded in Surveyor's Book 479, Page 10.

INDEXED ON MAP

1060 10-3

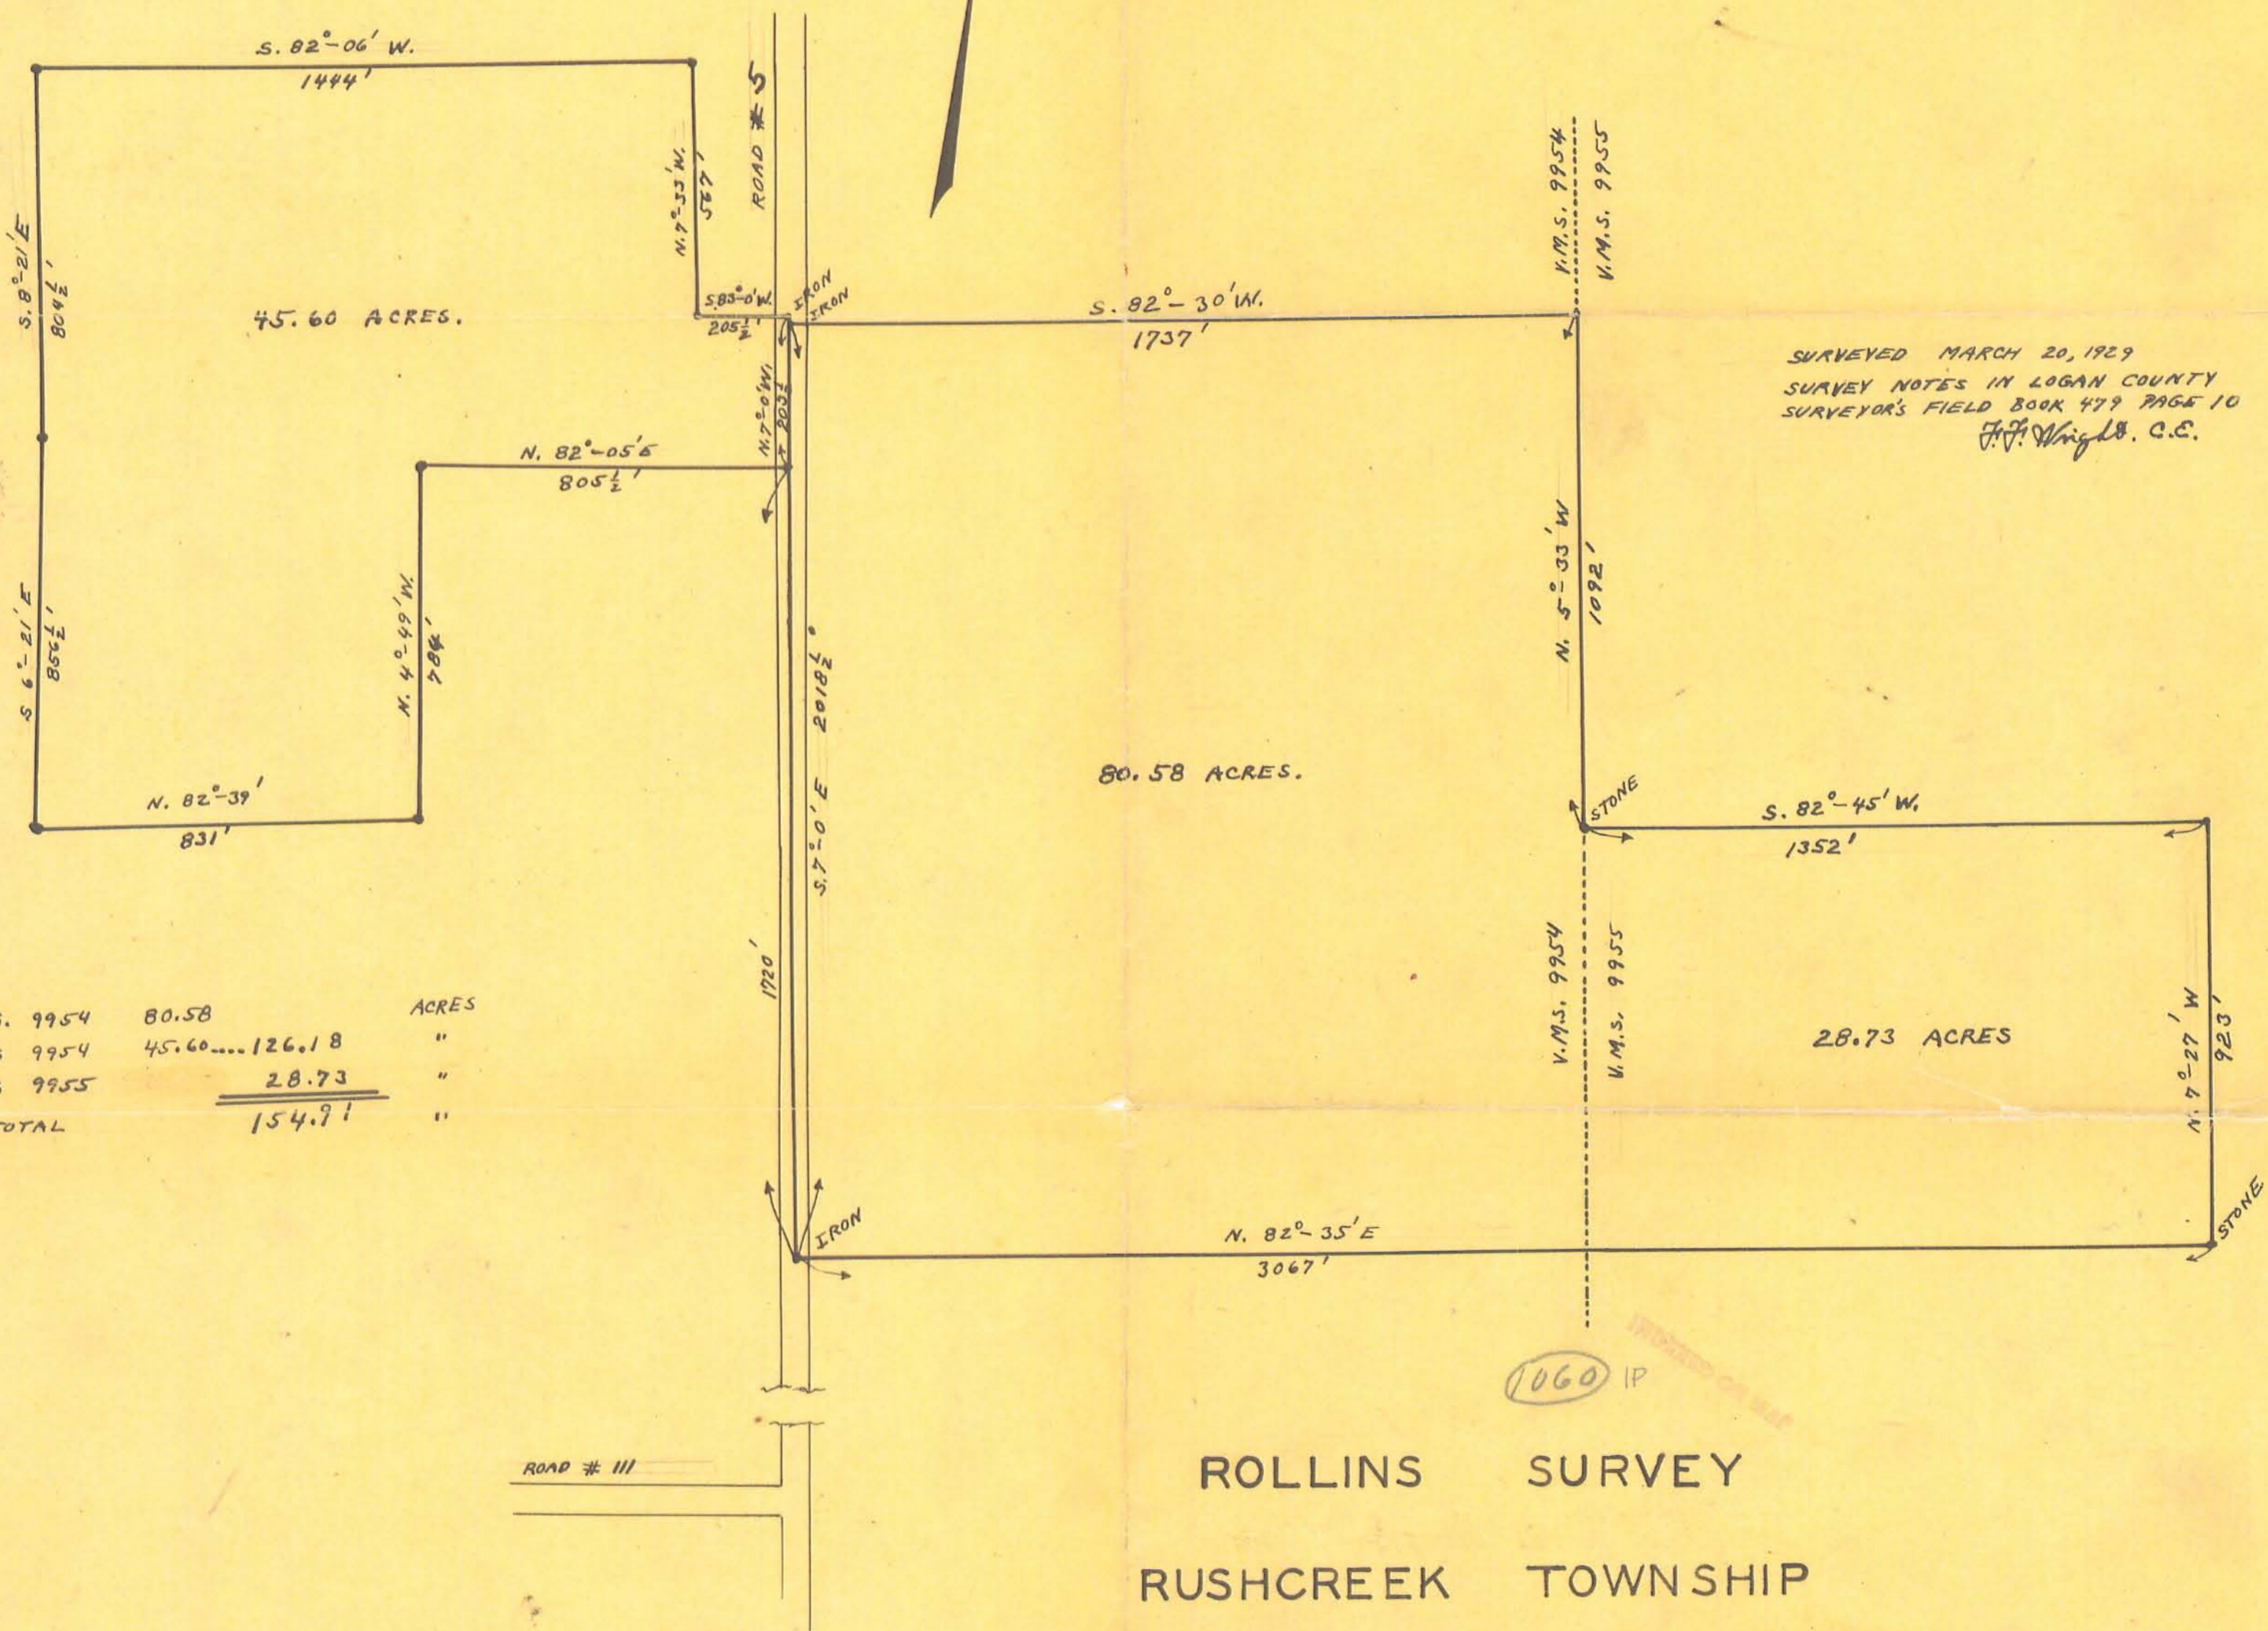

SURVEYED MARCH 20, 1929
 SURVEY NOTES IN LOGAN COUNTY
 SURVEYOR'S FIELD BOOK 479 PAGE 10
 J. J. Wright, C.E.

V.M.S.	ACRES	TOTAL	ACRES
9954	80.58		
9954	45.60	126.18	
9955	28.73		
TOTAL		154.91	

ROLLINS SURVEY
 RUSHCREEK TOWNSHIP

1929

LESLIE H. GEESLIN

REGISTERED SURVEYOR 5248

P. O. BOX 274

RUSHSYLVANIA, OHIO 43347

TELEPHONE: (513) 468-2793

VAN HOOSE SURVEY

May 7, 1997

The following described real estate situated in the State of Ohio, County of Logan, Township of Rushcreek, being part of Virginia Military Survey 9955 and more particularly described as follows:

Beginning at a cap and nail found in the centerline of Township Road 110 at the southeast corner of Gary L Kennedy's 25.240 acre tract as described in O. R. Vol. 277 Page 733.

Thence with the centerline of said T. R. 110 S. 7° 39' 00" E. 573.77 feet to a cap and nail set.

Thence S. 82° 21' 00" W. 524.41 feet to a 5/8 inch iron bar set, passing a 5/8 inch iron bar set at 25.00 feet.

Thence N. 8° 02' 50" W. 574.17 feet to a 5/8 inch iron bar set in said Kennedy's south line

Thence with said Kennedy's south line N. 82° 23' 31" E. 528.38 feet to the place of beginning, passing a 5/8 inch iron bar set at 503.38 feet.

Containing 6.936 acres more or less of which 0.329 acres are in the right of way of Township Road 110.

The above described 6.936 acre tract being part of John Richard Kennedy, etal's 60 acre tract as described in O. R. Vol. 277 page 728.

Bearings are based on an assumed bearing (S. 7° 39' 00" E.) for the centerline of Township Road 110 in this field survey by Leslie H. Geeslin, Reg. Surveyor 5248 on May 7, 1997




RUSHCRK111VANHOOSE.SAM,


Leslie H. Geeslin

INDEXED ON MAP
1060 2D

GARY L. KENNEDY
 25.240 AC.
 O.R. VOL. 277 PAGE 733

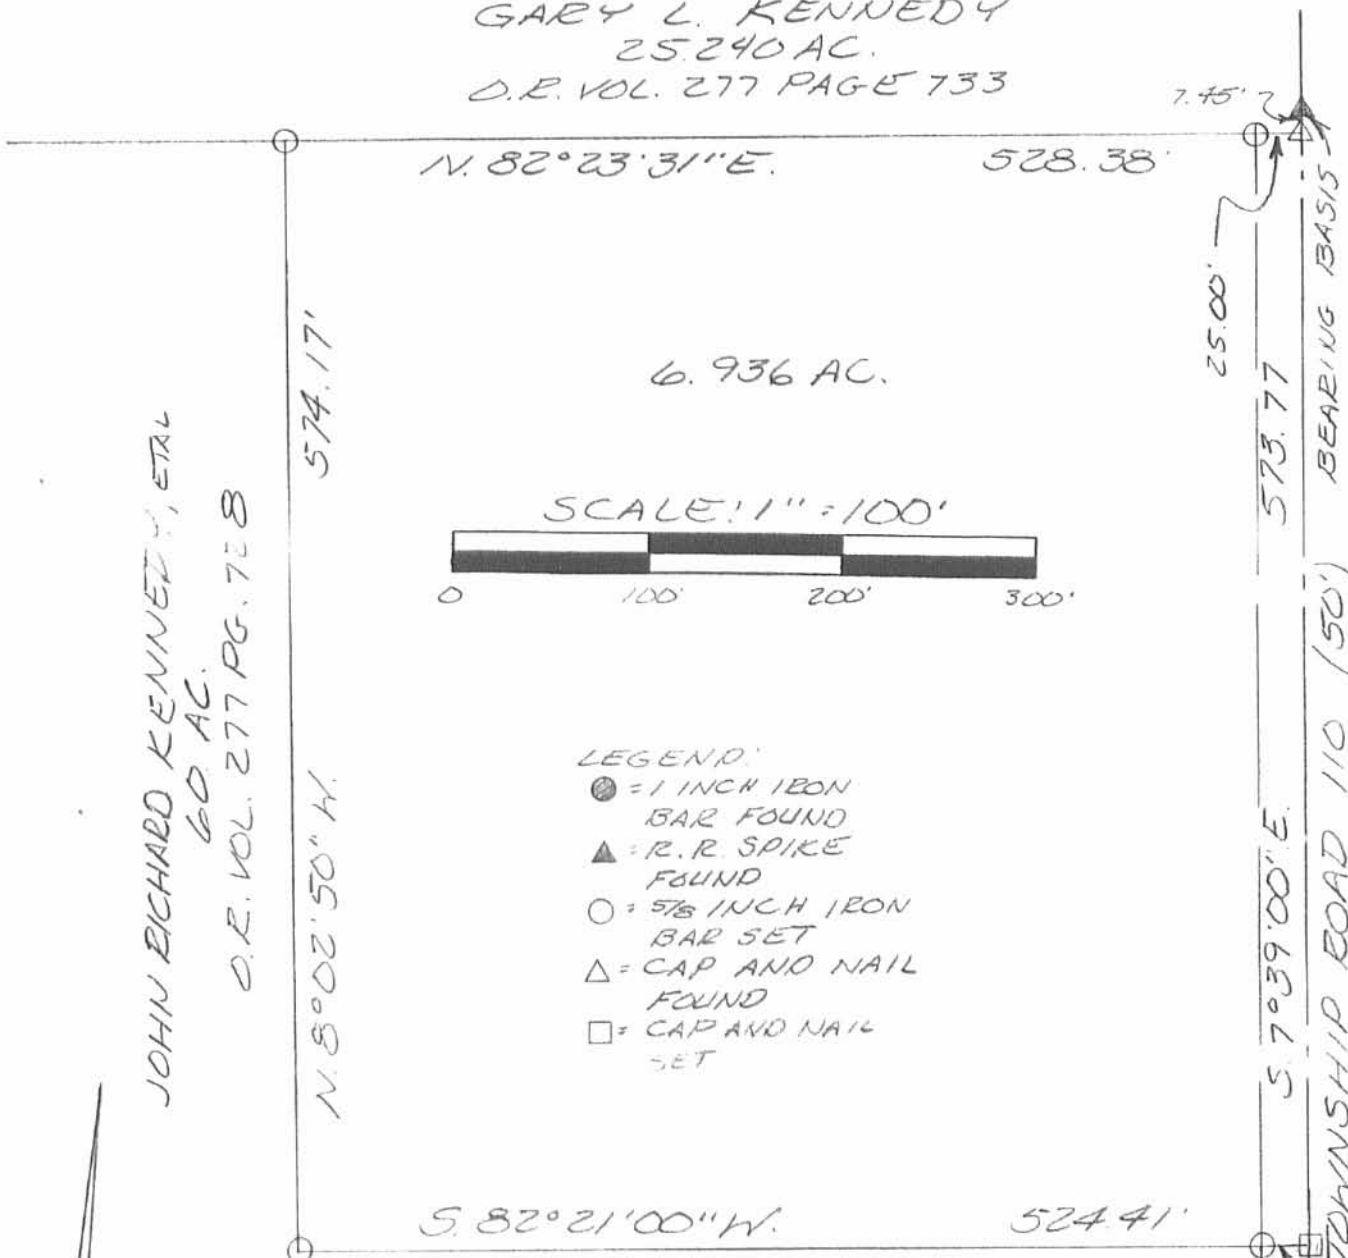

JOHN RICHARD KENNEDY, ETAL
 60 AC.
 O.R. VOL. 277 PG. 728

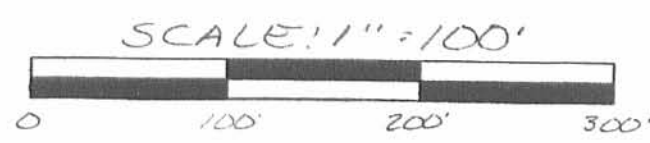

- LEGEND:
- = 1 INCH IRON BAR FOUND
 - ▲ = R.R. SPIKE FOUND
 - = 5/8 INCH IRON BAR SET
 - △ = CAP AND NAIL FOUND
 - = CAP AND NAIL SET

SURVEY OF 6.936 ACRES IN VIRGINIA MILITARY SURVEY 9955, RUSHCREEK TOWNSHIP, LOGAN COUNTY, OHIO FOR CINDY VAN HOOSE ON MAY 7, 1997



Leslie H. Geeslin
 LESLIE H. GEESLIN
 RUSHCREEK TOWNSHIP, LOGAN COUNTY, OHIO
 (237) 468-2793

INDEXED ON MAP
 1060 2P

REC'D 1-4-96 5:14 PM OK ✓

LESLIE H. GEESLIN

REGISTERED SURVEYOR 5248

P. O. BOX 274

RUSHSVLVANIA, OHIO 43347

TELEPHONE: (513) 468-2793

KENNEDY SURVEY

January 2, 1996

The following described real estate situated in the State of Ohio, County of Logan, Township of Rushcreek, being part of Virginia Military Survey 9955 and more particularly described as follows:

Beginning at a cap and nail found in the centerline of Township Road 110 at the southeast corner of Beryl Richard Kennedy's 68.04 acre tract as described in O. R. Vol. 241 Page 594.

Thence with the centerline of said T. R. 110 S. 7° 39' 00" E. 518.25 feet to a cap and nail set.

Thence S. 82° 23' 31" W. 2054.08 feet to a 5/8 inch iron bar set in the east line of said Kennedy's 28.72 acre tract as described in O. R. Vol. 241 Page 597.

Thence with the east line of said 28.72 acre tract N. 7° 52' 18" W. 551.72 feet to a 5/8 inch iron bar set in the south line of said Kennedy's 68.04 acre tract.

Thence with the south line of said Kennedy's 68.04 acre tract N. 83° 19' 28" E. 2056.51 feet to the place of beginning.

Containing 25.240 acres more or less of which 0.297 acre is in the right of way of Township Road 110.

The above described 25.240 acre tract having 8.917 acres out of Beryl Richard Kennedy's 27.6 acre tract (Tract II, Parcel 2), 7.113 acres out of his 22 acre tract (Tract II, Parcel 3), and 9.210 acres out of his 60 acre tract (Tract II, Parcel 1) as all are described in O. R. Vol. 241 page 597.


Bearings are based on an assumed bearing (S. 7° 39' 00" E.) for the centerline of Township Road 110 in this field survey by Leslie H. Geeslin, Reg. Surveyor 5248 on January 2, 1996.



RU A:\11\KENNEDY2.SAM

INDEXED ON MAP
1060 3D

Leslie H. Geeslin

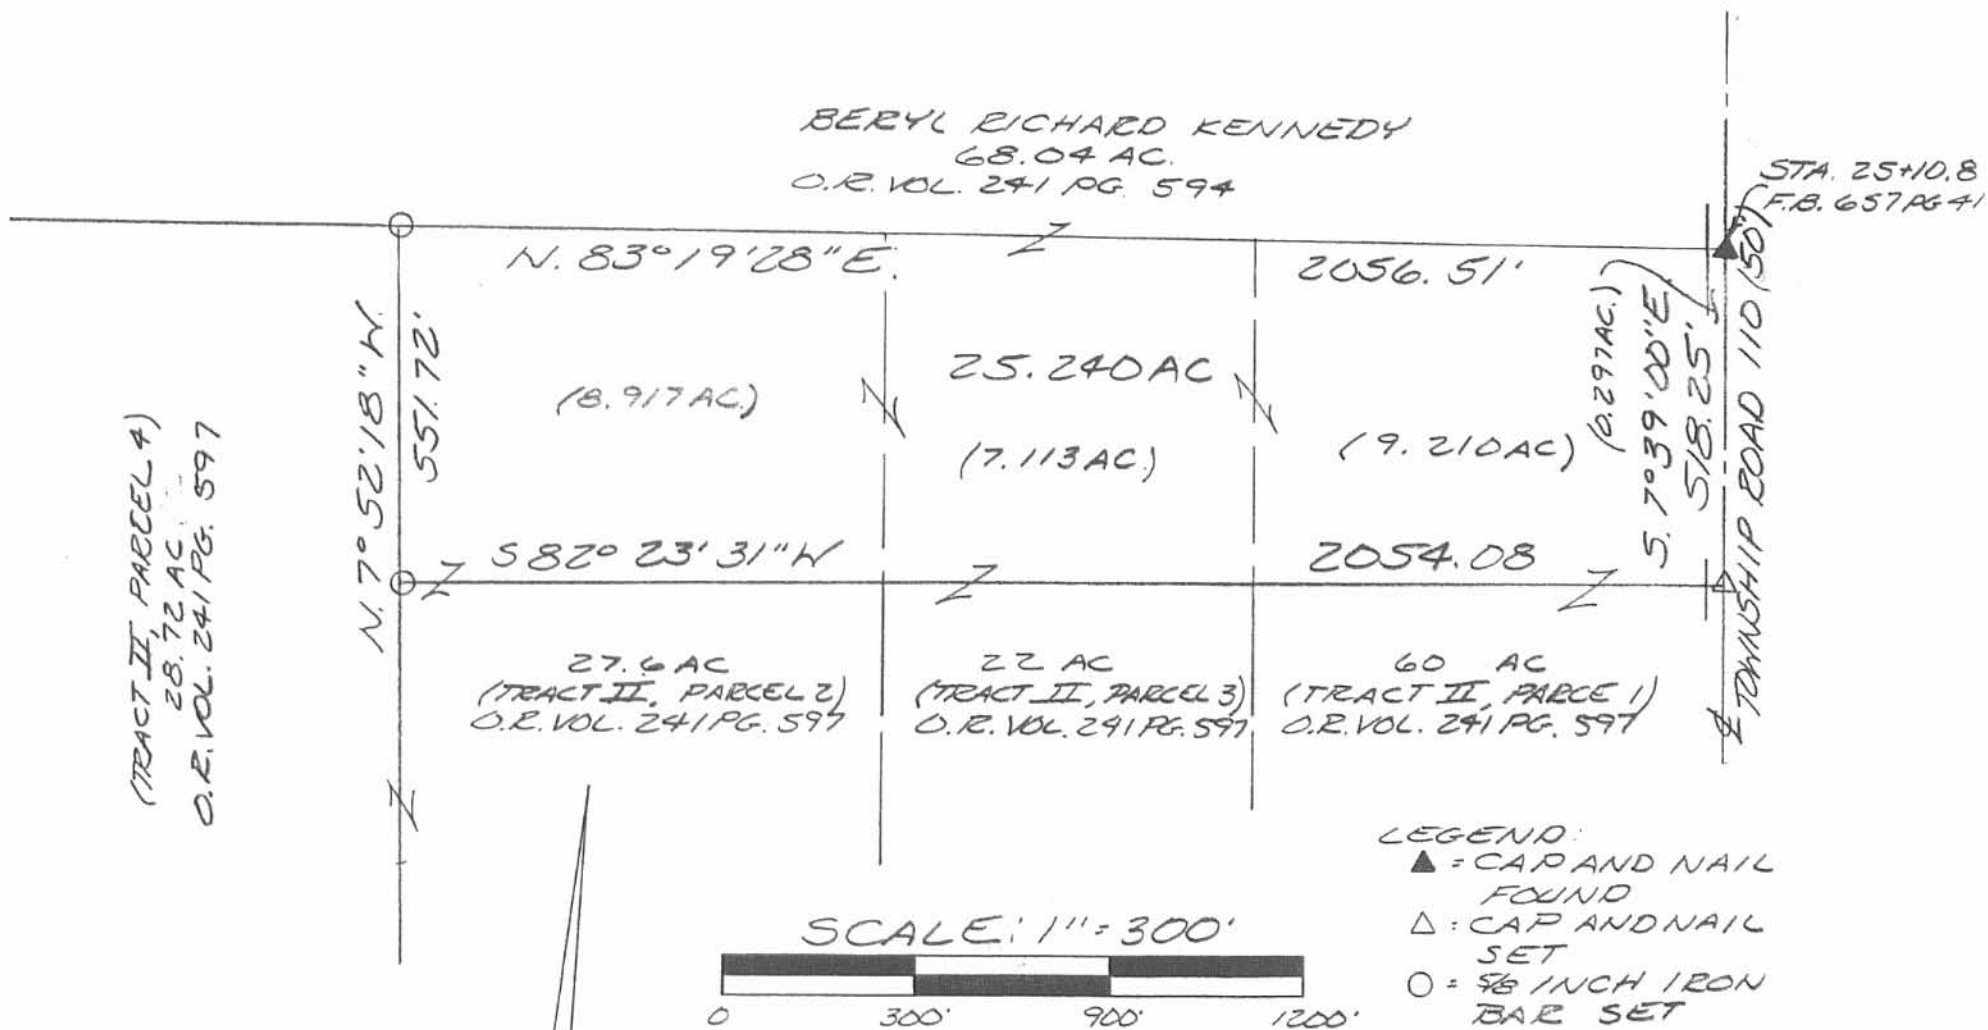

SURVEY OF 25.240 ACRES IN VIRGINIA
MILITARY SURVEY 9955, RUSHCREEK
TOWNSHIP, LOGAN COUNTY, OHIO FOR
RICHARD KENNEDY ON
JANUARY 2, 1996



Leslie H. Geeslin
LESLIE H. GEESLIN
RUSHSVLVANIA, OH
(513) 468-2793

INDEXED ON MAP
1060 3P

REC'D 2-3-97 SMY OK ✓

LESLIE H. GEESLIN
REGISTERED SURVEYOR 5248
P. O. BOX 274
RUSHSVLVANIA, OHIO 43347
TELEPHONE: (513) 468-2793

KENNEDY SURVEY

January 22, 1997

The following described real estate situated in the State of Ohio, County of Logan, Township of Rushcreek, being part of Virginia Military Survey 9955 and more particularly described as follows:

Beginning at a stone found at the intersection of the centerline of Township Road 110 with the south line of said V. M. S. 9955.

Thence with the south line of said V. M. S. 9955 S. 83° 22' 40" W. 2078.28 feet to a 6 inch wood post found at the southeast corner of Kenneth S. Jones's 125.50 acre tract as described in D. B. Vol. 371 Page 705.

Thence with said Jones' east line and the east line of Gary L. Kennedy's 28.72 acre tract (O. R. Vol. 277 Page 733) N. 7° 52' 18" W. 1099.13 feet to a 5/8 inch iron bar found at the southwest corner of Gary L. Kennedy's 25.240 acre tract as described in O. R. Vol. 277 Page 733.

Thence with the south line of said 25.240 acre tract N. 82° 23' 31" E. 2054.08 feet to a cap and nail found in the centerline of said T. R. 110.

Thence with the centerline of said T. R. 110 S. 7° 39' 00" E. 592.34 feet to a 1 inch iron bar found.

Thence again with the centerline of said T. R. 110 S. 10° 37' 00" E. 543.29 feet to the place of beginning.

Containing 52.781 acres more or less of which 0.652 acre is in the right of way of Township Road 110.

The above described 52.781 acre tract having 18.680 acres out of Gary L. Kennedy, etal's original 27.6 acre tract (Tract I, Parcel 2), 14.887 acres out of his original 22 acre tract (tract 1 Par. 3) and 19.214 acre out of his original 60 acre tract (Tract 1, Par. 1) as all are described in O. R. Vol. 277 Page 725.

Bearings are based on an assumed bearing (S. 7° 39' 00" E.) for the centerline of Township Road 110 in this field survey by Leslie H. Geeslin, Reg. Surveyor 5248 on January 22, 1997.



RUSHCRK\11\KENNEDY3.SAM

INDEXED ON MAP
 1060 4D


Leslie H. Geeslin

PAR 2
28.72 AC.

LEGEND:

- = 5/8" IRON BAR FD
- = CAP & NAIL FD
- = 1" IRON BAR FD
- △ = STONE FOUND
- = 6" WOOD CORNER POST FOUND

GARY L. KENNEDY
25.240 AC.
O.R. VOL. 277 PG 733

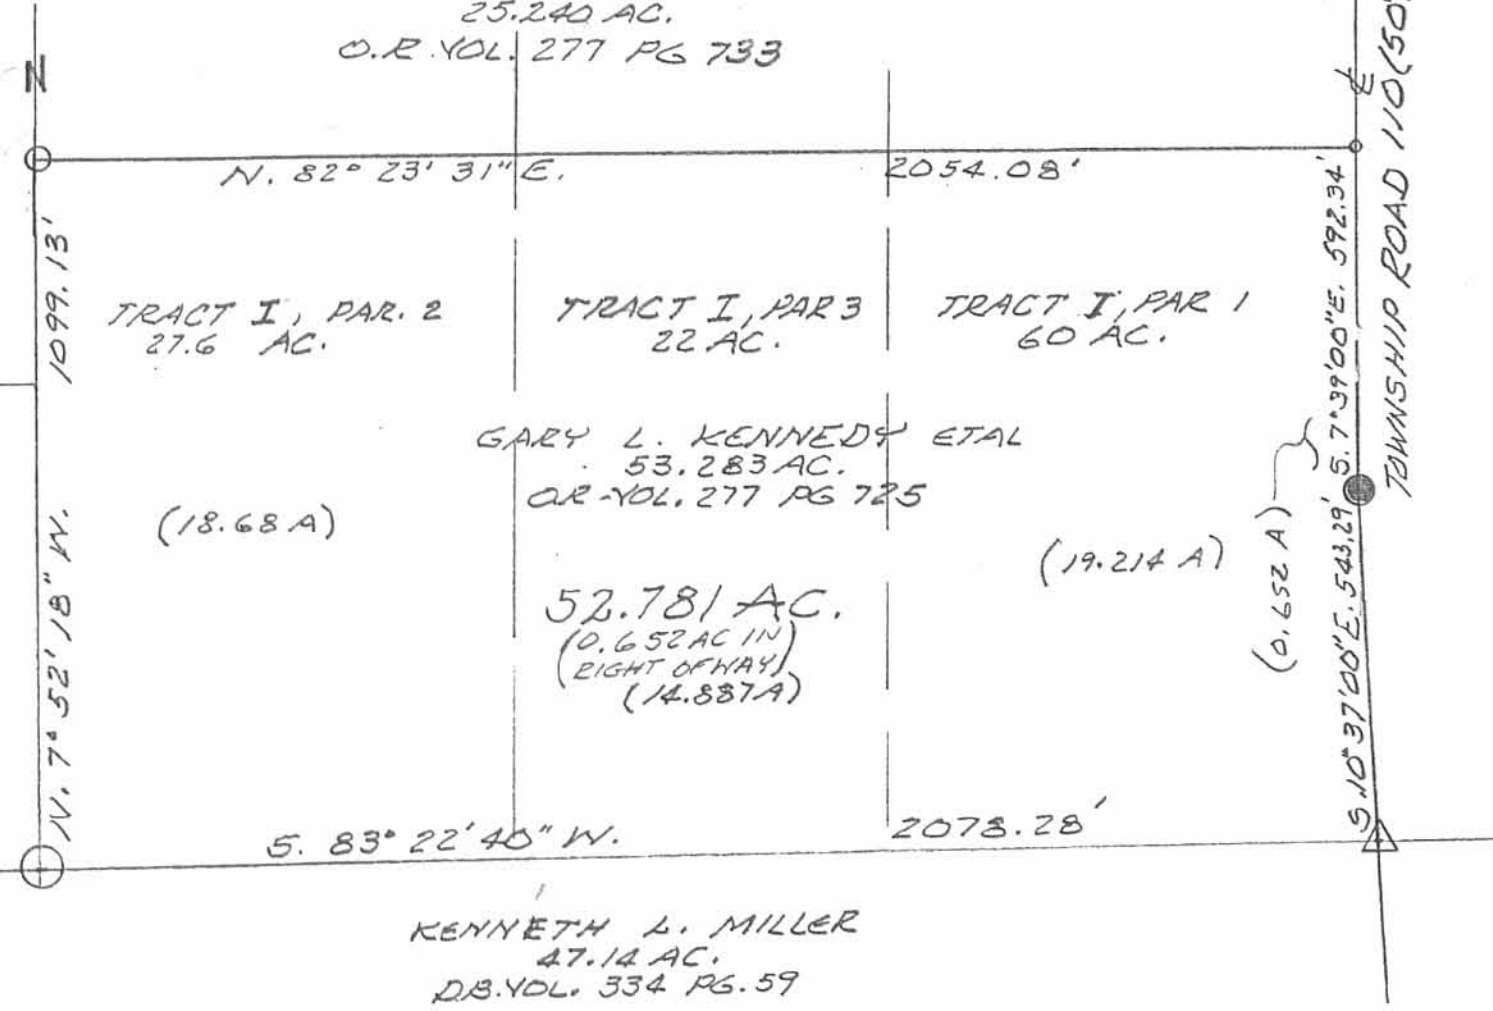

KENNETH S. JONES
125.50 AC.
D.B. VOL. 371 PG 705

V.M.S. 9955
V.M.S. 10041

(18.68 A)

GARY L. KENNEDY ETAL
53.283 AC.
O.R. VOL. 277 PG 725


(19.214 A)

52.781 AC.
(0.652 AC IN
RIGHT OFWAY)
(14.887A)

(0.652 A)

SURVEY OF 52.781 AC. TRACT IN
V.M.S. 9955, RUSHCREEK TOWNSHIP,
LOGAN COUNTY, OHIO FOR RICK
KENNEDY.

JANUARY 23, 1996
SCALE: 1" = 300'

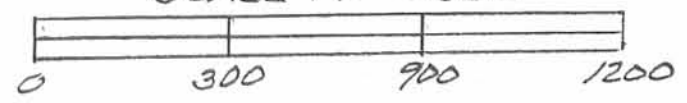

INDEXED ON MAP
1060 4A



Leslie H. Geeslin
LESLIE H. GEESLIN
RUSHsylvania, OHIO
PH 513-468-2793

Received 7-6-00 OKJERS

Lee Surveying and Mapping Co., Inc.

Land Surveys • Topography • Subdivisions • Construction Layout

117 N. Madriver St.
Bellefontaine OH 43311



Phone: (937) 593-7335
Fax: (937) 593-7444

BURKHOLDER 5.723 ACRES

Lying in Virginia Military Survey 9954, Rushcreek Township, Logan County, Ohio.

Being a 5.723 acre tract out of the Russell Eugene Robinson original 92.126 acre tract as deeded and described in Official Record 80, Page 128 of the Logan County Records of Deeds and being more particularly described as follows:

Beginning at a stone found in a monument box at the intersection of the center-line of County Highway 5 (60' wide) and the south line of the Russell Eugene Robinson 5.208 acre tract (O.R. 372, Pg. 693).

THENCE, with the center-line of County Highway 5, N 6°-43'-59" W, a distance of 817.29 feet to a MAG nail found at the southwest corner of the Philip Burkholder 5.000 acre tract (O.R. 389, Pg. 511).

THENCE, with the south line of the said 5.000 acre tract, N 82°-29'-29" E, a distance of 808.33 feet to a 5/8 inch iron rod found at the TRUE POINT OF BEGINNING.

THENCE, with a east line of the said 5.000 acre tract, N 6°-44'-00" W, a distance of 269.47 feet to a 5/8 inch iron rod found on the northeast corner of the said 5.000 acre tract.

THENCE, with the south line of the Lowell M. Jones, Trustee of the Lowell M. Jones Trust Agreement, Dated September 21, 1995, 43.83 acre tract (O.R. 271, Pg. 83), N 82°-29'-28" E, a distance of 928.24 feet to a 8 inch x 8 inch wood post found.

THENCE, with the west line of Virginia Military Survey 9955 and the Fulkerson Farms Family Limited Partnership 60.00 acre tract (O.R. 324, Pg. 221, Tract IV) and the Gary L. Kennedy 69.04 acre tract (O.R. 342, Pg. 293, Tract I), S 5°-26'-35" E, a distance of 269.63 feet to a 5/8 inch iron rod set.

THENCE, S 82°-29'-29" W, a distance of 922.17 feet to the place of beginning.

Containing 5.723 acres.

The basis for bearings is the center-line of County Highway 5 being N 6°-43'-59" W, and all other bearings are from angles and distances measured in a field survey by Lee Surveying and Mapping Co., Inc. on June 15, 2000.

Description prepared by:


A handwritten signature in black ink, appearing to read 'Jeffrey I. Lee', is written over a circular stamp.

Jeffrey I. Lee
Professional Surveyor 6359
June 16, 2000




L-2984

INDEXED ON MAP
1060 5D

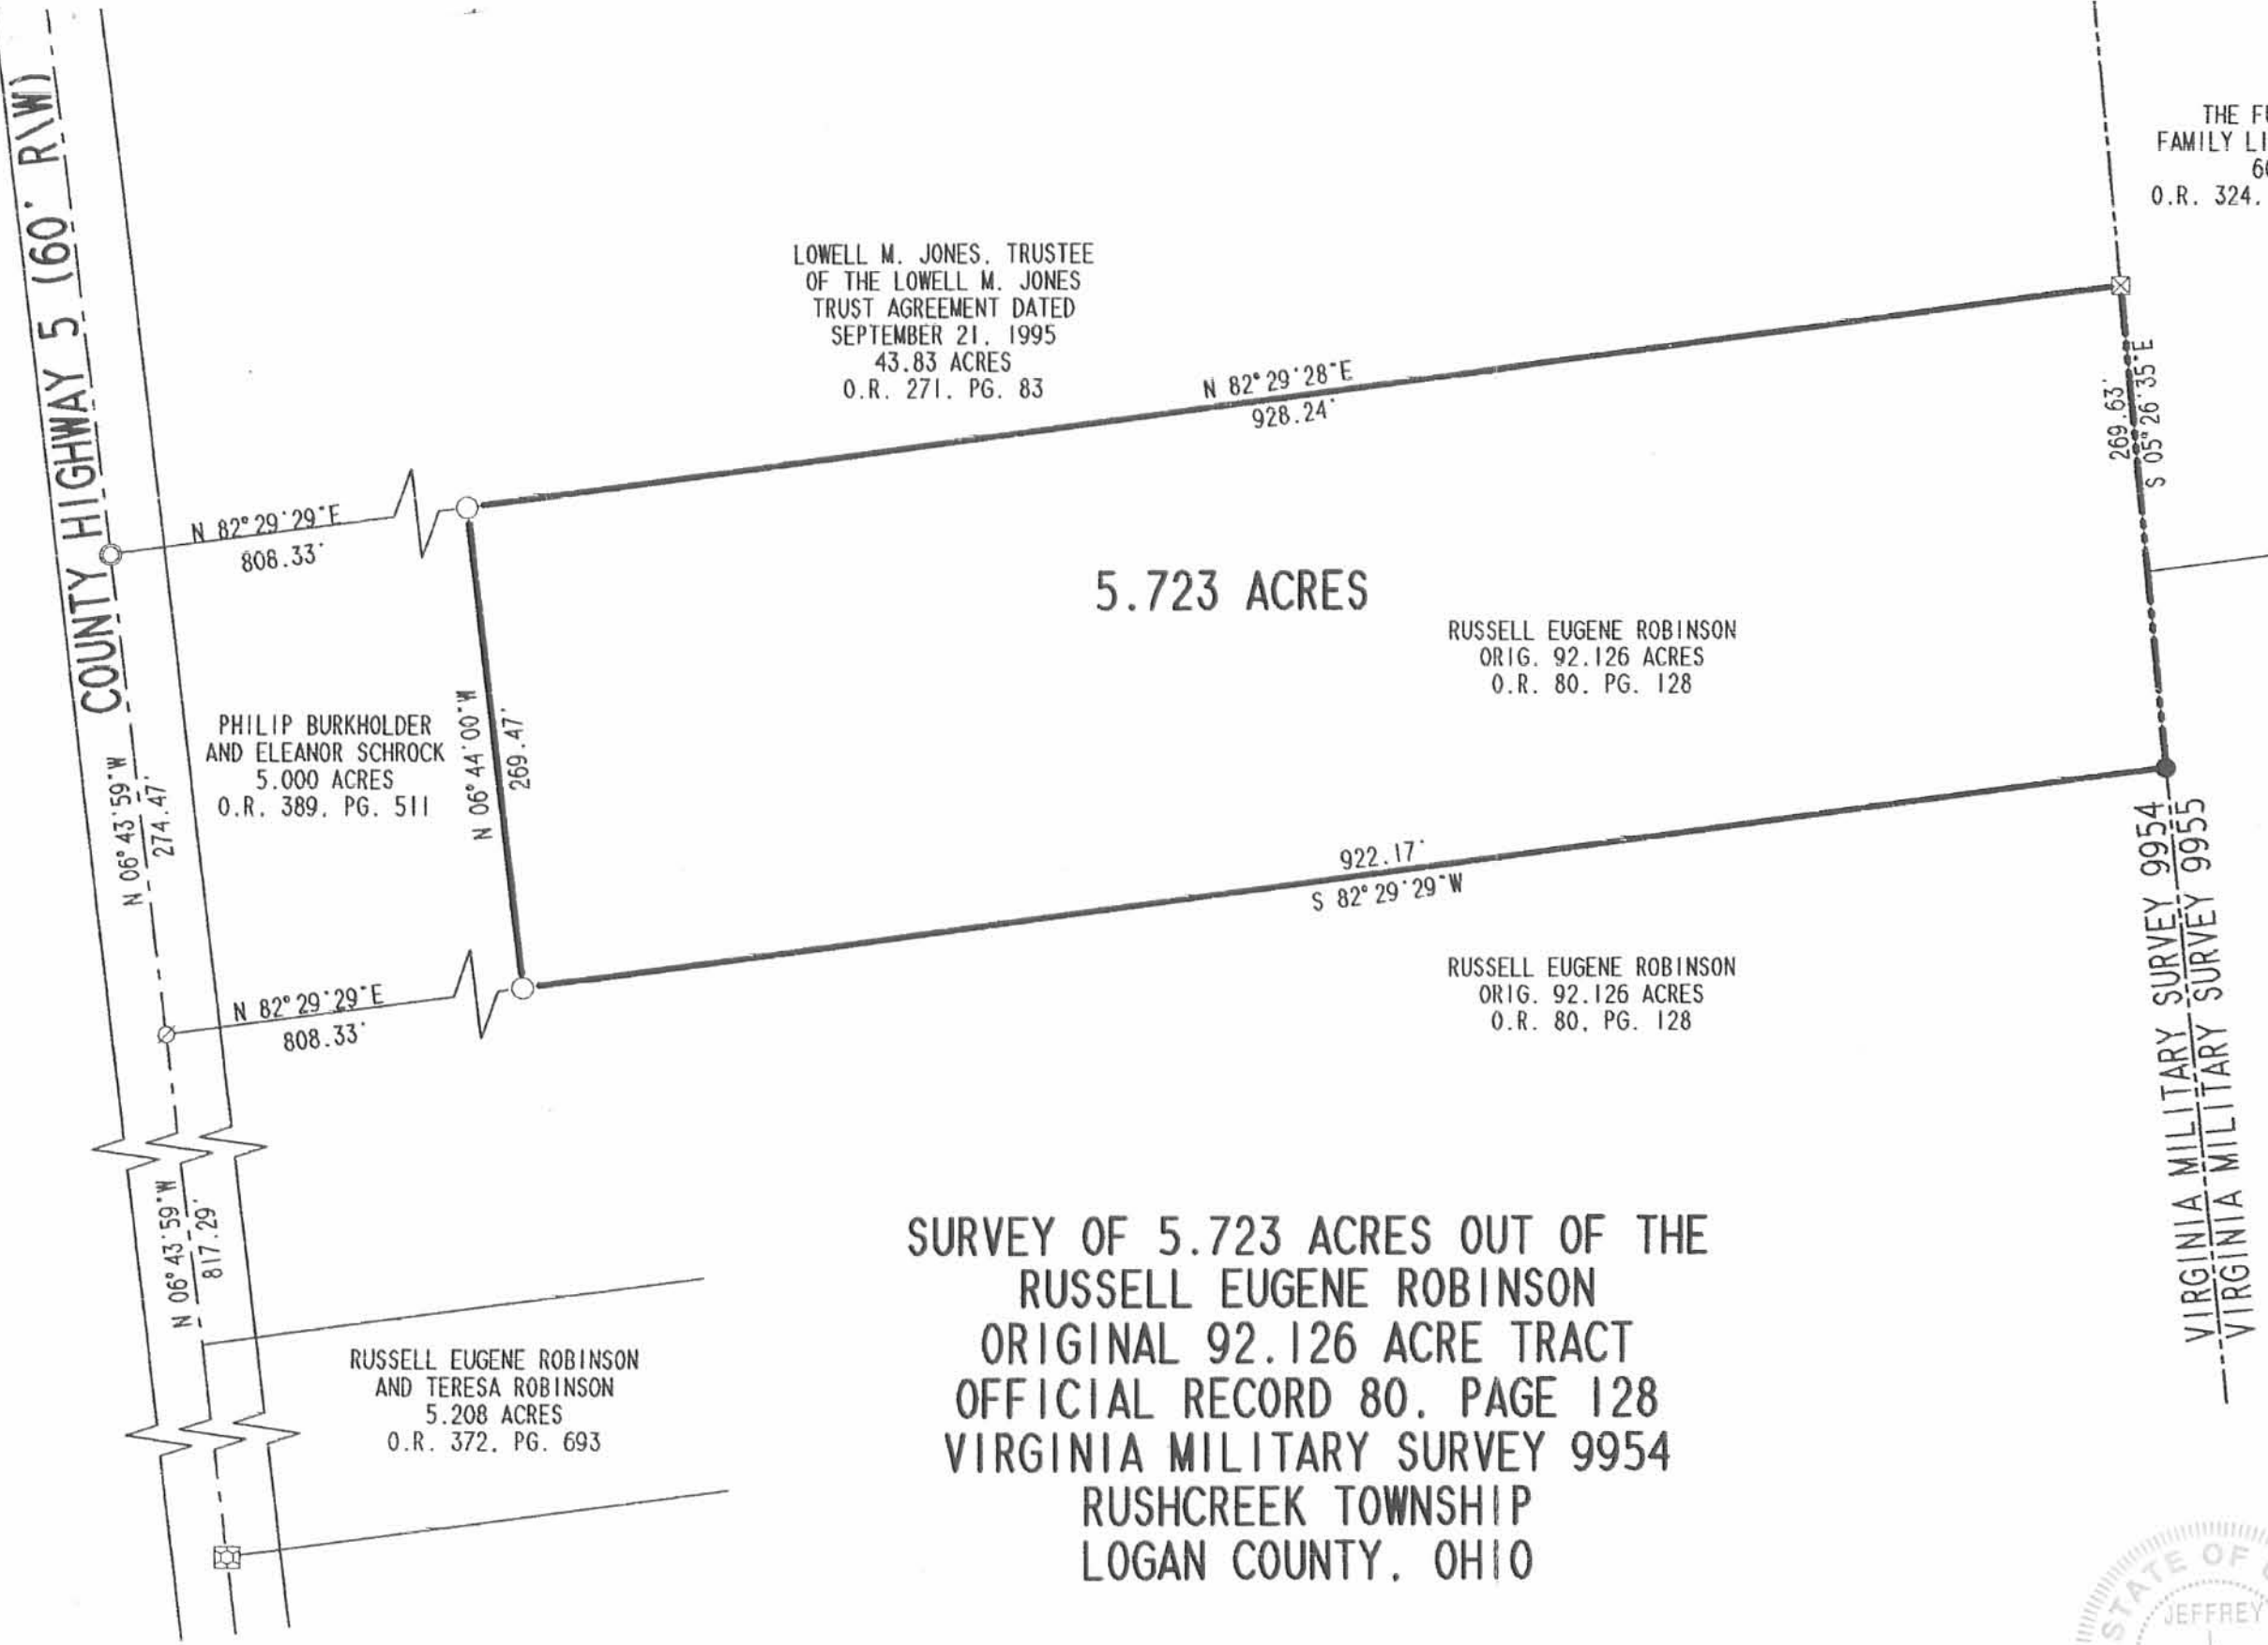

LOWELL M. JONES, TRUSTEE
 OF THE LOWELL M. JONES
 TRUST AGREEMENT DATED
 SEPTEMBER 21, 1995
 43.83 ACRES
 O.R. 271, PG. 83

THE FULKERSON FARMS
 FAMILY LIMITED PARTNERSHIP
 60.00 ACRES
 O.R. 324, PG. 221, TRACT IV

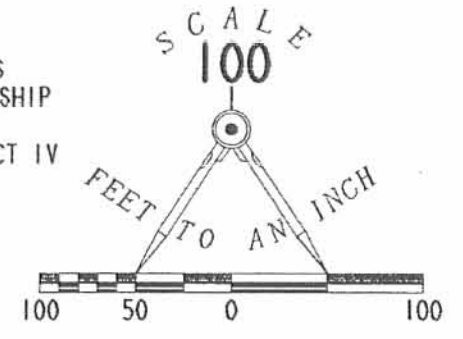

- LEGEND:
- 5/8 INCH IRON ROD SET
 - 5/8 INCH IRON ROD FOUND
 - ⊠ 8 INCH x 8 INCH WOOD POST FOUND
 - ⊗ MAG NAIL FOUND
 - ⊙ PK NAIL FOUND
 - ⊞ STONE FOUND IN A MONUMENT BOX

GARY L. KENNEDY
 AND ROSALIE KENNEDY
 68.04 ACRES
 O.R. 342, PG. 293
 TRACT I

5.723 ACRES

RUSSELL EUGENE ROBINSON
 ORIG. 92.126 ACRES
 O.R. 80, PG. 128

RUSSELL EUGENE ROBINSON
 ORIG. 92.126 ACRES
 O.R. 80, PG. 128

RUSSELL EUGENE ROBINSON
 AND TERESA ROBINSON
 5.208 ACRES
 O.R. 372, PG. 693

SURVEY OF 5.723 ACRES OUT OF THE
 RUSSELL EUGENE ROBINSON
 ORIGINAL 92.126 ACRE TRACT
 OFFICIAL RECORD 80, PAGE 128
 VIRGINIA MILITARY SURVEY 9954
 RUSHCREEK TOWNSHIP
 LOGAN COUNTY, OHIO



SURVEYED BY:

 JEFFREY V. LEE
 PROFESSIONAL SURVEYOR 6359
 JUNE 15, 2000

COPYRIGHT 2000 BY:
 LEE SURVEYING & MAPPING CO., INC.
 117 North Madriver Street
 BELLEFONTAINE, OHIO 43311
 (937) 593-7335

2 WORKING DAYS
BEFORE YOU DIG
 CALL TOLL FREE **800-362-2764**
 OHIO UTILITIES PROTECTION SERVICE.

INDEXED ON MAP
 1060 5P


ORIGINAL STAMP IN GREEN

REC'D 11-17-04 SMY OK

Lee Surveying and Mapping Co., Inc.

Land Surveys • Topography • Subdivisions • Construction Layout

117 N. Madriver St.
Bellefontaine OH 43311

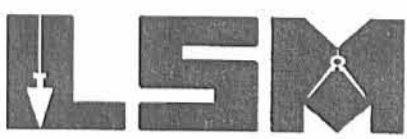

Phone: (937) 593-7335
Fax: (937) 593-7444

ROBINSON 11.129 ACRES TRACT A

Lying in Virginia Military Survey 9954, Rushcreek Township, Logan County, Ohio.

Being out the Russell Eugene Robinson original 92.126 acre tract as deeded and described in Official Record 80, Page 128 of the Logan County Records of Deeds and being more particularly described as follows:

Beginning at a stone found inside a monument box at the southwest corner of the Russell Eugene Robinson and Teresa Robinson 5.208 acre tract (O.R. 372, Pg. 693) on the center-line of County Highway 5 (60 feet wide).

THENCE, with west line of the said 5.208 acre tract and the center-line of County Highway 5, N 6°-43'-59"W, a distance of 275.00 feet to a MAG nail found at THE TRUE POINT OF BEGINNING.

THENCE, with the center-line of County Highway 5, N 6°-43'-59"W, a distance of 392.29 feet to a MAG nail set.

THENCE, N 82°-29'-29"E, a distance of 983.20 feet to a 5/8 inch iron rod set, passing a 5/8 inch iron rod set at 30.00 feet.

THENCE, S 20°-20'17"E, a distance of 687.83 feet to a 5/8 inch iron rod found.

THENCE, with the north line of the James William Robinson 24.392 acre tract (O.R. 80, Pg. 131), S 82°-39'-47"W, a distance 319.85 to a 5/8 inch iron rod found.

THENCE, with the lines of the aforesaid 5.208 acre tract the following two courses:

N 6°-45'-14"W, a distance of 275.08 feet to a 5/8 inch iron rod found.

S 82°-39'-27"W, a distance of 825.02 feet to the point of beginning, passing a 5/8 inch iron rod found at 795.02 feet.

Containing 11.129 acre of which 0.270 acre is within the highway right-of-way.

The basis for bearings is the center-line of County Highway 5 being N 6°-43'-59"W, and all other bearings are from angles and distances measured in a field survey by Lee Surveying and Mapping Co., Inc. on November 12, 2004.




ORIGINAL STAMP IN GREEN

Description prepared by:

Jeffrey I. Lee
Professional Surveyor 6359
November 15, 2004

2984104

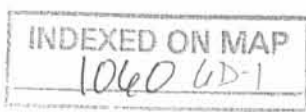

REC'D 11-17-04 SUM OK
Lee Surveying and Mapping Co., Inc.

Land Surveys • Topography • Subdivisions • Construction Layout

117 N. Madriver St.
Bellefontaine OH 43311



Phone: (937) 593-7335
Fax: (937) 593-7444

**ROBINSON
16.052 ACRES
TRACT B**

Lying in Virginia Military Survey 9954, Rushcreek Township, Logan County, Ohio.

Being out the Russell Eugene Robinson original 92.126 acre tract as deeded and described in Official Record 80, Page 128 of the Logan County Records of Deeds and being more particularly described as follows:

Beginning at a stone found inside a monument box at the southwest corner of the Russell Eugene Robinson and Teresa Robinson 5.208 acre tract (O.R. 372, Pg. 693) on the center-line of County Highway 5 (60 feet wide).

THENCE, with the center-line of County Highway 5, N 6°-43'-59"W, a distance of 667.29 feet to a MAG nail set at THE TRUE POINT OF BEGINNING.

THENCE, with the center-line of County Highway 5, N 6°-43'-59"W, a distance of 150.00 feet to a P.K. nail found.

THENCE, with the south line of the Philip Burkholder and Eleanor Schrock 5.000 acre tract (O.R. 389, Pg. 511) and the south line of the Philip and Eleanor Burkholder 5.723 acre tract (O.R. 458, Pg. 788), N 82°-29'-29"E, a distance of 1730.50 feet to a 5/8 inch iron rod set, passing a 5/8 inch iron rod set at 30.00 feet and passing a 5/8 inch iron rod found at 808.33 feet.

THENCE, with the east line of Virginia Military Survey 9954 and the west line of the Gary L. Kennedy and Rosalie Kennedy 68.04 acre tract (O.R. 342, Pg. 293 Tract I), S 5°-25'-18"E, a distance of 822.88 feet to a stone found.

THENCE, S 82°-39'-47"W, a distance of 566.63 feet to a 5/8 inch iron rod found.

THENCE, N 20°-20'-17"W, a distance of 687.83 feet to a 5/8 inch iron rod set.

THENCE, S 82°-29'-29"W, a distance of 983.20 feet to the point of beginning, passing a 5/8 inch iron rod set at 953.20 feet.

Containing 16.052 acre of which 0.103 acre is within the highway right-of-way.

The basis for bearings is the center-line of County Highway 5 being N 6°-43'-59"W, and all other bearings are from angles and distances measured in a field survey by Lee Surveying and Mapping Co., Inc. on November 12, 2004.




ORIGINAL STAMP IN GREEN

Description prepared by:



A handwritten signature in black ink, appearing to read 'Jeffrey I. Lee'.

Jeffrey I. Lee
Professional Surveyor 6359
November 15, 2004

2984104

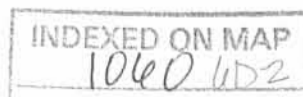

REC'D 11-17-04 8M OK

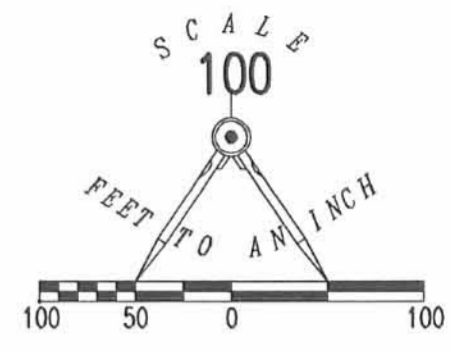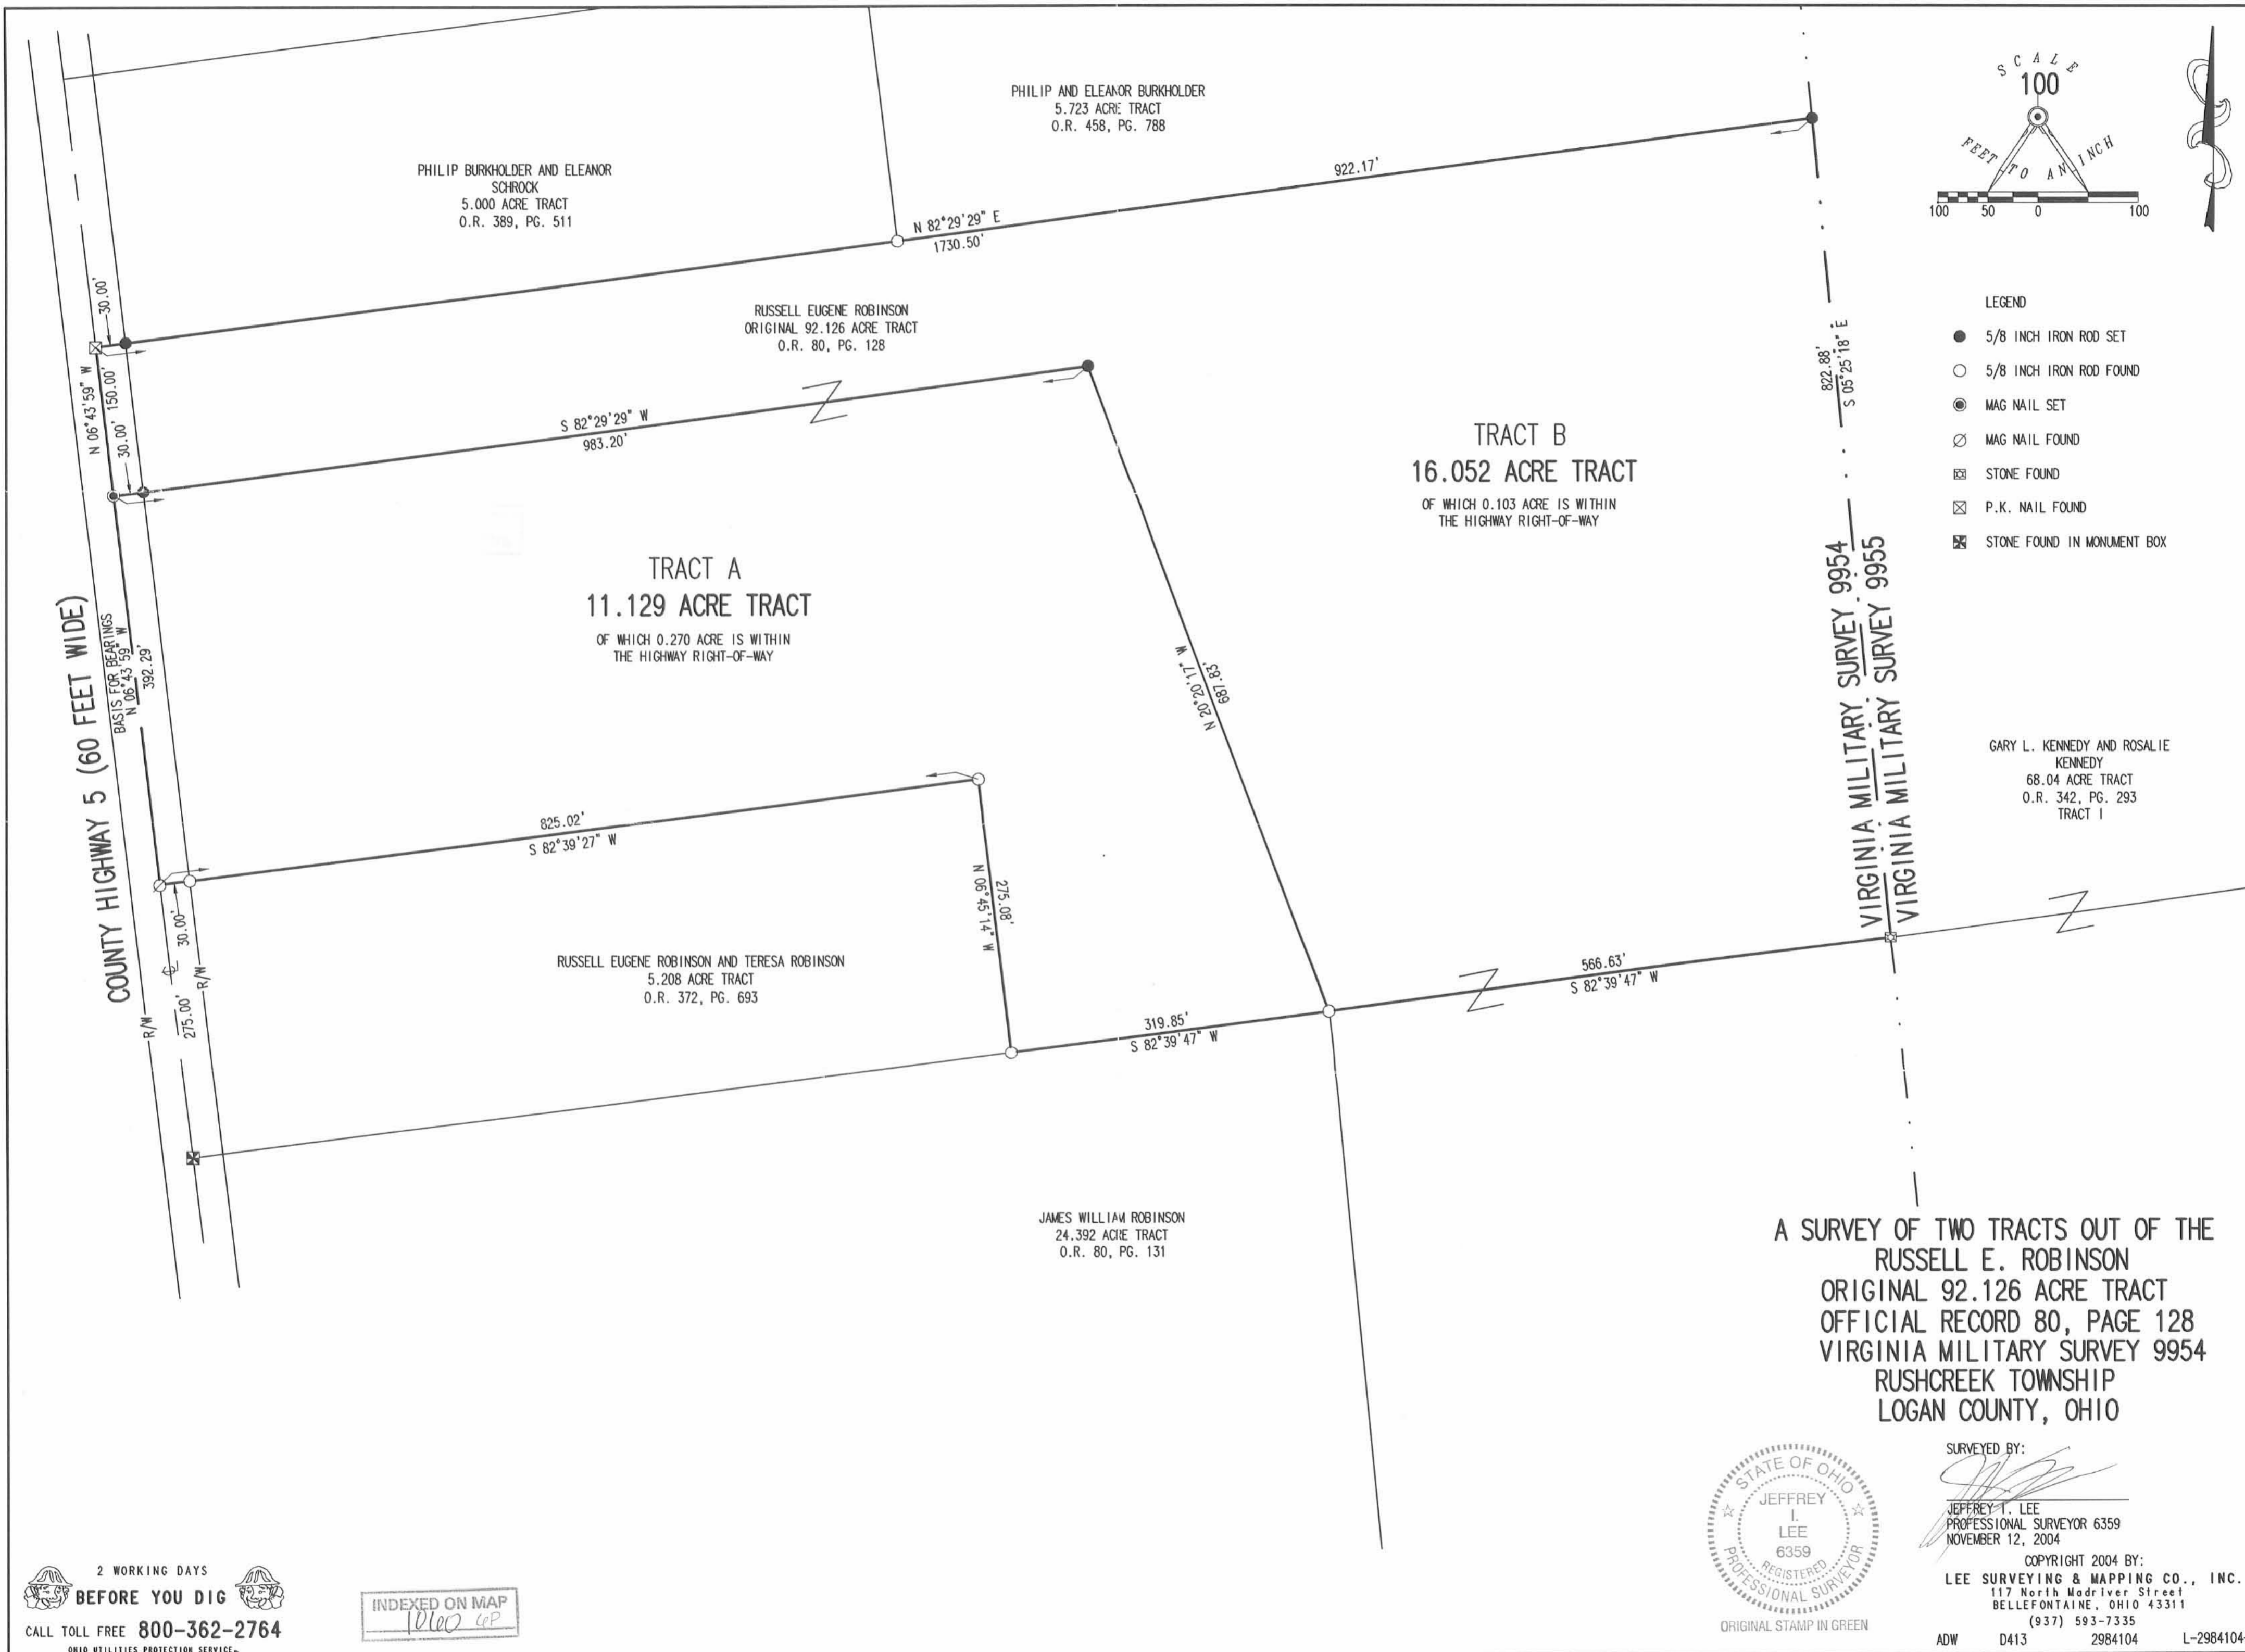

- LEGEND
- 5/8 INCH IRON ROD SET
 - 5/8 INCH IRON ROD FOUND
 - MAG NAIL SET
 - MAG NAIL FOUND
 - ⊠ STONE FOUND
 - ⊠ P.K. NAIL FOUND
 - ⊠ STONE FOUND IN MONUMENT BOX

A SURVEY OF TWO TRACTS OUT OF THE
 RUSSELL E. ROBINSON
 ORIGINAL 92.126 ACRE TRACT
 OFFICIAL RECORD 80, PAGE 128
 VIRGINIA MILITARY SURVEY 9954
 RUSHCREEK TOWNSHIP
 LOGAN COUNTY, OHIO



SURVEYED BY:
 JEFFREY I. LEE
 PROFESSIONAL SURVEYOR 6359
 NOVEMBER 12, 2004

COPYRIGHT 2004 BY:
 LEE SURVEYING & MAPPING CO., INC.
 117 North Madriver Street
 BELLEFONTAINE, OHIO 43311
 (937) 593-7335
 ADW D413 2984104 L-2984104-2

2 WORKING DAYS
BEFORE YOU DIG
 CALL TOLL FREE 800-362-2764
 OHIO UTILITIES PROTECTION SERVICE

INDEXED ON MAP
 10/10/04

SURVEY FOR PHILIP BURKHOLDER

81.793 Acres

February 20, 2012

The following described 81.793 acre tract is situated in the State of Ohio, County of Logan, Township of Rushcreek, V.M.S. 9954, being all of Philip Burkholder and Eleanor R. Burkholder, Trustees' 43.83 acre tract described in Official Record 1046, page 911, all of their 5.000 acre tract described in Official Record 907, page 875, all of their 5.723 acre tract described in Official Record 907, page 878, all of their 11.129 acre tract described in Official Record 1056, page 671, and all of their 16.052 acre tract described in Official Record 907, page 881;

Beginning at a 5/8 inch iron pin found with cap marked "LOGAN COUNTY ENGINEER" in a monument box, referenced as a PI for the centerline of County Road 5 (60 feet wide) and being at Station 98+72.34 as found in Logan County Engineers survey index R-9480 (FB 711, Pg. 39) for Rushcreek Township, said iron pin being at the northwest corner of said 43.83 acre tract and at the southwest corner of William F. Crumm and C. Jeanette Crumm's 40 acre Tract Two described in Deed Record 229, page 106, and said iron pin marking the **place of beginning**;

Thence **North 82°40'12" East (assumed bearing) 1751.79 feet**, departing from the centerline of County Road 5 and following the north line of said 43.83 acre tract and the south line of said 40.00 acre tract, passing at 30.00 feet an iron pin set, to an iron pin set in the east line of V.M.S. 9954, in the west line of V.M.S. 9955, and in the west line of Ronald D. Kensler and Pauline J. Kensler's 98.989 acre tract described in Official Record 146, page 146;


Thence **South 06°45'40" East 553.00 feet**, following an east line of said 43.83 acre tract and V.M.S. 9954, and following the west line of said 98.989 acre tract and V.M.S. 9955, to a stone found at the northwest corner of The Fulkerson Farms Family Limited Partnership's 60 acre Tract 4 described in Official Record 324, page 221;

Thence **South 05°02'39" East 538.97 feet**, following an east line of said 43.83 acre tract and V.M.S. 9954, and following a west line of said 60 acre tract and V.M.S. 9955, to an 8 inch wood corner post found at the northeast corner of said 5.723 acre tract;

Thence **South 05°42'09" East 269.69 feet**, following the east line of said 5.723 acre tract and V.M.S. 9954, a west line of said 60 acre tract and V.M.S. 9955, and the west line of Gary L. Kennedy and Rosalie Kennedy's 68.04 acre Tract I described in Official Record 342, page 293, to a 5/8 inch iron pin found with cap marked "LEE PS 6359" at the northeast corner of said 16.052 acre tract;

Thence **South 05°25'29" East 822.27 feet**, following the east line of said 16.052 acre tract and V.M.S. 9954, and the west line of said 68.04 acre tract and V.M.S. 9955, to a stone found at the northeast corner of James William Robinson's 12.139 acre tract described in Official Record 248, page 454 and at the northwest corner of Gary L. Kennedy and Rosalie Kennedy's 28.72 acre Tract III described in Official Record 342, page 293;

Thence **South 82°39'14" West 887.05 feet**, entering V.M.S. 9954, following a south line of said 16.052 acre tract and said 11.129 acre tract, following the north line of said 12.139 acre tract and the north line of James William Robinson's 24.392 acre tract described in Official Record 80, page 131, to a 5/8 inch iron pin found with cap marked "LEE PS 6359" at the southeast corner of Russell Eugene Robinson's 5.208 acre tract described in Official Record 833, page 429;

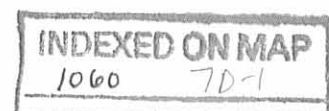

Thence **North 06°43'31" West 275.00 feet**, following a west line of said 11.129 acre tract and the east line of said 5.208 acre tract, to a 5/8 inch iron pin found with cap marked "LEE PS 6359";


Thence **South 82°39'38" West 824.80 feet**, following a south line of said 11.129 acre tract and the north line of said 5.208 acre tract, passing at 794.90 feet an iron pin found with cap marked "LEE PS 6359", to a magnetic nail found in the centerline of County Road 5;

Thence **North 06°43'59" West 816.72 feet**, following the centerline of County Road 5 and the west line of said 11.129 acre tract, the west line of said 16.052 acre tract, the west line of said 5.000 acre tract, and the west line of said 43.83 acre tract, to a 5/8 inch iron pin found with cap marked "LOGAN COUNTY ENGINEER" in a monument box at PI Station 87+80.68;

Thence **North 06°46'20" West 1091.69 feet**, following the centerline of County Road 5 and the west line of said 43.83 acre tract, to the **place of beginning, containing 81.793 acres**, more or less, and being subject to all valid easements and restrictions of record. Of the above described 81.793 acre tract, 1.314 acres are within the right of way of County Road 5.

The above description was prepared from a field survey made under the supervision of Paul R. Clapsaddle, Registered Surveyor #6140, during the month of February 2012. Bearings indicated herein are based on an assumed bearing with all others based on angles turned. Iron pins set are 5/8 inch by 30 inch reinforcing rods with caps marked "CLAPSADDLE RS, #6140".

ATTEST: Paul R. Clapsaddle
Paul R. Clapsaddle, R.S. #6140
19019 West Darby Road
Marysville, Ohio 43040
(937) 747-2599

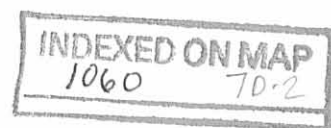

REID 2-29-12 smy au

BURKHOLDER SURVEY

STATE OF OHIO
COUNTY OF LOGAN
TOWNSHIP OF RUSHCREEK
V.M.S. 9954

LEGEND:

- Magnetic nail found
- 5/8 inch iron pin set with cap marked "CLAPSADDLE RS#6140"
- ⊙ 5/8 inch iron pin found with cap marked "LEE PS 6359"
- 5/8 inch iron pin found with cap marked "Logan County Engineer" in a monument box
- △ Stone found partially above grade
- 8 Inch wood corner post found


NOTES:

Reference deeds are shown hereon

Bearings indicated hereon are based on an assumed meridian with all others based on angles turned

SURVEY REFERENCES:

Rushcreek Twp. File R-9480 (C.R. 5 plans)
Rushcreek Twp. File R-7854
Rushcreek Twp. File R-3368

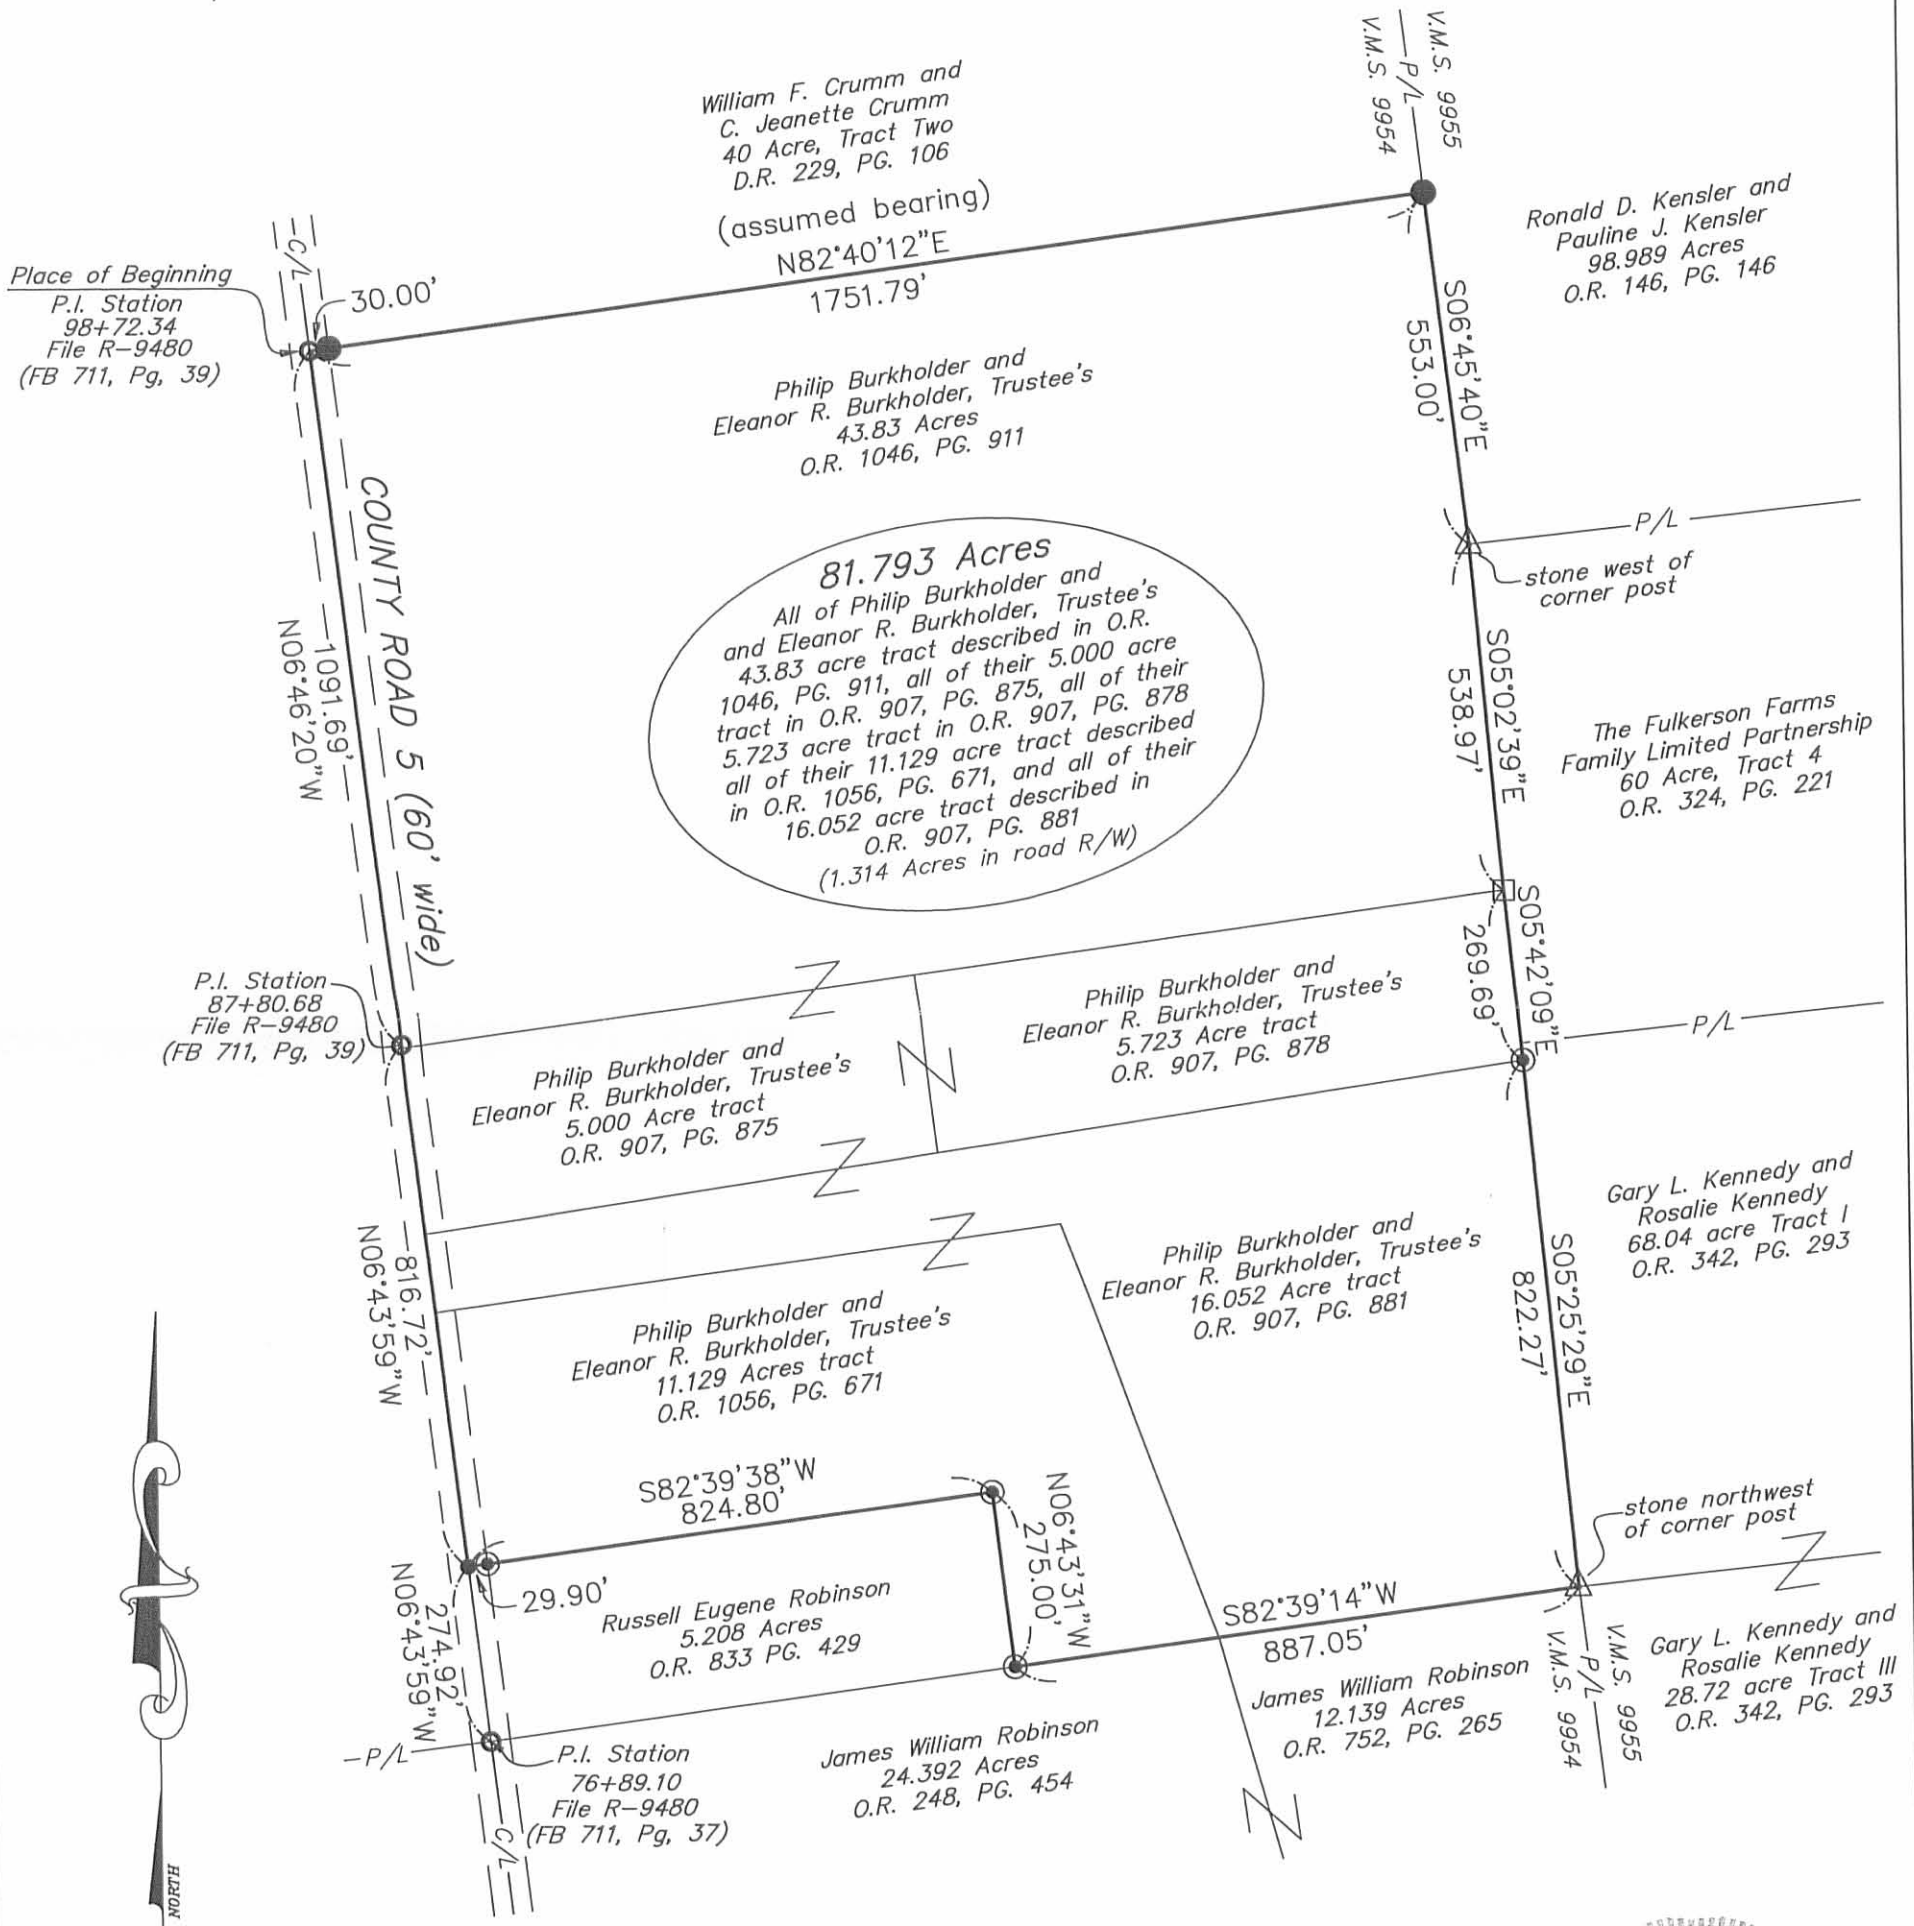

Paul R. Clapsaddle and Associates

REGISTERED ENGINEERS AND SURVEYORS

19019 WEST DARBY ROAD, MARYSVILLE OHIO 43040
(937) 747-2599

Paul R. Clapsaddle, P.E., P.S.

I hereby certify that this plat was prepared from a field survey made under my supervision and that monuments were placed as indicated hereon.

Paul R. Clapsaddle
Paul R. Clapsaddle, R.S. #6140

Date: February 20, 2012
Scale: 1"=300'
Project: BurkholderJan12
Drawing: BurkholderJan2012

INDEXED ON MAP
R-1060 7P

7-7-14

APPROVED

SURVEY FOR PHILIP BURKHOLDER

37.997 Acres

June 27, 2014

The following described 37.997 acre tract is situated in the State of Ohio, County of Logan, Township of Rushcreek, V.M.S. 9954, being part of Philip Burkholder and Eleanor R. Burkholder, Trustees' 81.793 acre tract described in Official Record 1058, page 6, and said 37.997 acre tract being more particularly described as follows;

Beginning for reference at a 5/8 inch iron pin found with cap marked "LOGAN COUNTY ENGINEER" in a monument box, referenced as a PI for the centerline of County Road 5 (60 feet wide) and being at Station 76+89.10 as found in Logan County Engineer's survey index R-9480 (FB 711, Pg. 37) for Rushcreek Township, said iron pin being at the northwest corner of James William Robinson's 24.392 acre tract described in Official Record 248, page 454, and at the southwest corner of Russell Eugene Robinson's 5.208 acre tract described in Official Record 833, page 429;

Thence North 06°43'59" West (assumed bearing) 274.92 feet, following the centerline of County Road 5 and the west line of said 5.208 acre tract, to a magnetic nail found at a southwest corner of said 81.793 acre tract, and said magnetic nail marking the *place of beginning*;

Thence *North 06°43'59" West 816.72 feet*, following the centerline of County Road 5 and a west line of said 81.793 acre tract, to a 5/8 inch iron pin found with cap marked "LOGAN COUNTY ENGINEER" in a monument box, referenced as a PI for the centerline of County Road 5 and being at Station 87+80.68 as found in Logan County Engineer's survey index R-9480 (FB 711, Pg. 38);

Thence *North 82°39'58" East 1735.44 feet*, departing from the centerline of said Road and crossing said 81.793 acre tract, passing at 30.00 feet an iron pin set, to an 8 inch wood post found in the west line of The Fulkerson Farms Family Limited Partnership's 60 acre Tract 4 described in Official Record 324, page 221, in the east line of V.M.S. 9954, and in the west line of V.M.S. 9955;

Thence *South 05°42'09" East 269.69 feet*, following an east line of said 81.793 acre tract and V.M.S. 9954, a west line of said 60 acre tract and V.M.S. 9955, and the west line of Gary L. and Rosalie Kennedy's 68.04 acre Tract I described in Official Record 342, page 293, to a 5/8 inch iron pin found with cap marked "LEE PS 6359";

Thence *South 05°25'29" East 822.27 feet*, following an east line of said 81.793 acre tract and V.M.S. 9954, and the west line of said 68.04 acre tract and V.M.S. 9955, to a stone found at the northeast corner of James William Robinson's 12.139 acre tract described in Official Record 752, page 265 and at the northwest corner of Gary L. and Rosalie Kennedy's 28.72 acre Tract III described in Official Record 342, page 293;


Thence *South 82°39'14" West 887.05 feet*, entering V.M.S. 9954, following a south line of said 81.793 acre tract, the north line of said 12.139 acre tract, and the north line of said 24.392 acre tract, to a 5/8 inch iron pin found with cap marked "LEE PS 6359" at the southeast corner of said 5.208 acre tract;

Thence *North 06°43'31" West 275.00 feet*, following a west line of said 81.793 acre tract and the east line of said 5.208 acre tract, to a 5/8 inch iron pin found with cap marked "LEE PS 6359";

Thence *South 82°39'38" West 824.80 feet*, following a south line of said 81.793 acre tract and the north line of said 5.208 acre tract, passing at 794.90 feet an iron pin found with cap marked "LEE PS 6359", to the *place of beginning, containing 37.997 acres*, more or less, and being subject to all valid easements and restrictions of record. Of the above described 37.997 acre tract, 0.562 acre is within the right of way of County Road 5.

The above description was prepared from a field survey made under the supervision of Paul R. Clapsaddle, Registered Surveyor #6140, during the month of June 2014. Bearings indicated herein are based on an assumed bearing with all others based on angles turned. Iron pins set are 5/8 inch by 30 inch reinforcing rods with caps marked "CLAPSADDLE RS #6140".

ATTEST:

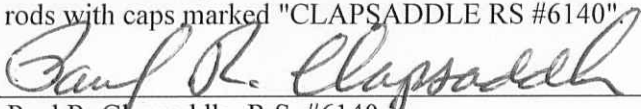

Paul R. Clapsaddle, R.S. #6140
19019 West Darby Road
Marysville, Ohio 43040
(937) 747-2599




INDEXED ON MAP
1060 8D

7-7-14

APPROVED

PLAT OF SURVEY FOR PHILIP BURKHOLDER

STATE OF OHIO
COUNTY OF LOGAN
TOWNSHIP OF RUSHCREEK
V.M.S. 9954

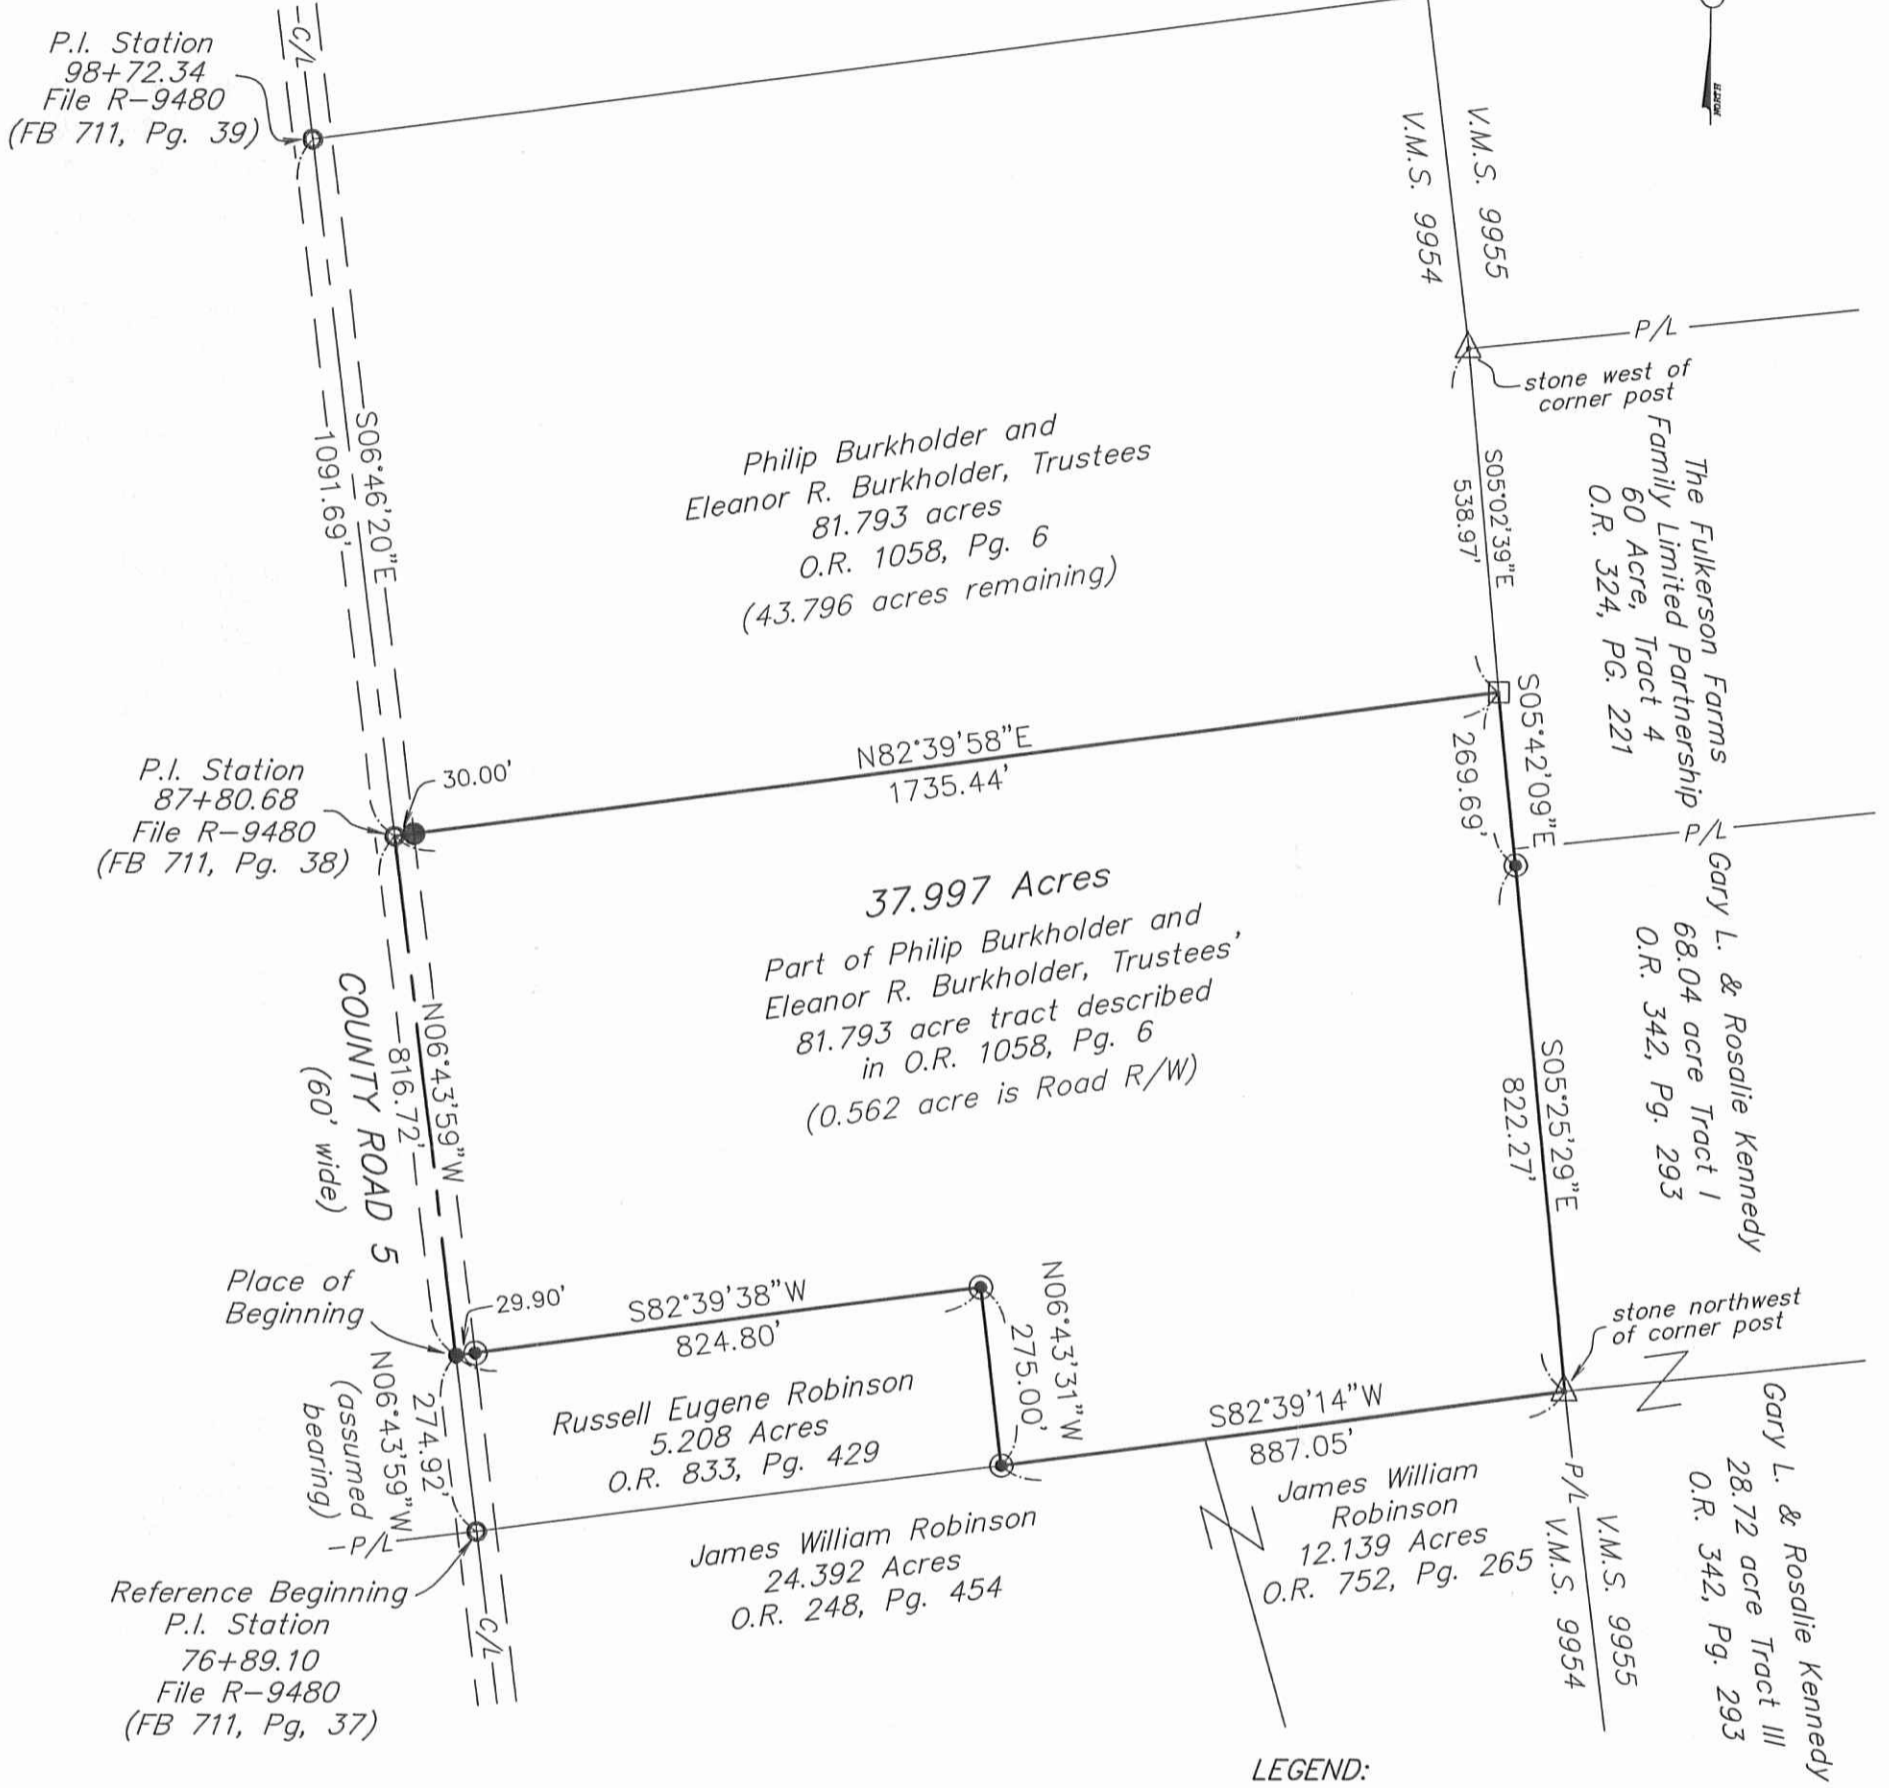

NOTES:

Reference deeds are shown hereon
Bearings indicated hereon are based on an assumed meridian with all others based on angles turned

SURVEY REFERENCES:

Rushcreek Twp. File R-9480 (C.R. 5 plans)
Rushcreek Twp. File R-7854
Rushcreek Twp. File R-3368



LEGEND:

- Magnetic nail found
- 5/8 inch iron pin set with cap marked "CLAPSADDLE RS#6140"
- ⊙ 5/8 inch iron pin found with cap marked "LEE PS 6359"
- 5/8 inch iron pin found with cap marked "Logan County Engineer" in a monument box
- △ Stone found partially above grade
- 8 Inch wood corner post found

Paul R. Clapsaddle and Associates
REGISTERED ENGINEERS AND SURVEYORS
19019 WEST DARBY ROAD, MARYSVILLE OHIO 43040
(937) 747-2599

Paul R. Clapsaddle, P.E., P.S.

Date: June 23, 2014
Scale: 1"=300'
Project: BurkholderJan12
Drawing: BurkholderJune2014

I hereby certify that this plat was prepared from a field survey made under my supervision and that monuments were placed as indicated hereon.

Paul R. Clapsaddle
Paul R. Clapsaddle, R.S. #6140

INDEXED ON MAP
1060 8P



George Clayton
Page 2 of 4
January 30, 2020

Parcel "A"
LEGAL DESCRIPTION

Being a part of the original 37.997 acre tract in the name of George F. Clayton (Prior Deed Reference O.R. 1152, Pg. 956) and being a part of V.M.S. 9954, Rushcreek Township, Logan County, Ohio, more particularly described as follows:

Commencing at an Existing Mag Nail, referenced as a PI for the centerline of County Road 5 (60') and being Station 98+72.34 as found in Logan County Engineer's survey index R-9480 (FB 711, Pg. 39) for Rushcreek Township, said Mag Nail being the NW corner of Michael O'Keefe's 43.796 acre tract as described in (O.R. 1291, Pg. 930); thence S 06°-14'-00" E with the centerline of said County Road 5, 1091.38' to an existing #5 Rebar at Station 87+80.68 as found in Logan County Engineer's survey index R-9480 (FB 711, Pg. 38) and being the SW corner of said 43.796 acre tract in the name of Michael O'Keefe and the NW corner of a 37.997 acre tract in the name of George F. Clayton as described in (O.R. 1152, Pg. 956) and being the POINT OF BEGINNING; thence the following courses:

1. N 83°-14'-16" E with the N line of said 37.997 acre tract and the S line of said 43.796 acre tract, 1733.95' to an existing 8" Wood Corner Post at the NE corner of said 37.997 acre tract and being the W line of a 60 acre tract in the name of The Fulkerson Farms Family Limited Partnership as described in (O.R. 324, Pg. 221, Tract 4) and being the E line of V.M.S. 9954 and the W line of V.M.S. 9955, passing a #5 Rebar set at 30.00';
2. S 05°-12'-40" E with the E lines of said 37.997 acre tract and V.M.S. 9954 and the W lines of said 60 acre tract and V.M.S. 9955, 269.30' to a set #5 Rebar on the E line of said 37.997 acre tract and the W line of a 68.04 acre tract in the name of Gary L. & Rosalie Kennedy, Revocable Living Trust as described in (O.R. 1190, Pg. 168, Tract I);
3. S 04°-56'-00" E with the E lines of said 37.997 acre tract and V.M.S. 9954 and the W lines of said 68.04 acre tract and V.M.S. 9955, 821.89' to an existing stone at the SE corner of said 37.997 acre tract and the NE corner of a 12.139 acre tract in the name of James William Robinson as described in (O.R. 752, Pg. 265), all being in V.M.S. 9954, and the SW corner of said 68.04 acre tract and NW corner of a 28.720 acre tract in the name of Gary L. & Rosalie Kennedy, Revocable Living Trust as described in (O.R. 1190, Pg. 168, Tract III), all being in V.M.S. 9955;
4. S 83°-12'-26" W with the S line of said 37.997 acre tract and the N lines of said 12.139 acre tract and a 24.392 acre tract in the name of James William Robinson as described in (O.R. 248, Pg. 454), 886.98' to a #5 Rebar set at the SE corner of a 5.208 acre tract in the name of Russell Eugene Robinson as described in (O.R. 833, Pg. 429) and being the SW corner of said 37.997 acre tract;
5. N 06°-12'-41" W with the W line of said 37.997 acre tract and the E line of said 5.208 acre tract, 275.00' to a #5 Rebar set at the NE corner of said 5.208 acre tract;
6. N 06°-09'-04" W into and through said 37.997 acre tract, 264.09' to a set #5 Rebar;
7. Continuing into and through said 37.997 acre tract S 83°-12'-10" W, 824.80' to a Mag Nail set in the centerline of said County Road 5, passing a #5 Rebar set at 794.80';
8. N 06°-09'-04" W with the centerline of said County Road 5, 552.61' to the POINT OF BEGINNING.



The above described parcel contains 32.964 acres, more or less, of which 0.381 acres are occupied by road right-of-way, subject to all legal highways and easements of record.

The system of bearings for this legal description is based on the Ohio State Plane-North Coordinate System NAD83 (2011). This legal description and accompanying plat represent an actual boundary survey completed under the direct supervision of Kyle J. Binkley, P.S. #8587 on January 30, 2020. All markers called for above are in place.



A handwritten signature in black ink, appearing to read "K. J. Binkley".

INDEXED ON MAP
1060

5-2-2020



George Clayton
Page 4 of 4
January 30, 2020

Parcel "B"
LEGAL DESCRIPTION


Being a part of the original 37.997 acre tract in the name of George F. Clayton (Prior Deed Reference O.R. 1152, Pg. 956) and being a part of V.M.S. 9954, Rushcreek Township, Logan County, Ohio, more particularly described as follows:

Commencing at an Existing Mag Nail, referenced as a PI for the centerline of County Road 5 (60') and being Station 98+72.34 as found in Logan County Engineer's survey index R-9480 (FB 711, Pg. 39) for Rushcreek Township, said Mag Nail being the NW corner of Michael O'Keefe's 43.796 acre tract as described in (O.R. 1291, Pg. 930); thence S 06°-14'-00" E with the centerline of said County Road 5, 1091.38' to an existing #5 Rebar at Station 87+80.68 as found in Logan County Engineer's survey index R-9480 (FB 711, Pg. 38) and being the SW corner of said 43.796 acre tract in the name of Michael O'Keefe and the NW corner of a 37.997 acre tract in the name of George F. Clayton as described in (O.R. 1152, Pg. 956); thence S 06°-09'-04" E with said centerline of County Road 5, 552.61' to a Mag Nail set at the POINT OF BEGINNING; thence the following courses:

1. N 83°-12'-10" E into and through said 37.997 acre tract, 824.80' to a set #5 Rebar, passing a set #5 Rebar at 30.00';
2. Continuing into and through said 37.997 acre tract S 06°-09'-04" E, 264.09' to a #5 Rebar set at the NE corner of a 5.208 acre tract in the name of Russell Eugene Robinson as described in (O.R. 833, Pg. 429);
3. S 83°-12'-10" W with the N line of said 5.208 acre tract and the S line of said 37.997 acre tract, 824.80' to an existing Mag Nail in the centerline of said County Road 5, passing an existing #5 Rebar at 794.80';
4. N 06°-09'-04" W with the centerline of said County Road 5, 264.09' to the POINT OF BEGINNING.

The above described parcel contains 5.000 acres, more or less, of which 0.182 acres are occupied by road right-of-way, subject to all legal highways and easements of record.

The system of bearings for this legal description is based on the Ohio State Plane-North Coordinate System NAD83 (2011). This legal description and accompanying plat represent an actual boundary survey completed under the direct supervision of Kyle J. Binkley, P.S. #8587 on January 30, 2020. All markers called for above are in place.

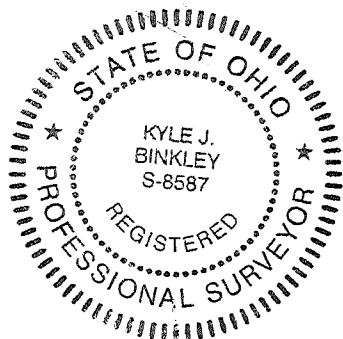


3-2-2020

APPROVED

Survey of Parcel #40-024-00-00-040-001 and being all of the 37.997 acre tract in the name of George F. Clayton and being located in V.M.S. 9954, Rushcreek Township, Logan County, Ohio.

(Prior Deed Referenced in O.R. 1152, Pg. 956)

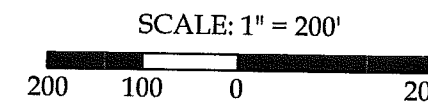

GRAPHIC SCALE

Legend

- A = Existing 8" Wood Corner Post
- B = Existing Mag Nail
- C = Existing #5 Rebar
- D = Existing Stone
- E = Set #5 Rebar
- F = Set Mag Nail




This plat and the accompanying legal descriptions represent an actual boundary survey completed under my direct supervision on January 30, 2020.

Kyle J. Binkley, P.S. #8587

Binkley
LAND SURVEYING, LLC
121 W. Auglaize Street
Wapakoneta, Ohio 45895
(419) 236-3768

CLIENT: George Clayton			
SURVEYED BY: T.J.S./T.E.W.	DATE: 01-30-2020	DRAWN BY: K.J.B.	CHECKED BY: K.J.B.
SCALE: 1" = 200'	PAGE 1	OF 1	PAGES 4

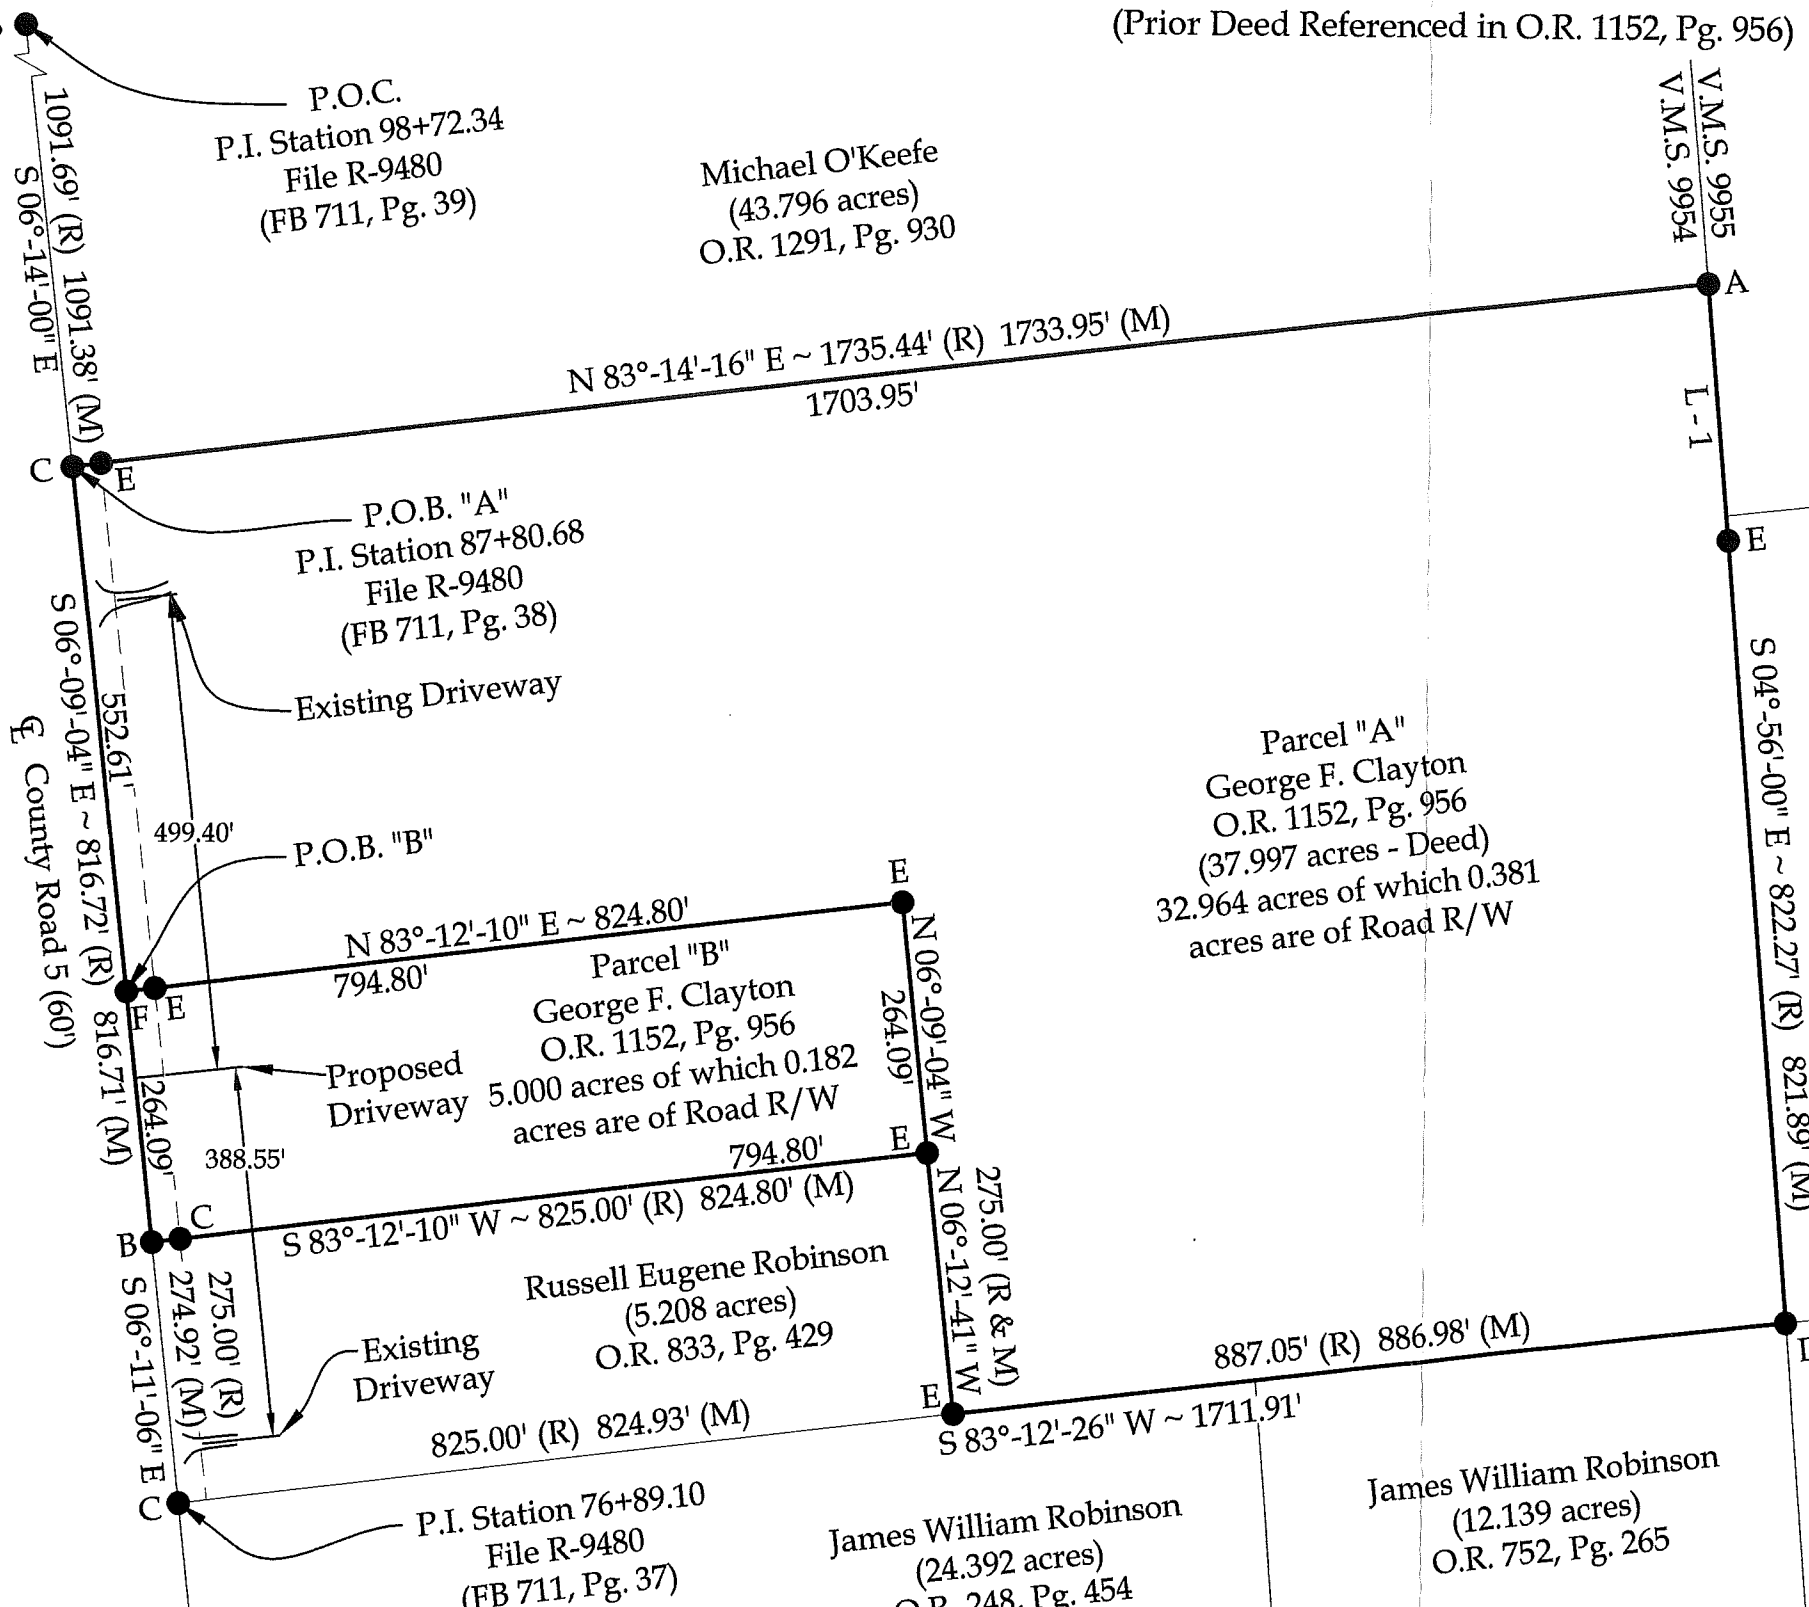

BASIS OF BEARINGS: The system of bearings for this plat and legal description is based on the Ohio State Plane - North Coordinate System.

NOTE: All distances on this plat are measured unless otherwise noted.

Line Data

L - 1 = S 05°-12'-40" E ~ 269.69' (R) 269.30' (M)

INDEXED ON MAP
1060