

Road. 126
Rushcreek Twp.

40' Road, Commissioners Journal. 10
Pages - 5 - 77 - 28




Stake 1-3-5 etc.

(No stakes found in Jefferson Twp.)

1494
INDEXED ON MAP

Sept, 6-1933
Clear
Wright

12+60
stone found
0'-07 Right
Held G. H. H. B.
Old Sta. B

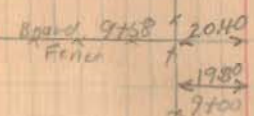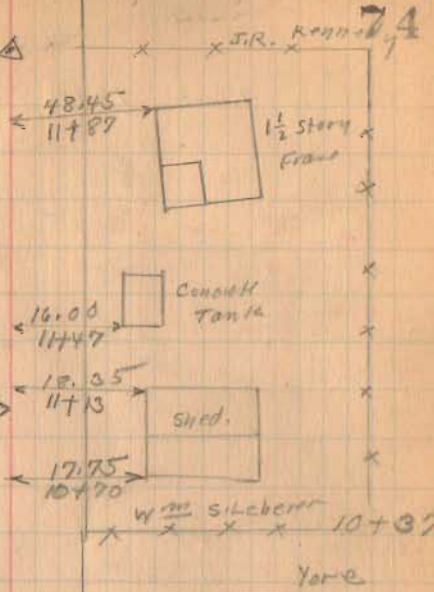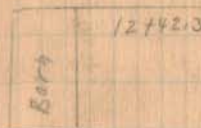

V.M.S. 3325

W. S. & W. K.
Lehrer

V.M.S. 3326

A. Yore

S.H. 236
Route 47

Apartment &
Sta. 0+00

L.C. Bell.

A. Yore.

V.M.S. 3314

V.M.S. 3323

Road 126.

1894
INDEXED ON MAP

9-6-33

75



Bridge
126-1.80
concrete
Bot.

Jefferson

Post
25+21

Township

Rush Creek

Township

Mr Kennels
says Tag Line
Very Close to
25+00

18+91.5

16+45



No Fence

15+0?

Road. 126.

Length 5043 Feet
Length. 9551 Miles

1494
INDEXED ON MAP

9-6-33 76

L.W. Russel.

Road 127

W.S. & W.K.
Lehrer

Road. 126
500 Park 580
Page 16

FD 3/15/71
L.H.G.

PLACED SPIKE OVER
STONE


Elmer
Richardson

Road 127

Lulu Carter

V.M.S. 3325

V.M.S. 3326

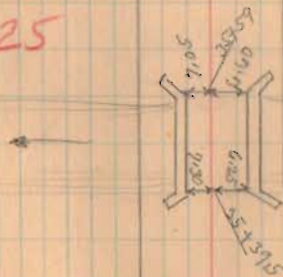

Bridge
126-165

Dug for sand
No Luck.
No Angle

L.L. Carter

x 50 x 29 x

Lane Kennedy