


Road # 25

Stakes for fence - F.M. Shoals Farm



V.M.S. 3320 - Rushcreek Twp.

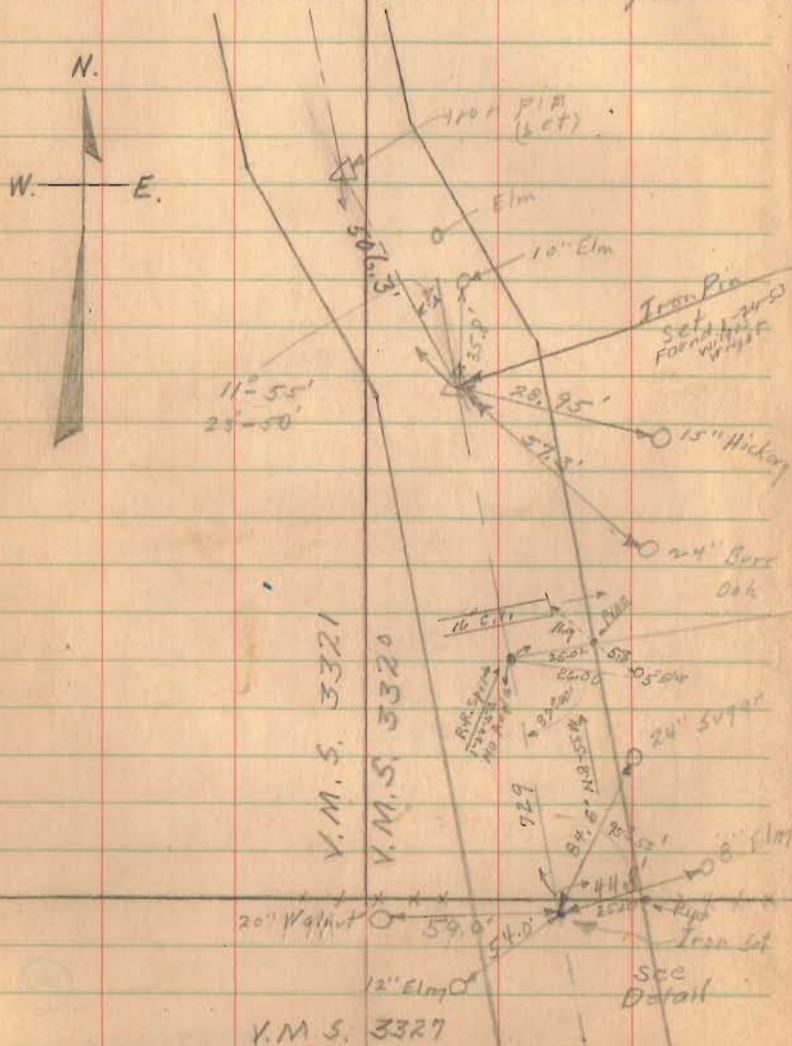

August 7, 1937
E. Core
M. Jones
J. Inskoop
G. Inskoop

13

Stakes set 25' from 4 50' Road.

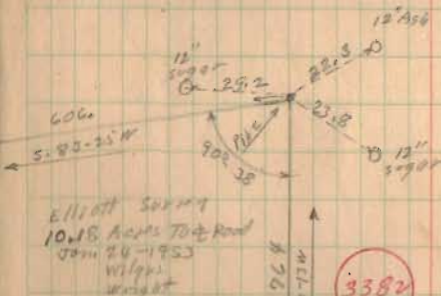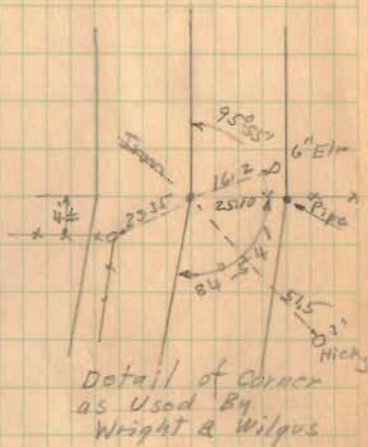

Elliott Spring
10.15 Acres to Road
from 24-1933
Wright & Wilgus

3382

INDEXED ON MAP

F.M. Shoals

185

N. 27-00E

H.C. Corwin

1812

INDEXED ON MAP