HEMPY SURVEY

OCTOBER, 1974

The following described real estate situated in Virginia
Military Survey No. 9909 and Virginia Military Survey No. 9887,
Rushcreek Township, Logan County, Ohio and being more particularly
described as follows:

Beginning at an iron bar in the centerline of County Highway No. 118 at Station 19+69.02; thence N.15°24.6'E. 864.2 feet to a corner post; thence S.67°04.2'E. 458.2 feet to an iron bar; thence S. 13°58'W. 427.6 feet to an iron bar; thence S.78°47.3'E. 19.3 feet to an iron bar; thence 30.0 feet west of and parallel with the west line of Bruce Fawcett's 13.50 acre tract S.4°34.2'W. 231.5 feet to an iron bar; thence continuing 30.0 feet from and parallel with said Fawcett's line S.55°00'W. 172.8 feet to an iron bar in the centerline of C.R.118; thence with said centerline N.77°00'W. 418.1 feet to the place of beginning.

Containing 8.98 acres more or less.

The above described 8.98 acres being 4.14 acres in A.M.


A.4-2.

Hempy's 181-42 acre tract ANO 4.84 ACRES IN AM HEMPY'S 96.82 ACTEACT.

I hereby certify that the above is a true and accurate description of a survey made by me.

Leslie H. Geeslin Reg.Surveyor 5248 Rushsylvania, Ohio 43327



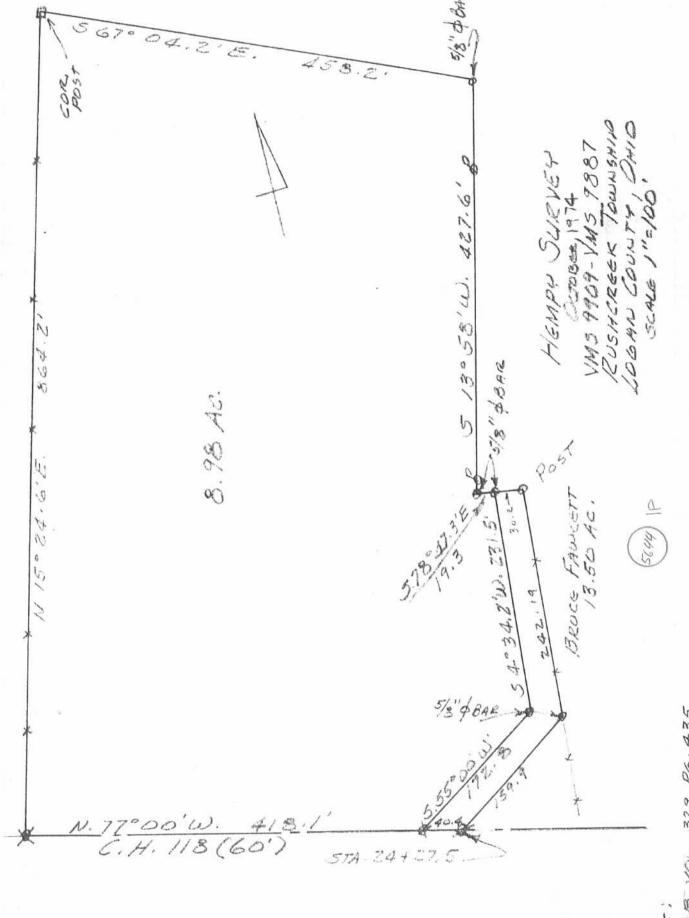

Reg. SURVEYOR 5248 RUSHSYLVANIA, OHIO Lesus M. GeesLIN

INDEXED ON MAP

63 PG 514-515

D.B. 40. 329 PG. 435 D.B. 104. 203 FB 99 D.B. VOL.

REF: