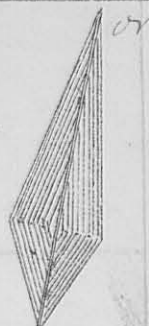


A

County Road ✓

B

8564

Surrey  
no 535

Line established

January 28<sup>th</sup> 1845 and by adjournment on account of inclement weather until the 8<sup>th</sup> of May 1845 on presentation to me of the following Notice and being satisfied that it had been served at least twenty days previous to date as follows "To Isaac Pratt, Richard McClure, Robert Lee, William Carr and William Collins, This is to notify you and each of you that on the 28<sup>th</sup> day of January 1845 by Alexander Morrison County Surveyor within and for the County of Logan, we intend upon said day above named to have the South line of our land surveyed and the corners correctly established. You will therefore meet with us on said day at ten o'clock December 31 1844

Thomas Ferguson  
Jah Pratt

I proceeded to make survey of the ground by beginning in a County road at a White Oak & Ash (Ash down) North East corner to survey no 9888 and chained with the East line of said

Survey 160 poles to a <sup>Pin</sup> ~~point~~ <sup>at</sup> water bank <sup>vicinity</sup> and where  
 I planted a Stone Benjamin Shoo, William Stewart,  
 Jos Miller, and William Thompson present, it  
 being the exact distance deduced to Thomas Furgason  
 then N 78° E 148 poles links to a point where I  
 planted a Stone 160 poles ~~from~~ in John Piatts  
 west line from said Piatts & ~~Thomas Furgason's~~  
~~North~~ West corner it being the exact distance  
 deduced to said Furgason present Arthur Roberts,  
 & Lanson Thompson,  
 At A is a Stone and at B said to be planted by  
 D Hapkins from which the above measure-  
 ments of 160 poles were made

} c l c r  
 } " " A. Harrison  
 A Roberts Mk 140 C. S. L. Co