


Surrey
582

(8525)

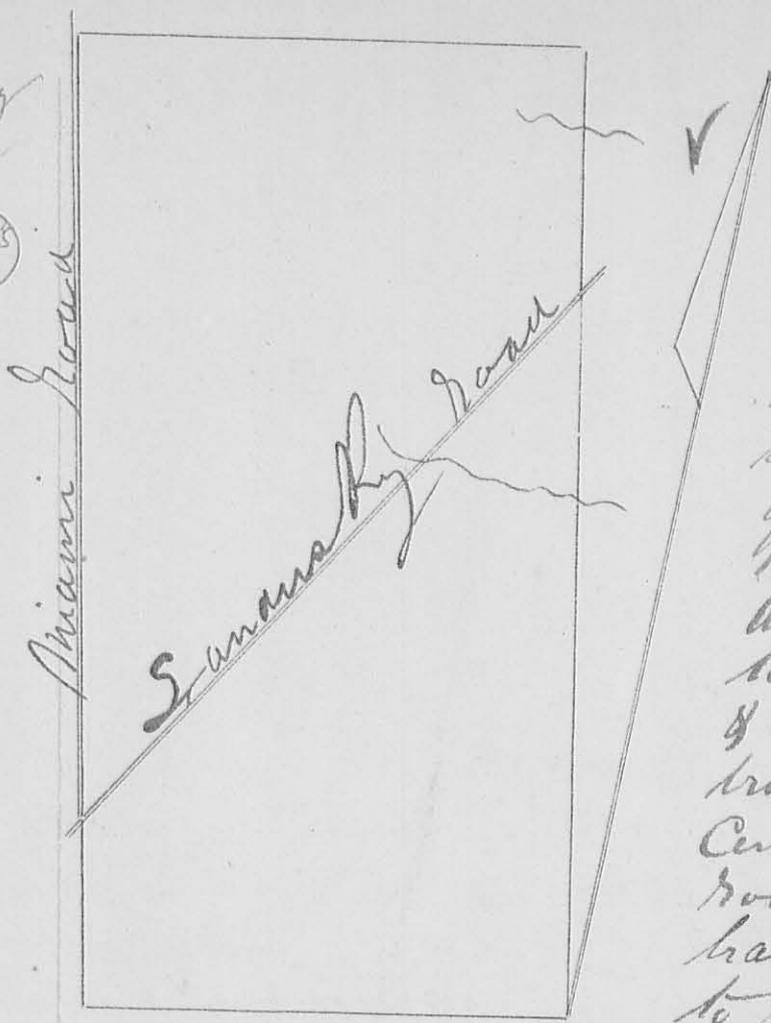

Surveyed May 13
1827 for Alex
Willson the follow-
ing described lot of
land, being a part
of Surrey or 13126
Beginning at 2 Buck
and a Hickory Corner
to Saml Mitchell
& run S 11 E 18 poles to
branch, 53 poles to
Centre of Sanana R.
Road, 93 poles to
branch 1708 173 poles
to Bush Creek 200
poles to South West
Corner of Surrey or

100211 then S 79 W 100 poles to Sugar tree
& 2 Iron Woods (all gone, stump of Sugar &
one Iron Wood standing) then N 12 W 80 poles
to Centre of ~~Sanana R. Street~~ Bush
Street, 22 poles to link to East edge of
ham plot, 30 poles to edge of Gopher
15, 38 poles to link to Centre of
Sanana R. Street, cross several branches
200 poles to 2 Buck and ash (all gone
down but stump of Buck & body of ash remain-
ing) then N 79 E 106 poles to the Beginning
containing 131⁵/₇ or acres A. H. Harbison
Wm A. Anderson
S. Vanhook 3^d Edm
C. S. L. C. C.