

REFERENCE:  
 FAWCETTS ADD.  
 BK. B, VOL. 2, PG. 68  
 □ = 2" x 2" x 24" Hub Set.

SURVEY OF  
 LOT 194  
 RUSHSVLVANIA, OHIO  
 APRIL 3, 1964  
 SCALE 1" = 30'

Dan L. Dodson  
 Dan L. Dodson  
 Reg. Surveyor 4270  
 Bellefontaine, Ohio

3674 IP

INDEXED ON MAP

LOT 194

PENNSYLVANIA

For:

RICHARD JAMES

FAWCETT ADD

Bk. B - Vol. 2, Pg. 68


○ = 1/2 Pipe Found

□ = Tied Hub Set 2'x2'x24"

Dodson  
Green

4/4/64

3

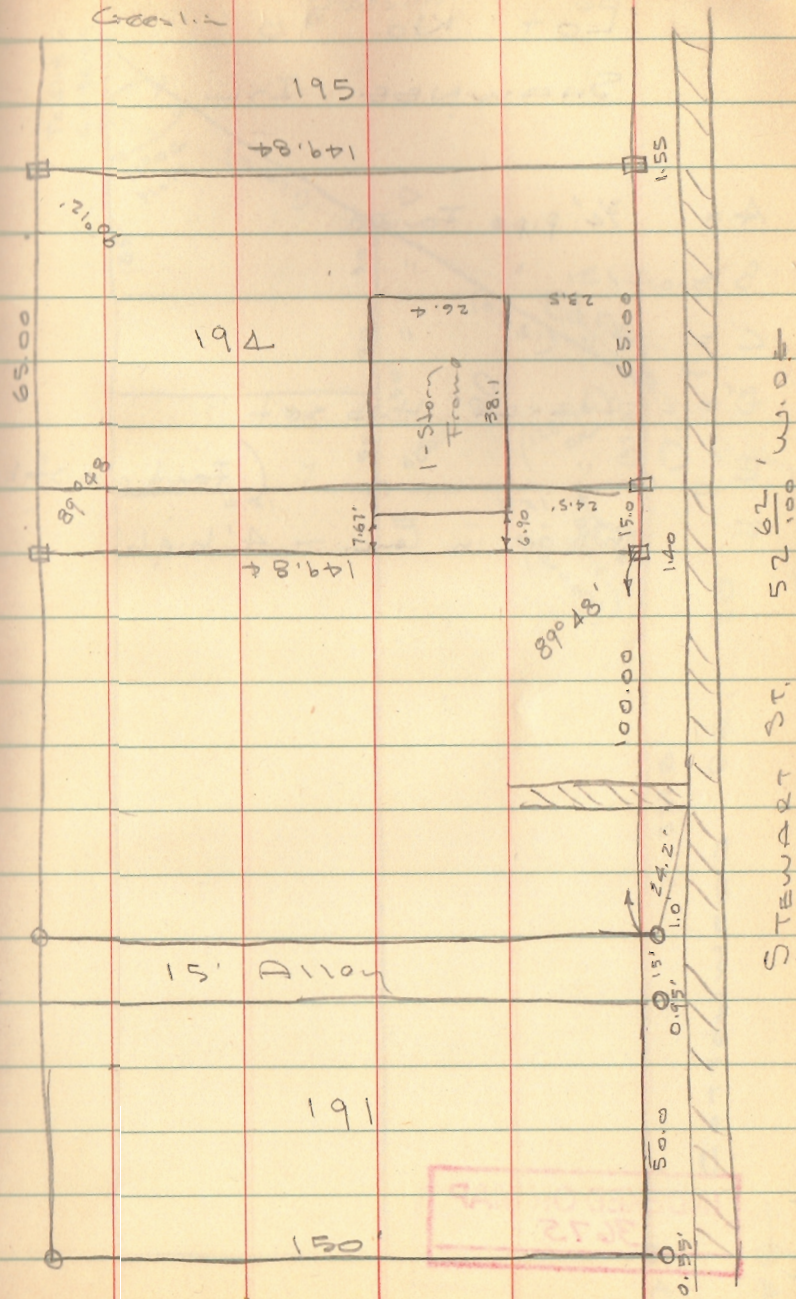

INDEXED ON MAP  
3674

3674