


SURVEY OF LOT 23
IN PENNSYLVANIA FOR
TOWNSHIP TRUSTEES

6681 IP

INDEXED ON MAP

CEESLIN
NICHOLS
SEPTEMBER, 1974

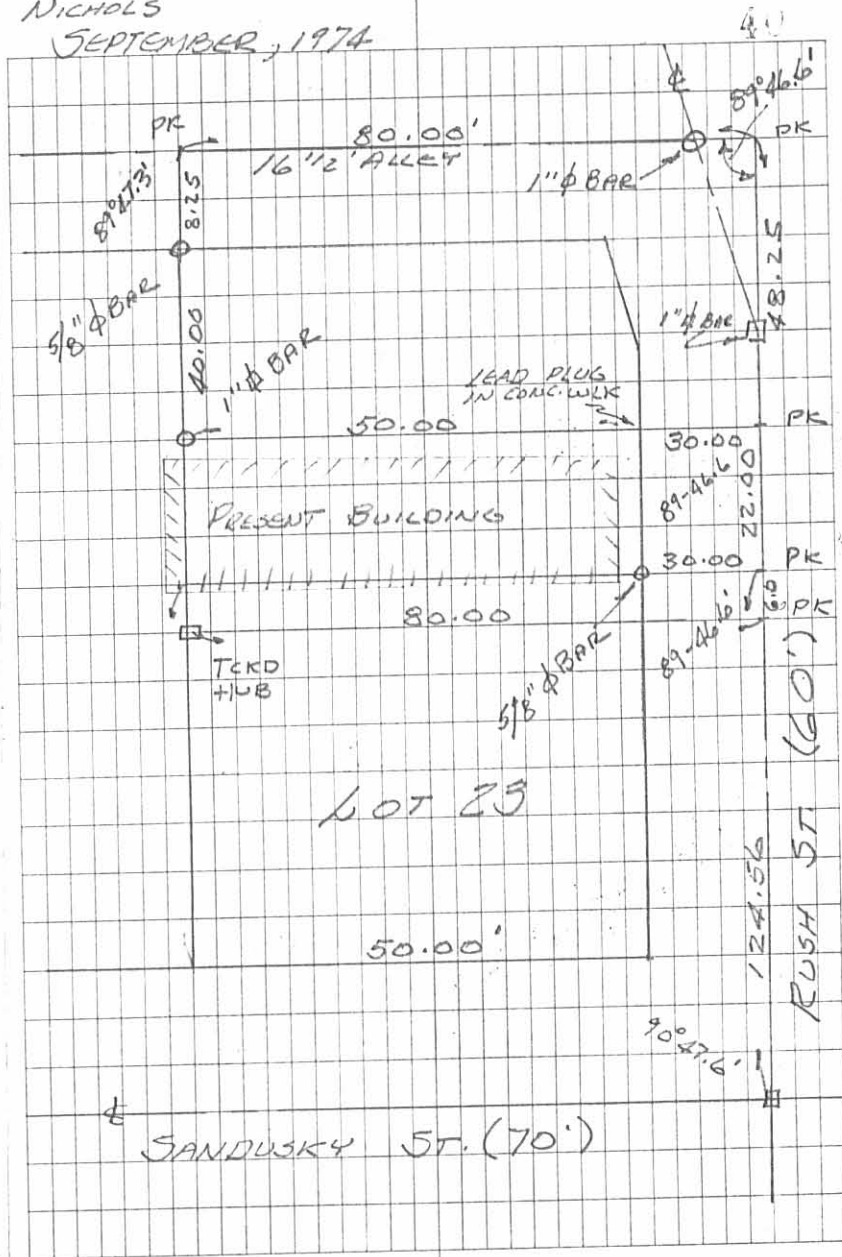

FB 708

SURVEY OF LOT 23
IN RUSHSYLVANIA FOR
TOWNSHIP TRUSTEES

6681

INDEXED ON MAP

GEEGLIN
NICHOLS
SEPTEMBER, 1974

