

Field Notes  
 Book 385 Page 32

BAY VIEW ALLOTMENT  
 RUSSELLS POINT OHIO  
 SCALE ONE INCH TO TWENTY FEET


76 IP  
 INDEXED ON MAP

LEGEND:

A = 5/8" IRON BAR SET OVER  
3/4" PIPE FD. 15" DEEP.

B = CAP & NAIL SET

C = 5/8" IRON BAR SET

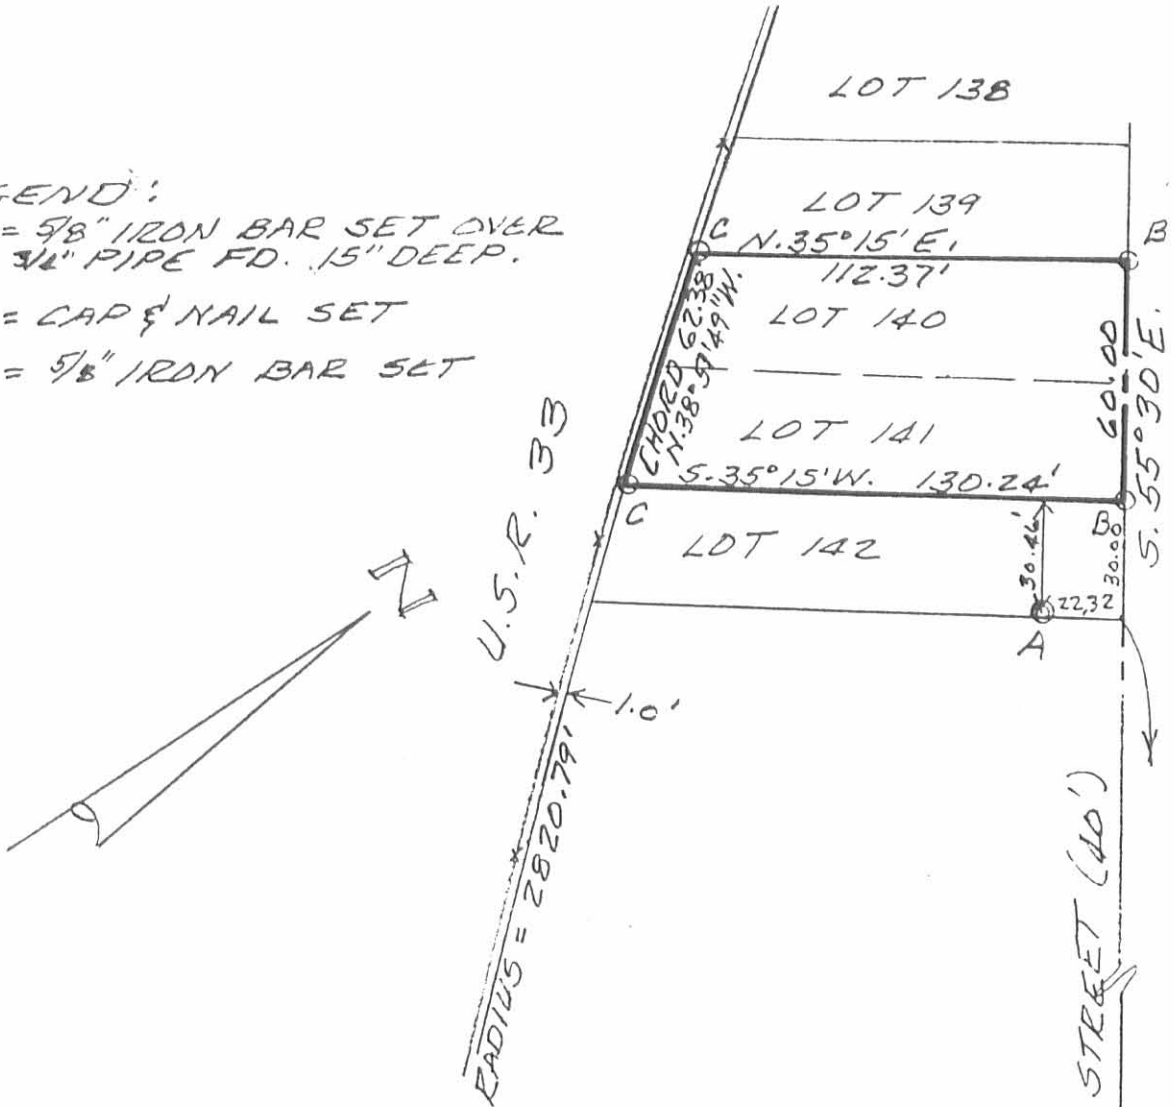

SURVEY OF LOTS 140 & 141 OF  
BAYVIEW ALLOTMENT, RUSSELLS  
POINT, OHIO FOR DAY LANE.  
FEBRUARY, 1989  
SCALE: 1" = 50'



INDEXED ON MAP  
76 2P

*Leslie H. Geeslin*  
LESLIE H. GEESLIN  
RUSHSVLVANIA, OHIO

