


Survey of Lot No. 923  
Russell Point for  
Harry Grand

- A old stake (found) set 2"x2" stake
- B old stake (found) set 2"x2" stake
- C old stake (found) set 2"x2" stake
- D old stake (found)
- E old stake (found)
- F
- G 2 1/2" iron pipe (found)

Marshall  
St

Fair View Ave

(No width shown)

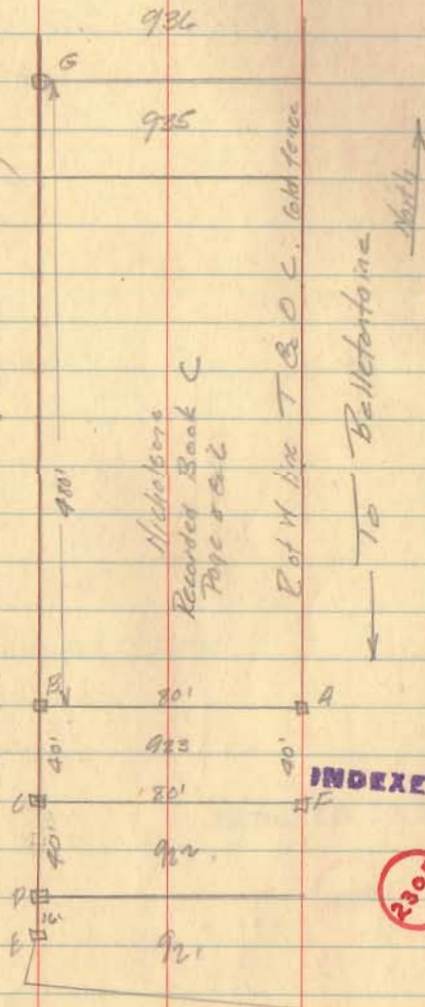

INDEXED ON MAP

2305

CA Linkcap  
JC Wheeler  
CA Miller

7/20/02

45

Fairview Ave.

- 30'

N. 11°-00'-00" W.  
Basis of Bearing

926

925

924

923

N. 78°-05'-00" E.

S. 11°-00'-00" E.

N. 11°-00'-00" W.

S. 78°-05'-00" W.

Logan County Commissioners  
Deed Vol. No. 402 P 848 (11-23-1983)  
52-032-15-09-013.000  
Part of 13.920 Acres  
1.74 Acres



Scale: 1" = 20'

SYMBOLS:

- - Magnetic P. K. Nails Set.
- ⊙ - 3/4" Iron Pipe Fd.
- - 5/8" Rebar Fd.
- - 5/8" x 30" Rebars Set.

Reference:

NICHELSONS 1st. ADDITION (3-22-1926).  
Plat Cab. A, Slides 228-229.

RIEGLE SURVEY - Lot No.'s 924-925, Village of Russells Point, Washington Township, Logan County, Ohio.		DRAWN BY DEG
SCALE: 1" = 20'	APPROVED BY:	REVISED
DATE: 9-14-2002	 Daniel E. Gilbert, P.S. Reg. Sur. No. 5402	
DRAWING NUMBER		2002 - 023

INDEXED ON MAP  
2305 IP