Coon - Slater Survey Russells Point July 1959 0.02 Acre

The following described land in the Village of Russells Point, Washington Township, Logan County, Ohio, and being in Section 36 Town 6 Range 8

Beginning at an iron in the north side of State Route Number 720 and at the west side of State Route Number 366

Thence with the west side of State Route Number 366 N. I3 - 22 W. I83.50 feet to an iron

Thence S. 76 - 45 W. 80.24 feet to an iron said iron being the beginning point of this survey

Thence N. 0 - 57 W. 52.90 fe t to an iron

Thence S. 78 - 00 W. 2I.30 feet to an iron

Thence S. 6 - 16 E. 51.75 feet to an iron

Thence N. 78 - 45 E. I6.00 feet to the place of beginning Said described tract containing 967 square feet or 0.02 of one acre.

Ween Coon Allotment Number Two is recorded the above described land will be the west part of Lot Number IZIO

Logan County Engineer

Not wildt 200 3252 ID INDEXED ON MAP

WAGGONER SURVEY

OF LOT 1207 IN COON ALLOTMENT NUMBER TWO , RUSSELS POINT , WASHINGTON TOWNSHIP , LOGAN COUNTY , OHIO .

SCALE 1" = 40'


JUNE 22, 2009



ORIGINAL PLAT - PLAT CABINET A SLIDE 371

LEGEND

- = 13/4" PIPE FOUND SET IN CONC.
- = IRON PIPE FOUND.
- \circ = 5/8 INCH IRON BAR SET.

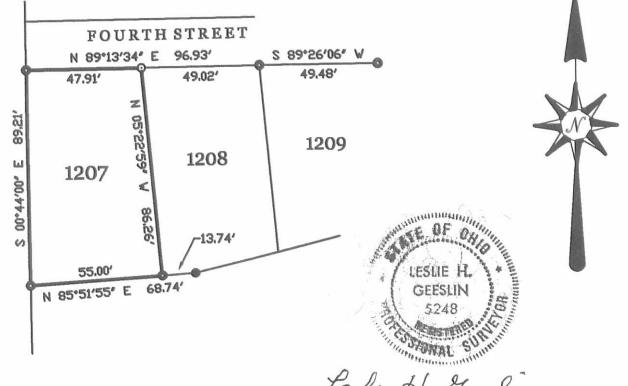

SURVEYED BY

Leslin H. Herslin

LESLIE H. GEESLIN P.S. No. 5248 LAND SURVEYING
P.D. BDX 274
RUSHSYLVANIA, DHID 43347

INDEXED ON MAP