

Received 11-4-93 OK (C.R.)

LESLIE H. GEESLIN
REGISTERED SURVEYOR NO. 5248
P.O. BOX 274
RUSHSVLVANIA, OHIO 43347
TELEPHONE: (513) 468-2793



LEE SURVEY

November 3, 1993

Leslie H. Geeslin

The following described real estate situated in the State of Ohio, County of Logan, Township of Washington, being part of Section 36, Town 6 S., Range 8 E., in the Village of Russells Point, and more particularly described as follows:

Beginning at a 1/4 inch iron pipe found in the south line of Wilgus Drive at the northeast corner of Lot 1191 of Coons Allotment No. 1 in said village.

Thence with the south line of said Wilgus Dr. S. 77° 00' 00" E. 67.77 feet to a 3/4 inch iron bar found at the intersection of said south line with the west line of W. Main Street (State Route 366).

Thence with said west line S. 12° 29' 00" E. 51.36 feet to a 5/8 inch iron bar set at the intersection of the west line of said W. Main St. with the west line of First Street.

Thence with the west line of said First St. S. 9° 04' 44" W. 49.62 feet to a 5/8 inch iron bar set at the northeast corner of Lot 1188 of said Coon Allot.

Thence with the north line of said Lot 1188 N. 87° 28' 55" W. 20.03 feet to a 5/8 inch iron bar found.

Thence N. 7° 21' 24" W. 46.35 feet to a 5/8 inch iron bar found in the south line of Lot 1190 of said Allot.

Thence with the south line of said Lot 1190 S. 86° 17' 41" W. 38.96 feet to a 3/4 inch iron pipe found at the southeast corner of said Lot 1191.

Thence with the east line of said Lot 1191 N. 3° 39' 32" W. 70.24 feet to the place of beginning.


Containing 0.124 acre more or less of which 0.095 acre is all of Lot 1190 and 0.029 acre is part of Lot 1189 of Coons Allotment No. 1.

Bearings are based on an assumed bearing (S. 77° 00' 00" E.) for the south line of Wilgus Drive as established from a survey by F. F. Wright dated June 1965 in this field survey by Leslie H. Geeslin, Reg. Surveyor 5248 on November 3, 1993.

INDEXED ON MAP
36321D

LEGEND:

- ⊙ = 1/4 INCH IRON PIPE FOUND
- ⊙ = 3/4 INCH IRON PIPE FOUND
- ⬡ = 2 INCH IRON P.C. FOUND
- = 3/8 INCH IRON PIPE FOUND
- ⊙ = 5/8 INCH IRON BAR SET

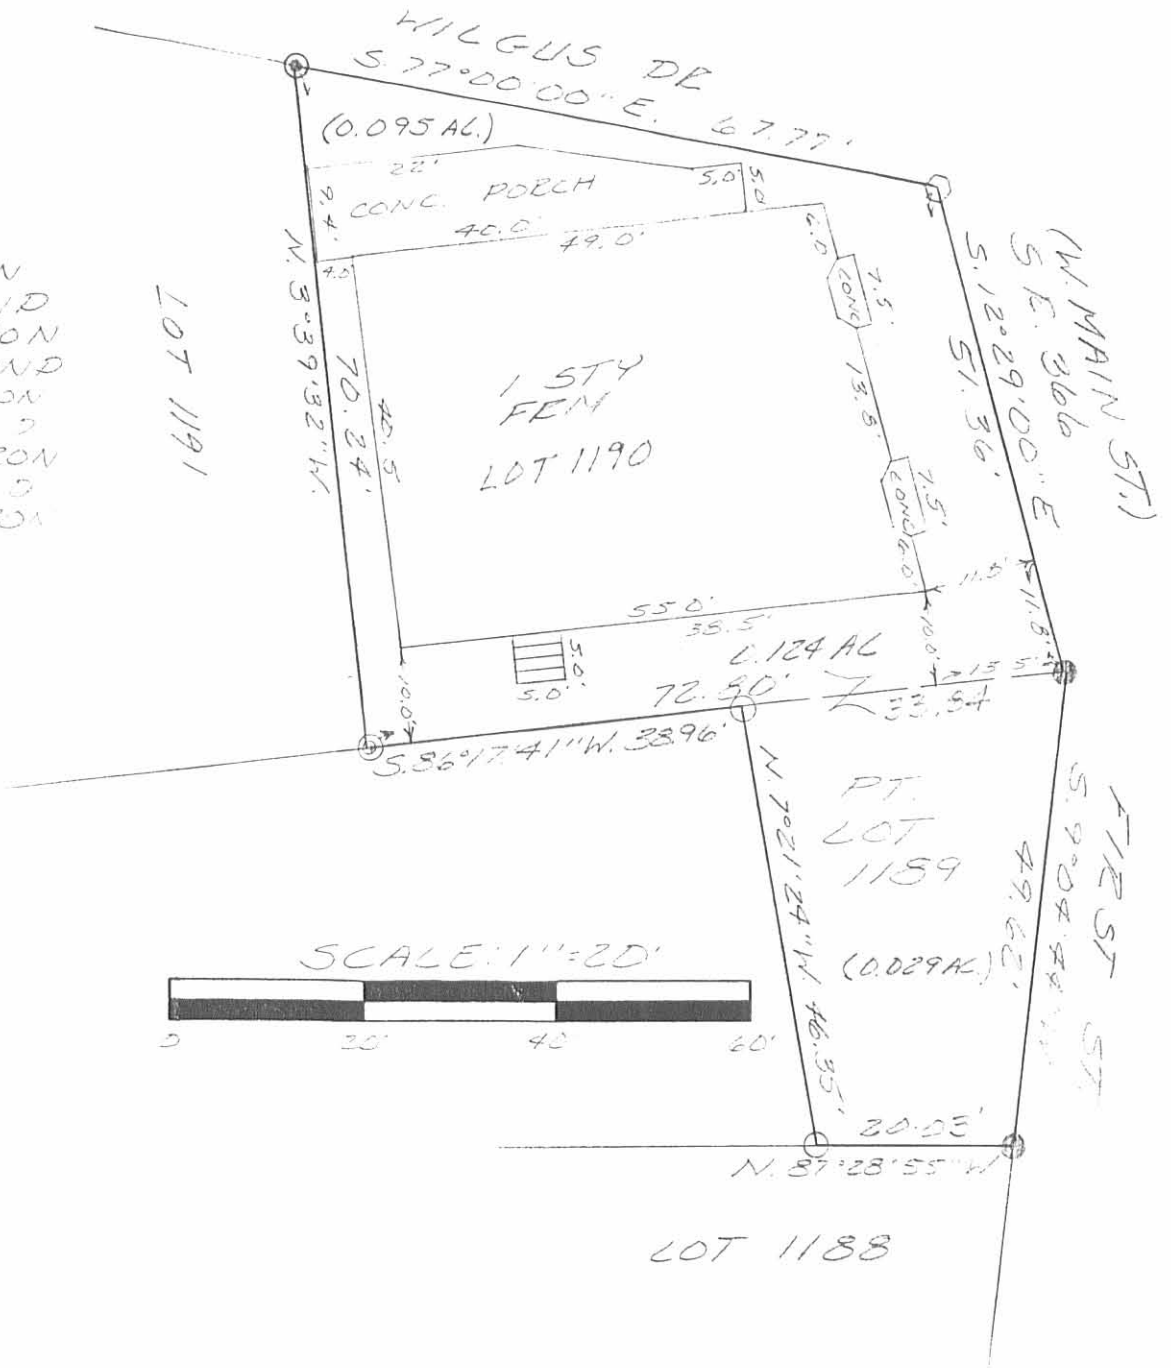

SURVEY OF LOT 1190 AND PT. LOT 1189
OF COON ALLOT. NO. 1 IN THE
VILLAGE OF RUSSELLS PT. WASHINGTON
TOWNSHIP, LOGAN COUNTY, OHIO
FOR RALPH LEE
ON NOVEMBER 3, 1955




INDEXED ON MAP
3632 IP

Leslie H. Geeslin
LESLIE H. GEESLIN
BUSBY PLVANIA, OH
(513) 463-2799

LEGEND:

- ⊙ = 1/4 INCH IRON PIPE FOUND
- ⊙ = 3/4 INCH IRON PIPE FOUND
- ⊙ = 3/4 INCH IRON BAR FOUND
- ⊙ = 5/8 INCH IRON BAR FOUND
- = 5/8 INCH IRON BAR SET

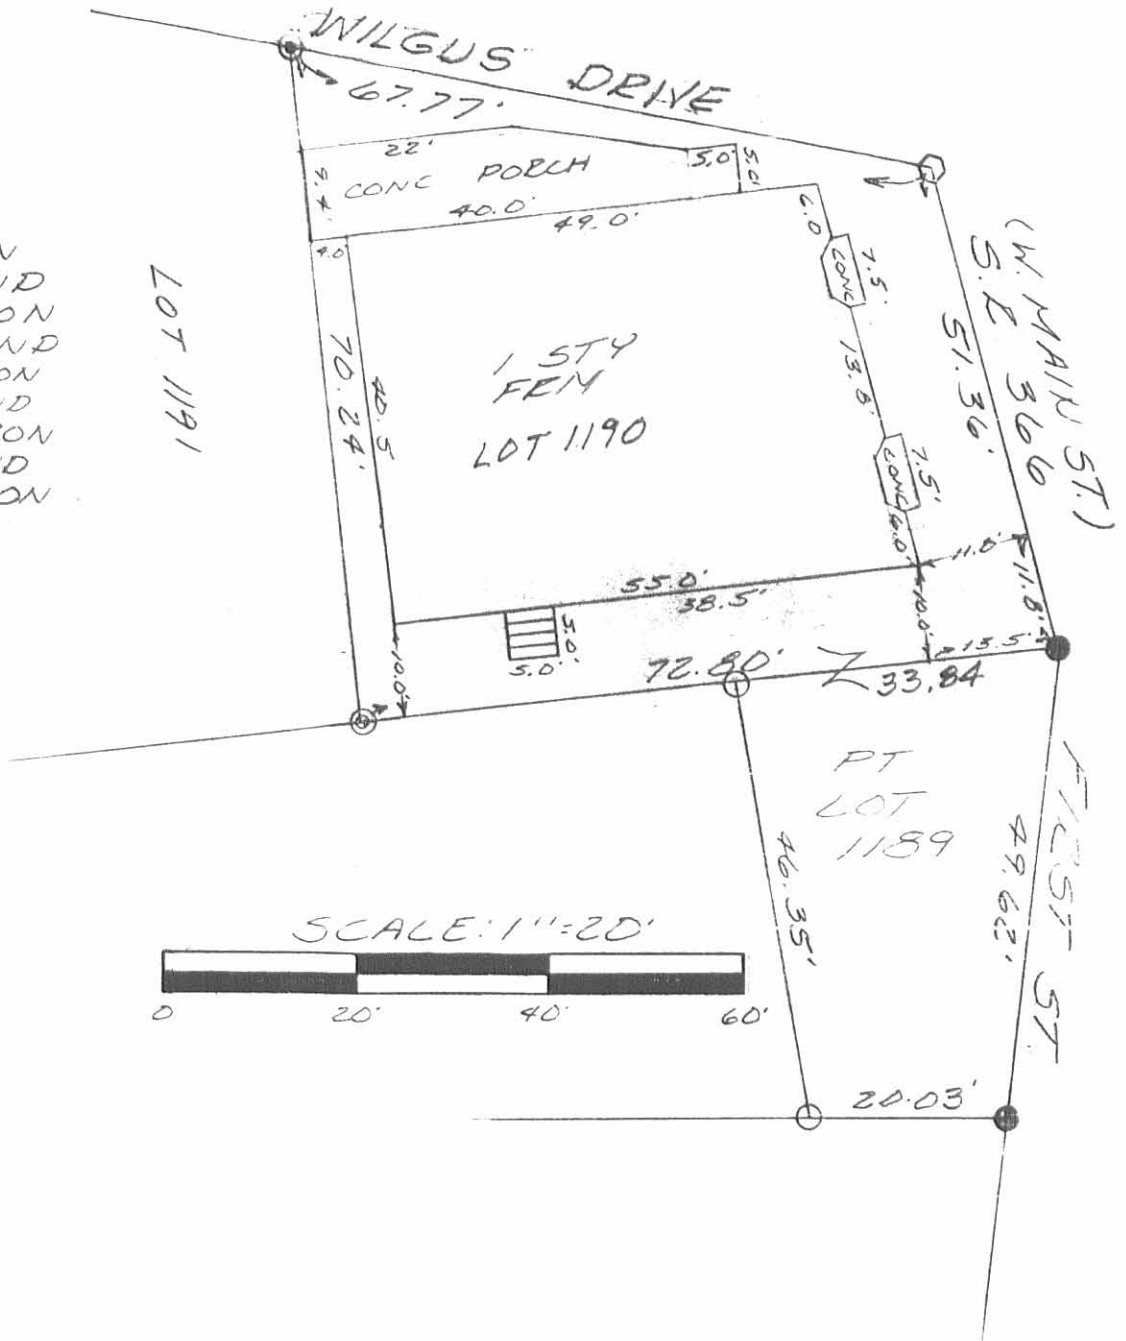

SURVEY OF LOT 1190 AND PT LOT 1189
 OF COON ALLOT. N#1 IN THE
 VILLAGE OF RUSSELLS POINT, WASHINGTON
 TOWNSHIP, LOGAN COUNTY, OHIO
 FOR RALPH LEE
 ON JUNE 23, 1993



INDEXED ON MAP
 36322P

Leslie H. Geeslin
 LESLIE H. GEESLIN
 EUSHS PULVANIA, OH
 (513) 468-2793

PART LOT 1189
COON ALLOTMENT No. 1
RUSSELLS POINT, OHIO

January 5, 1963

The following described real estate situated in the Village of Russells Point, Washington Township, Logan County, Ohio and being part of Lot 1189 and more particularly described as follows:

Beginning at an iron pipe at the northeast corner of Lot 1189 of Coon Allotment No. 1 as shown in Logan County Recorder's Plat Book 4, Volume D, page 59; thence with the north line of said lot S. 85°40' W. 34.00 feet to an iron bar; thence S. 8°07' E. 46.25 feet to an iron bar in the south line of said Lot 1189; thence with said south line S. 88°08' E. 20.00 feet to an iron pipe at the southeast corner of said lot; thence with the east line of said lot and the west line of First Street N. 8°32' E. 49.75 feet to the place of beginning.

3632

3D
INDEXED ON MAP



PART LOT 1189
 COON ALLOTMENT No. 1
 RUSSELLS POINT, OHIO
 SCALE 1"=20'

3632 BP

INDEXED ON MAP

Dan L. Dodson

Dan L. Dodson
 Registered Surveyor 4270
 Bellefontaine, Ohio

REFERENCE:
 Coon Allotment No. 1
 Plat Bk. 4, Vol. D, Pg. 59
 ○ = Iron pipe found
 ■ = 5/8" Sq. Bar set

ON PLAT BOOK
 3-30-64
 D.E.G.